
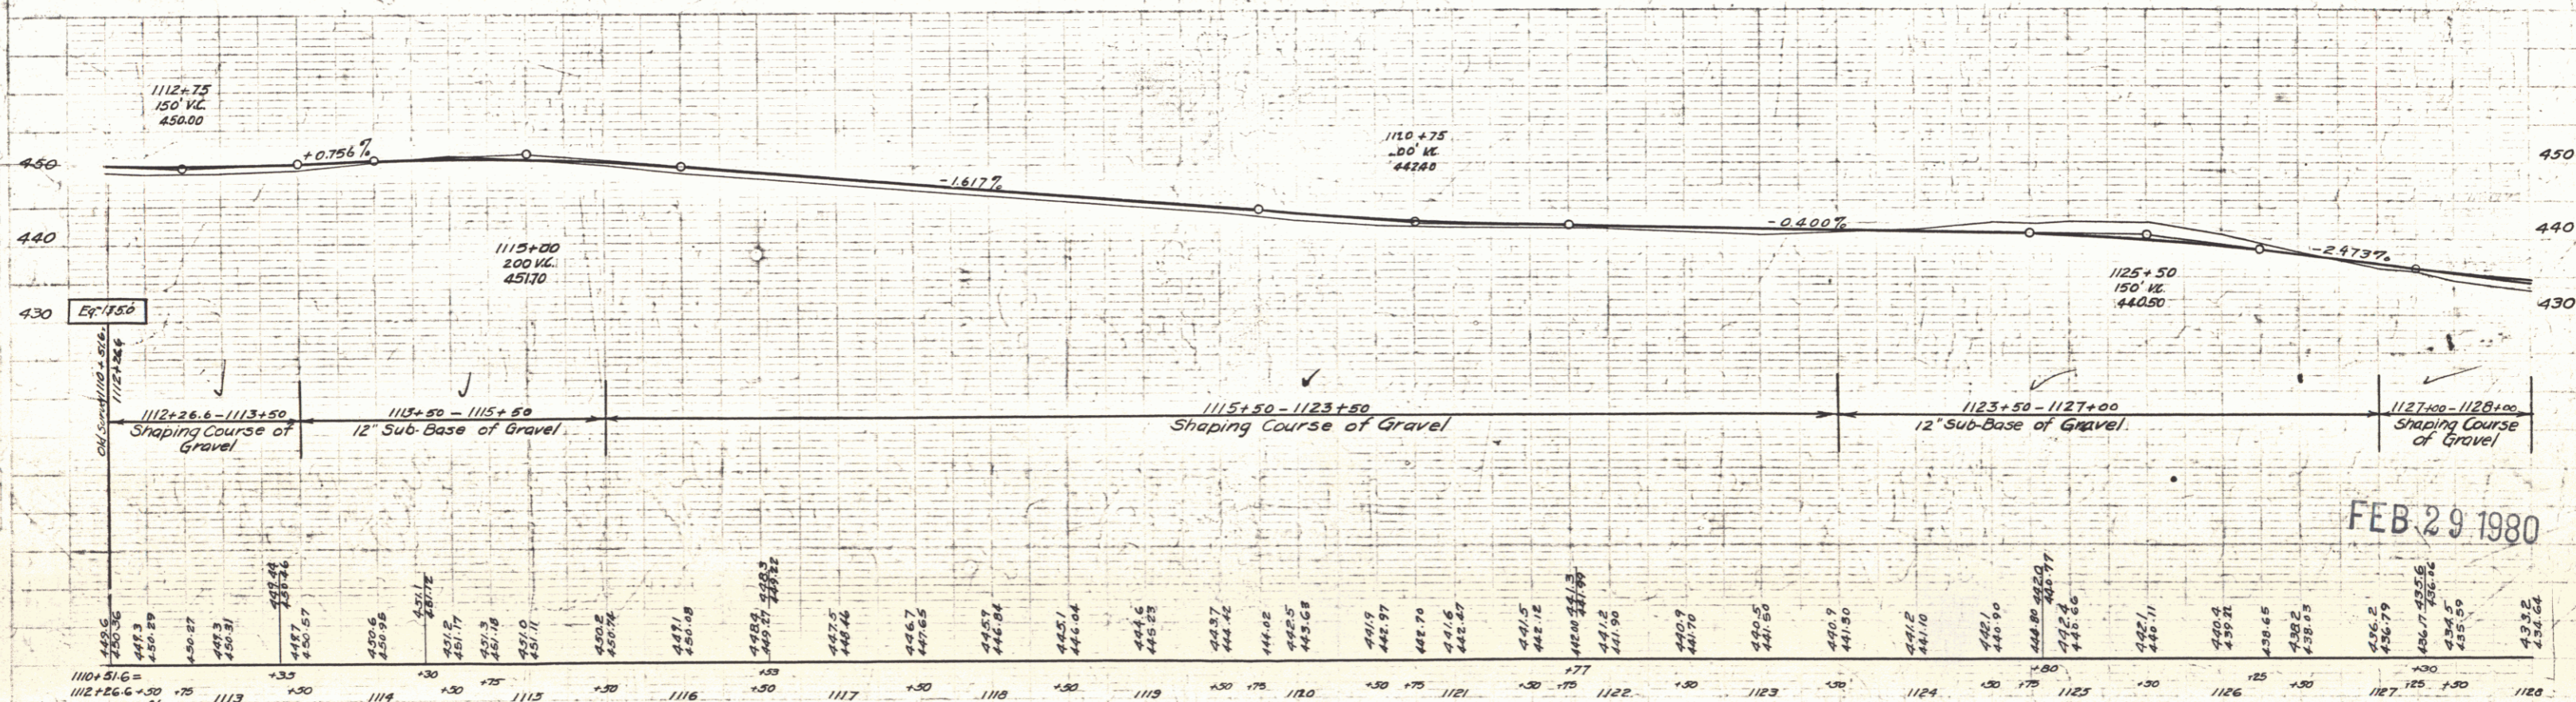


Parcel	Kind of Instrument	Date of Instrument	Grantor	Grantee	Recorded	Remarks
A-B	G.C.D.	8-31-35	Wilbur Norman	St of H	21 334	11-3-35
A'-B'	"	8-15-35	C.H. & N.E. Abel	"	21 377	9-28-35

LD	RD	STATE	FILE NO.	YEAR	SHEET NO.	TOTAL SHEETS
3	VT		113-C	1936	6	69

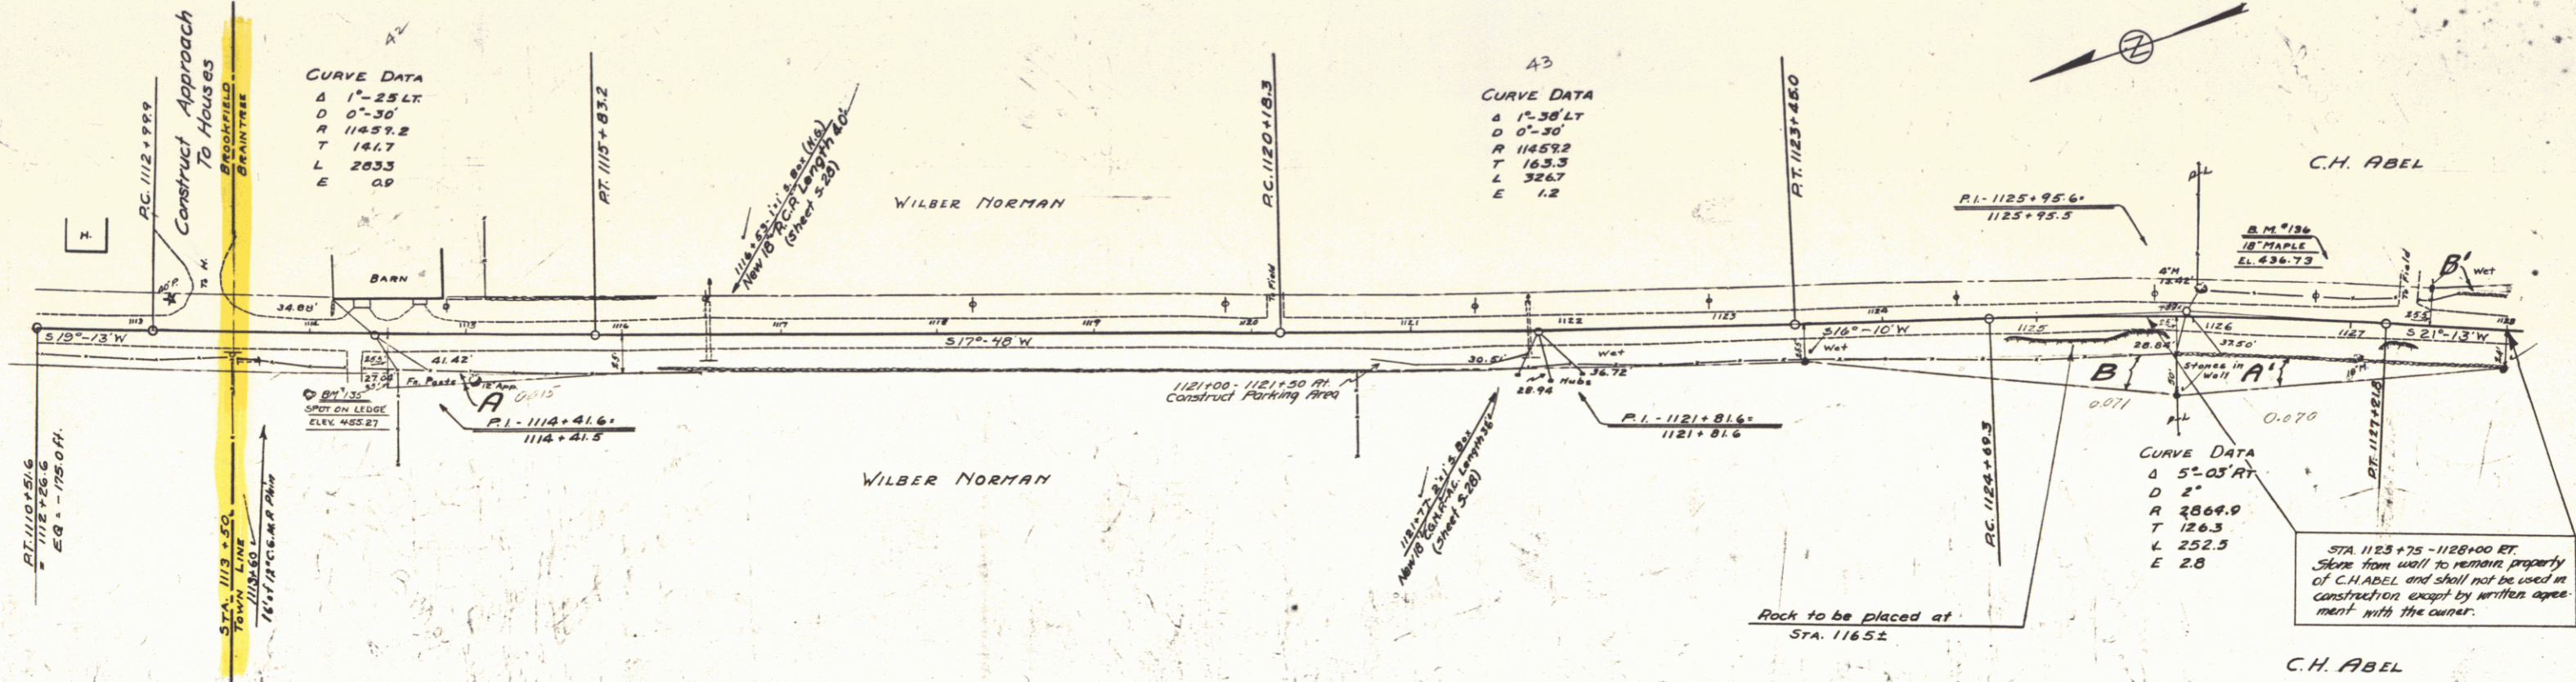

Station	Elevation	Station	Elevation	Station	Elevation
1101+51.6	435.6	1111	445.1	1121	441.6
1102+26.6	435.29	1112	445.7	1122	441.70
1103	435.31	1113	446.7	1123	441.70
1104	435.31	1114	447.5	1124	441.70
1105	435.31	1115	448.4	1125	441.70
1106	435.31	1116	448.4	1126	441.70
1107	435.31	1117	448.4	1127	441.70
1108	435.31	1118	448.4	1128	441.70
1109	435.31	1119	448.4		
1110	435.31	1120	448.4		
1111	435.31	1121	448.4		
1112	435.31	1122	448.4		
1113	435.31	1123	448.4		
1114	435.31	1124	448.4		
1115	435.31	1125	448.4		
1116	435.31	1126	448.4		
1117	435.31	1127	448.4		
1118	435.31	1128	448.4		
1119	435.31				
1120	435.31				
1121	435.31				
1122	435.31				
1123	435.31				
1124	435.31				
1125	435.31				
1126	435.31				
1127	435.31				
1128	435.31				

FEB 29 1980

SERIES F NO 113C  
 SHEET 6 OF 69

6