


Parcel	Kind of Instrument	Date of Instrument	Grantor	Grantee	Recorded	Remarks
A.D.C. (Cutter)	R.C.D.	8-13-35	Wm. C. Hoyt	St. of H.	21	Notes 9-28-35 Cal. Sta. 115940

STA 1165+27-1165+62 - Concrete Bridge
 Span - 11 ft Width - 22 ft
 Clearance - 11 ft Overall Length - 15 ft
 Constructed in 1921 - Series B180-App 460
 Good Condition Retain and extend 235 ft
 Right with 11 ft R.C. Box - Sheet 17 (Details of 11 ft R.C. Box) W.S. @ OUTLET

NOTE
 Excess cut to be used on road approach.

FED. ROAD STATE CALIF. FEDERAL HIGHWAY DIST. NO. 113-C 1930 11 69

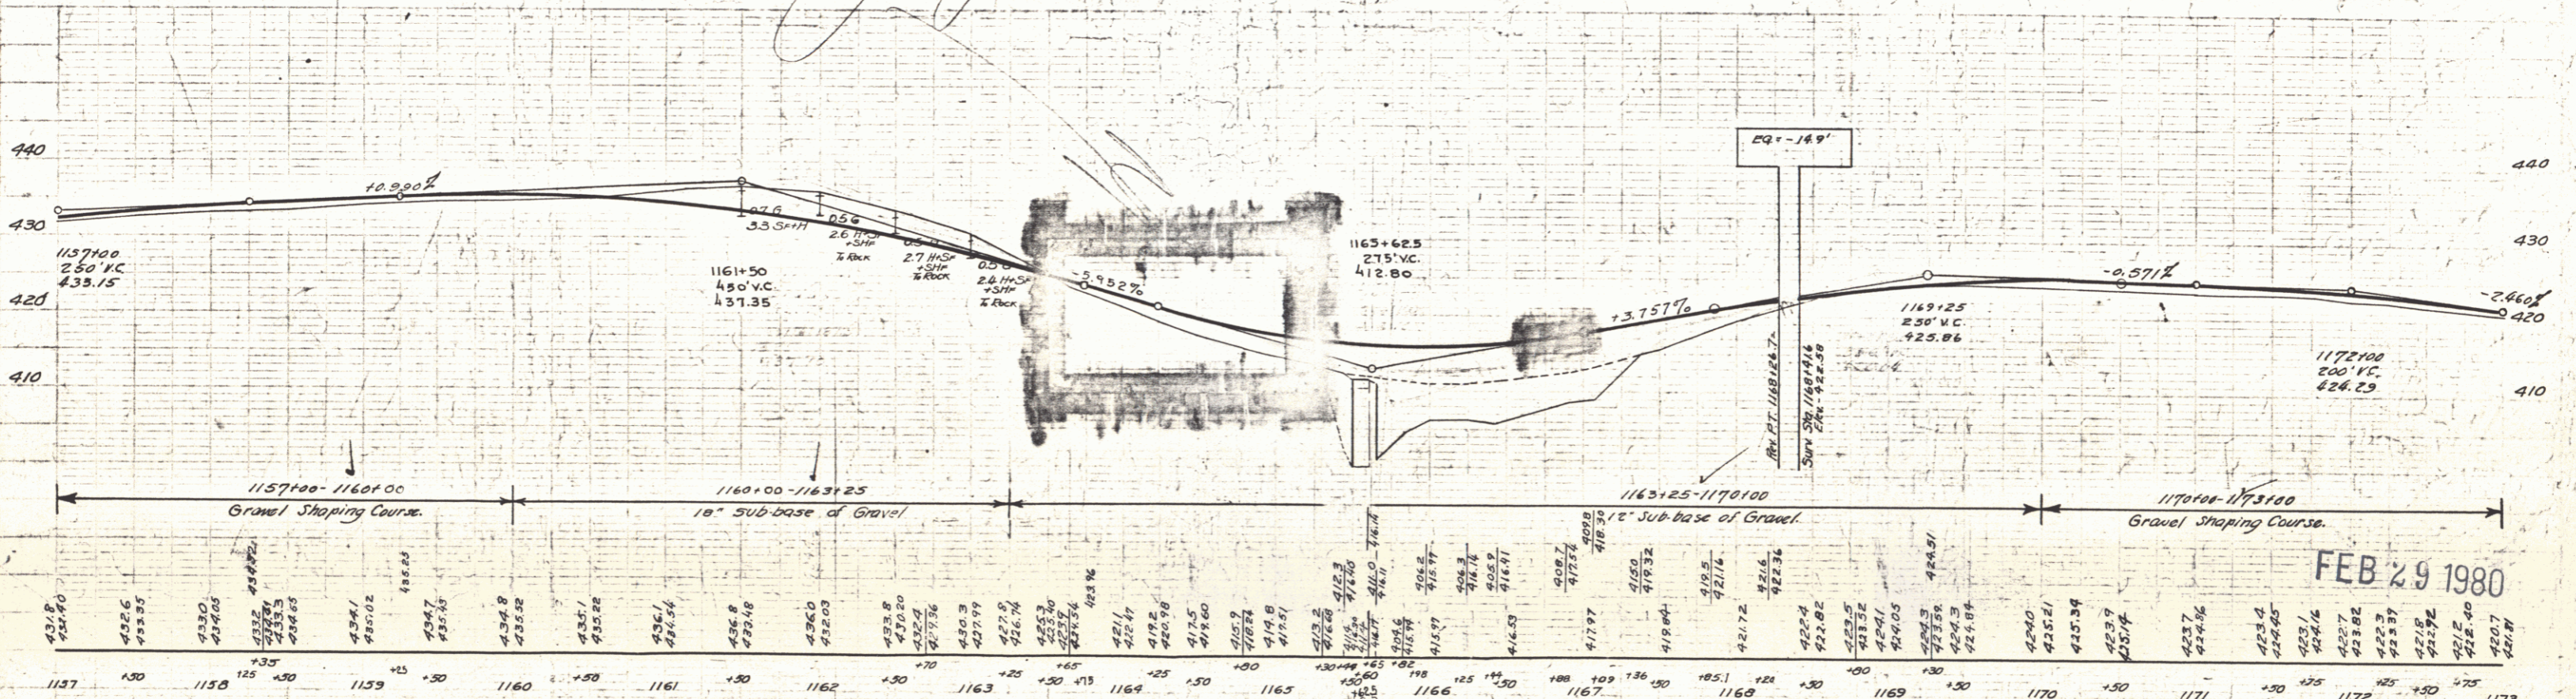

431.8	432.0	432.2	440.0		
1157	158	159	160	161	162	163	164	165	166	167	168	169	170	171	172	173	174	175	176	177	178	179	180	181	182	183	184	185	186	187	188	189	190	191	192	193	194	195	196	197	198	199	200

B.M. 139 Spike in Root 12" Elm 13 ft ft Sta. 1160+40 Elev. 435.63
 B.M. 140 Point Spot on Cont. Gas P'dn 26 ft ft Sta. 1168+80 Elev. 425.75

FEB 29 1980

SERIES F No 113-C
 SHEET 11 OF 69

9