
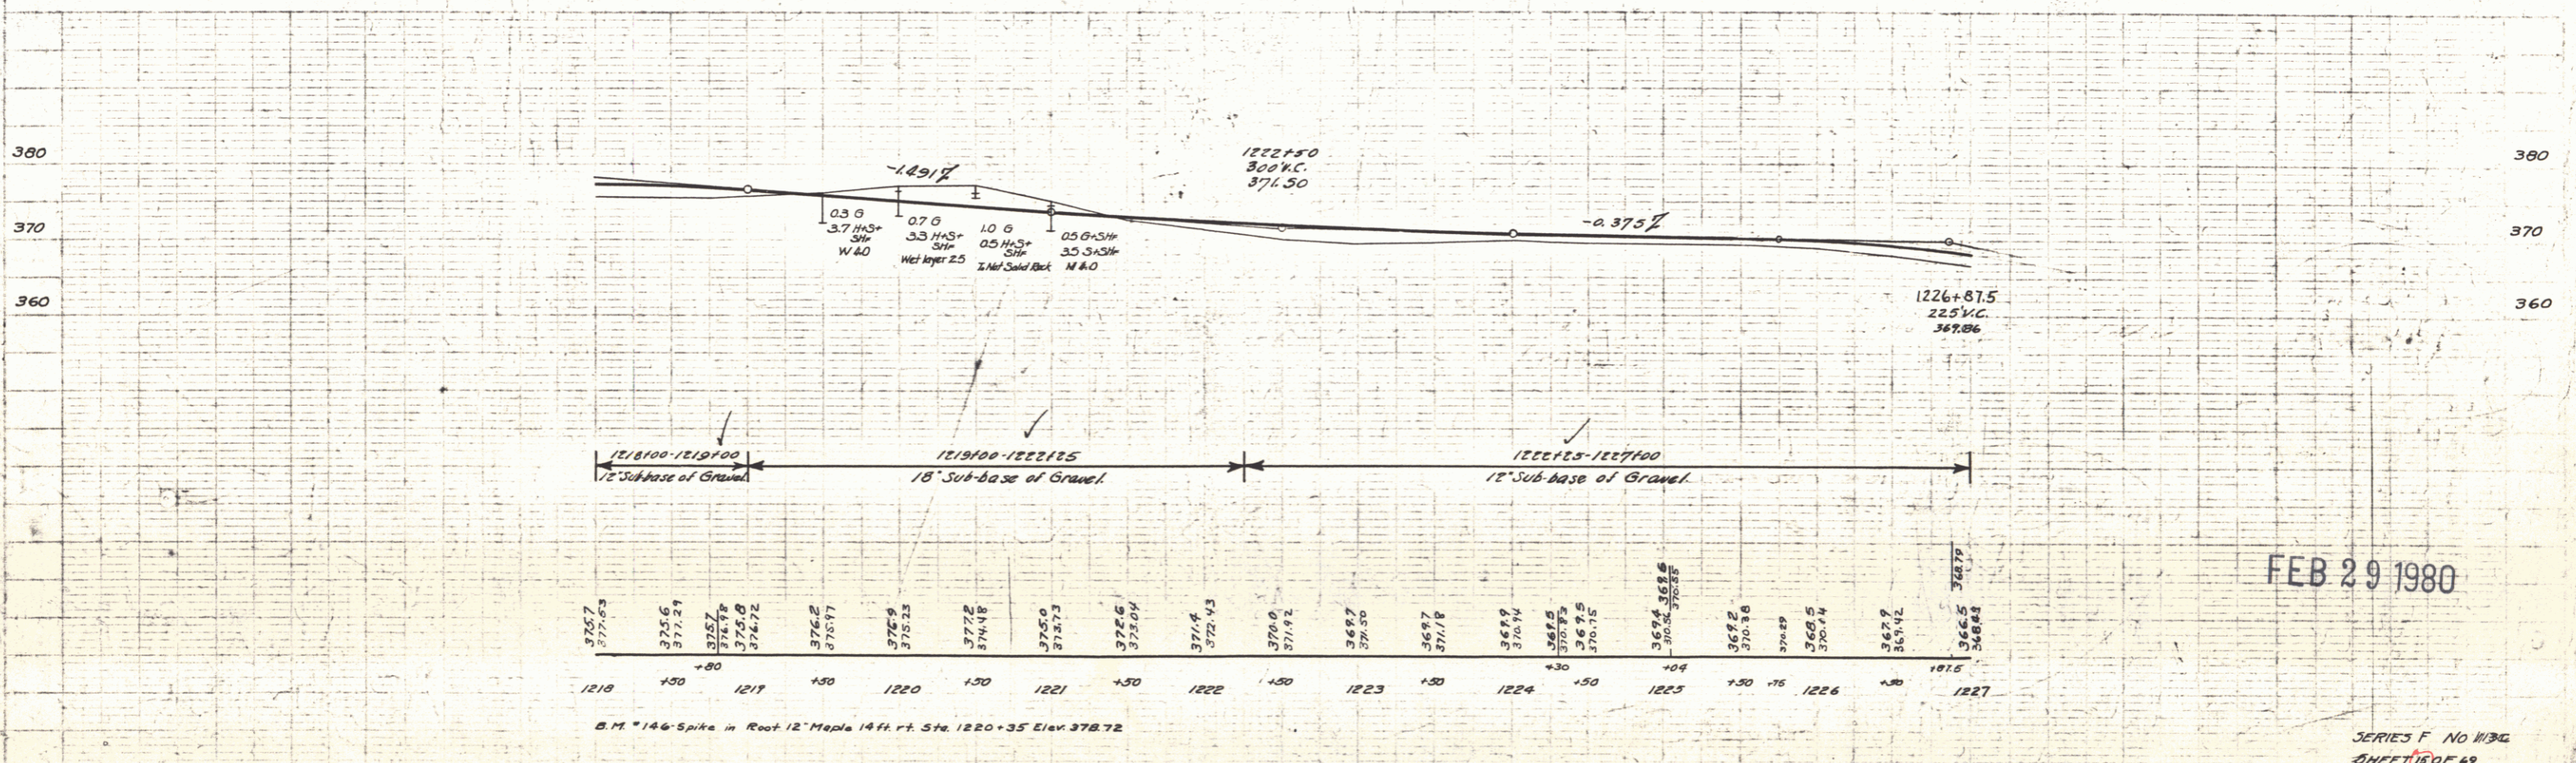


Parcel	Kind of Data of Instrument	Grantor	Grantee	Recorded	Remarks
B, D & E	G.C.D.	8-15-35	A.F. Bassett	Staff: 54 8-10 2-10	Bank Page Date

FED. ROAD STATE	FED. AID FISCAL SHEET	TOTAL
NO. 115-C	YEAR 15	SHEET 69

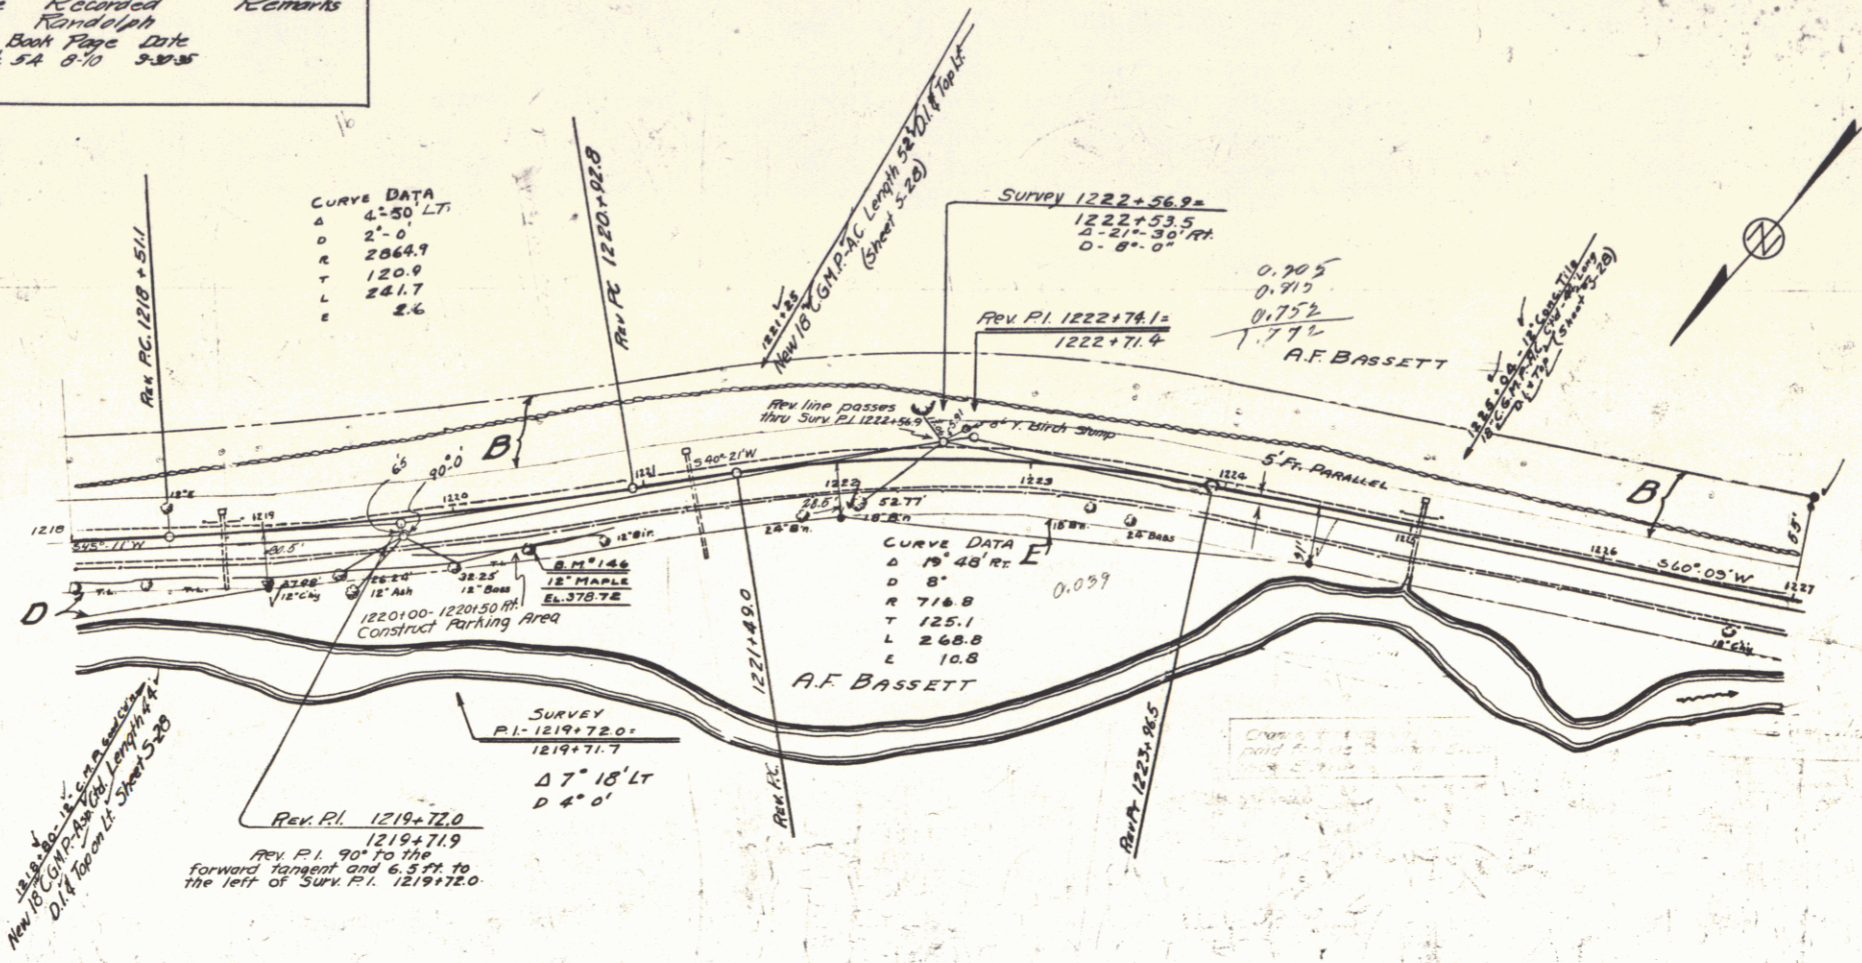

FEB 29 1980

SERIES F NO 1136
SHEET 69 OF 69

13