
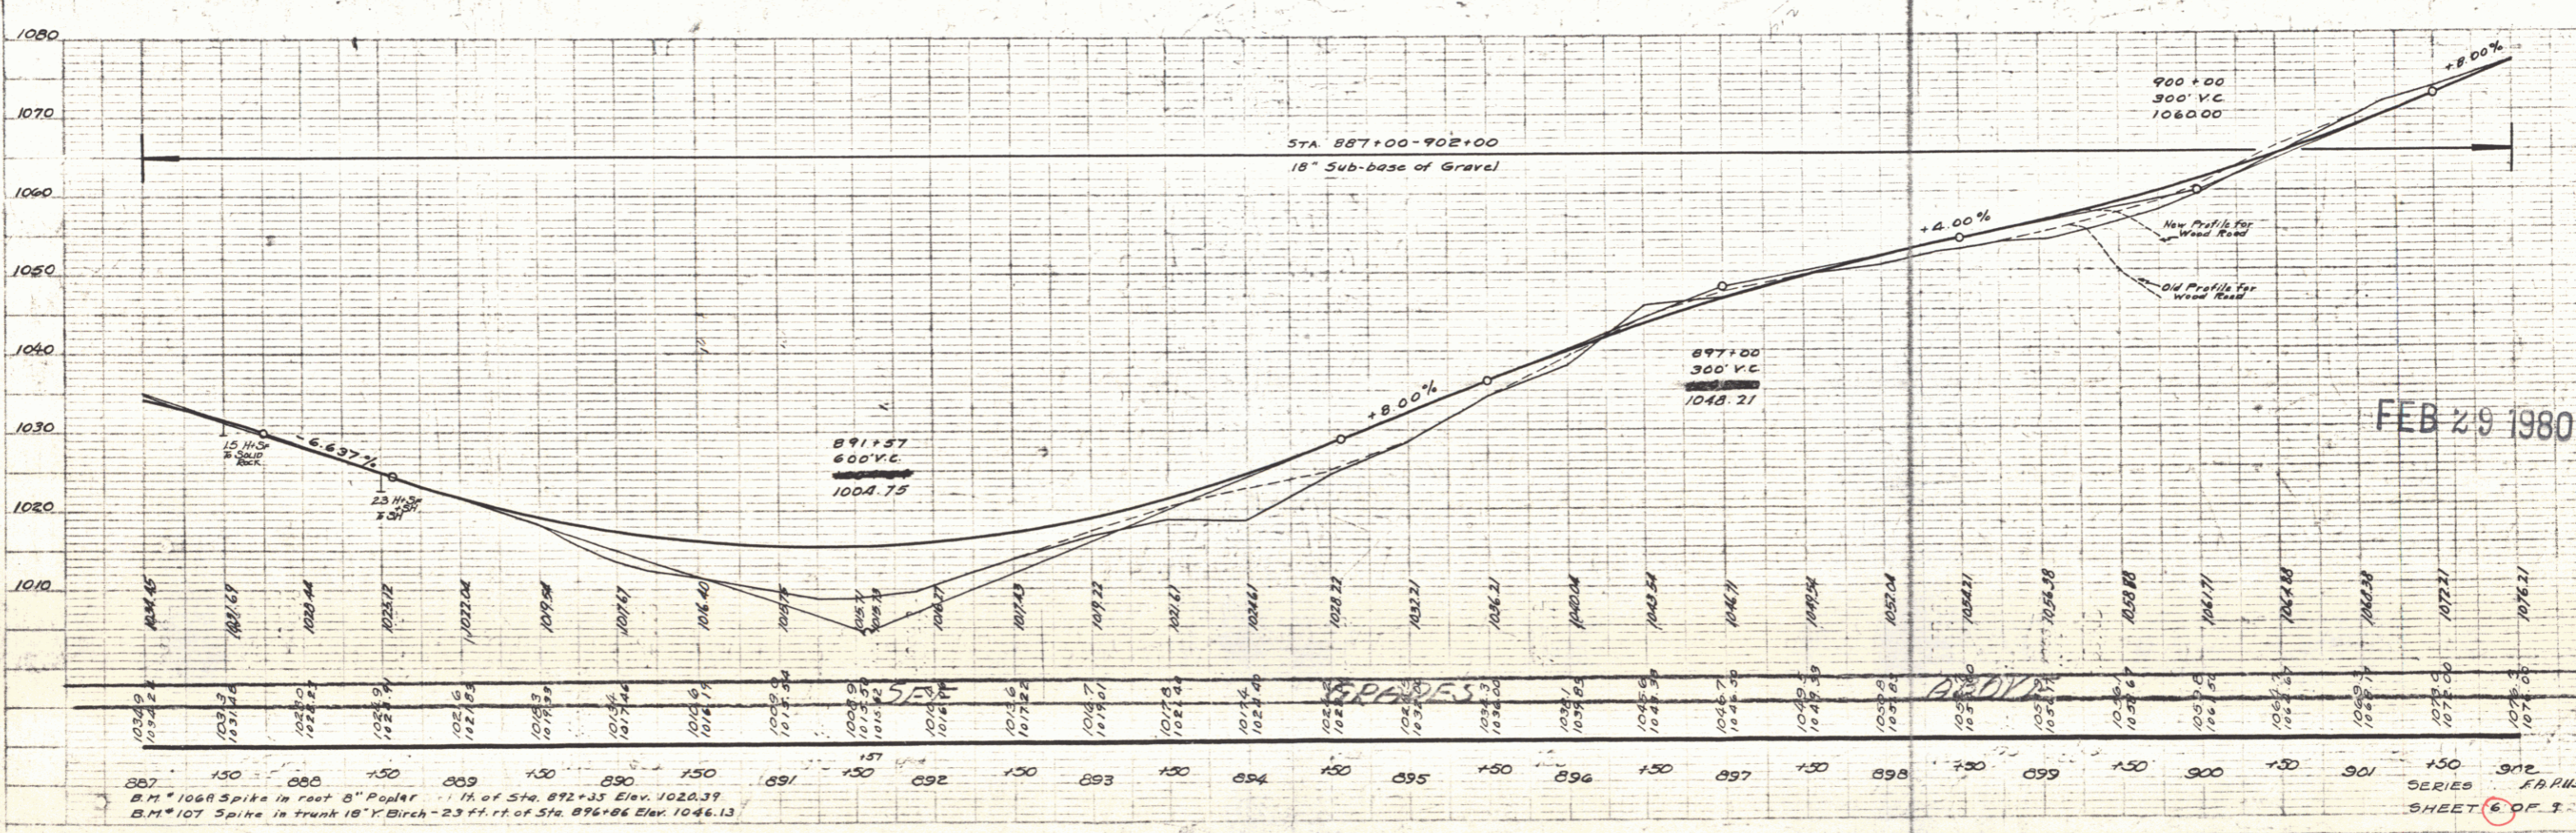


Parcel	Kind of Instrument	Date of Instrument	Grantor	Grantee	Recorded Book Page	Date	Remarks
C	O.C.D.	7-31-33	Henry B. Baker	Stoff	36 306-7	8-3-33	
C, D & E	"	1-6-34	T.W. Kirkpatrick	"	27 928-9	1-3-34	
A, B, C & F	"	7-31-33	R.W. Gale	"	26 388-9	8-3-34	Ch. Sta. 894 & 895

FAP 1130			
WOOD GUIDED RAIL			
STA.	STA.	RT.	LT.
890+36	897+00		144
890+80	894+74	384'	
897+63	899+25	160'	
899+60	903+00	240'	

FAP 1130			
WOOD GUIDEPOLTS			
STA.	RT.	LT.	
899+05			1

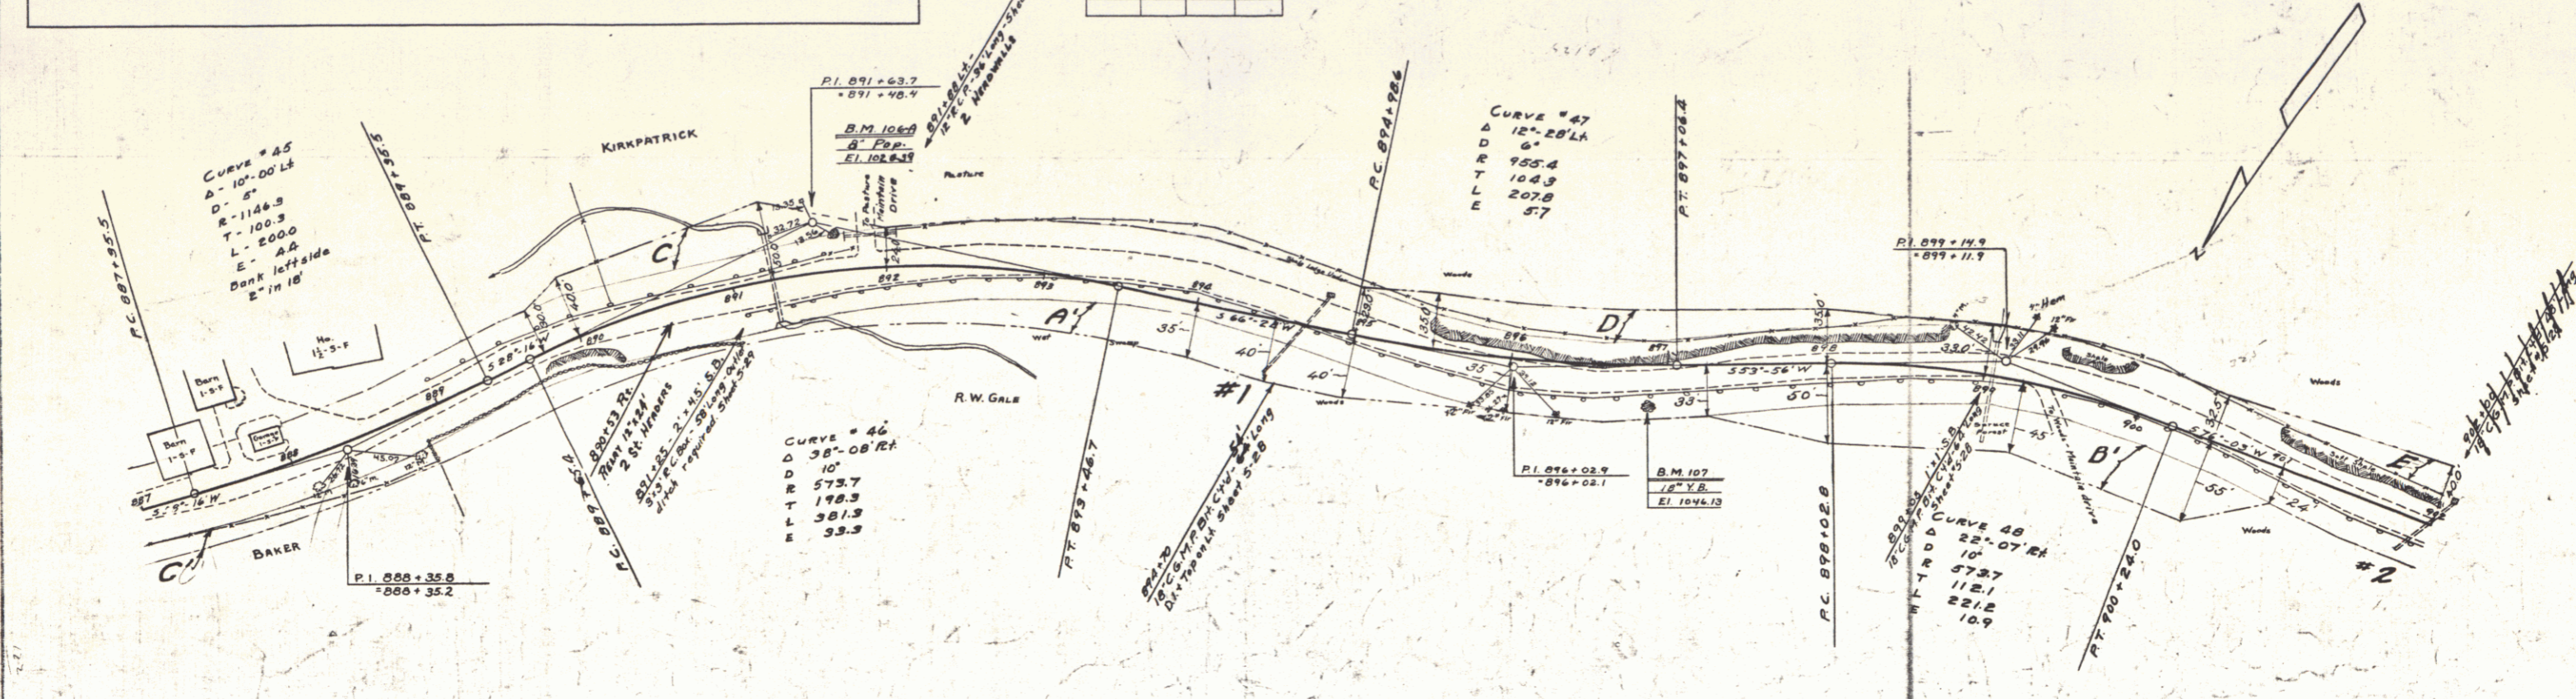

PLANNED
CONSTRUCTION
DATE
BY
CHECKED
DATE
BY

PROJECT
NO.
DATE
BY
CHECKED
DATE
BY

FEB 29 1980

B.M. 1068 Spike in root 8" Poplar 1 ft. of Sta. 892+35 Elev. 1020.39
B.M. 107 Spike in trunk 18" Birch - 23 ft. of Sta. 896+86 Elev. 1046.13

SHEET 6 OF 9