
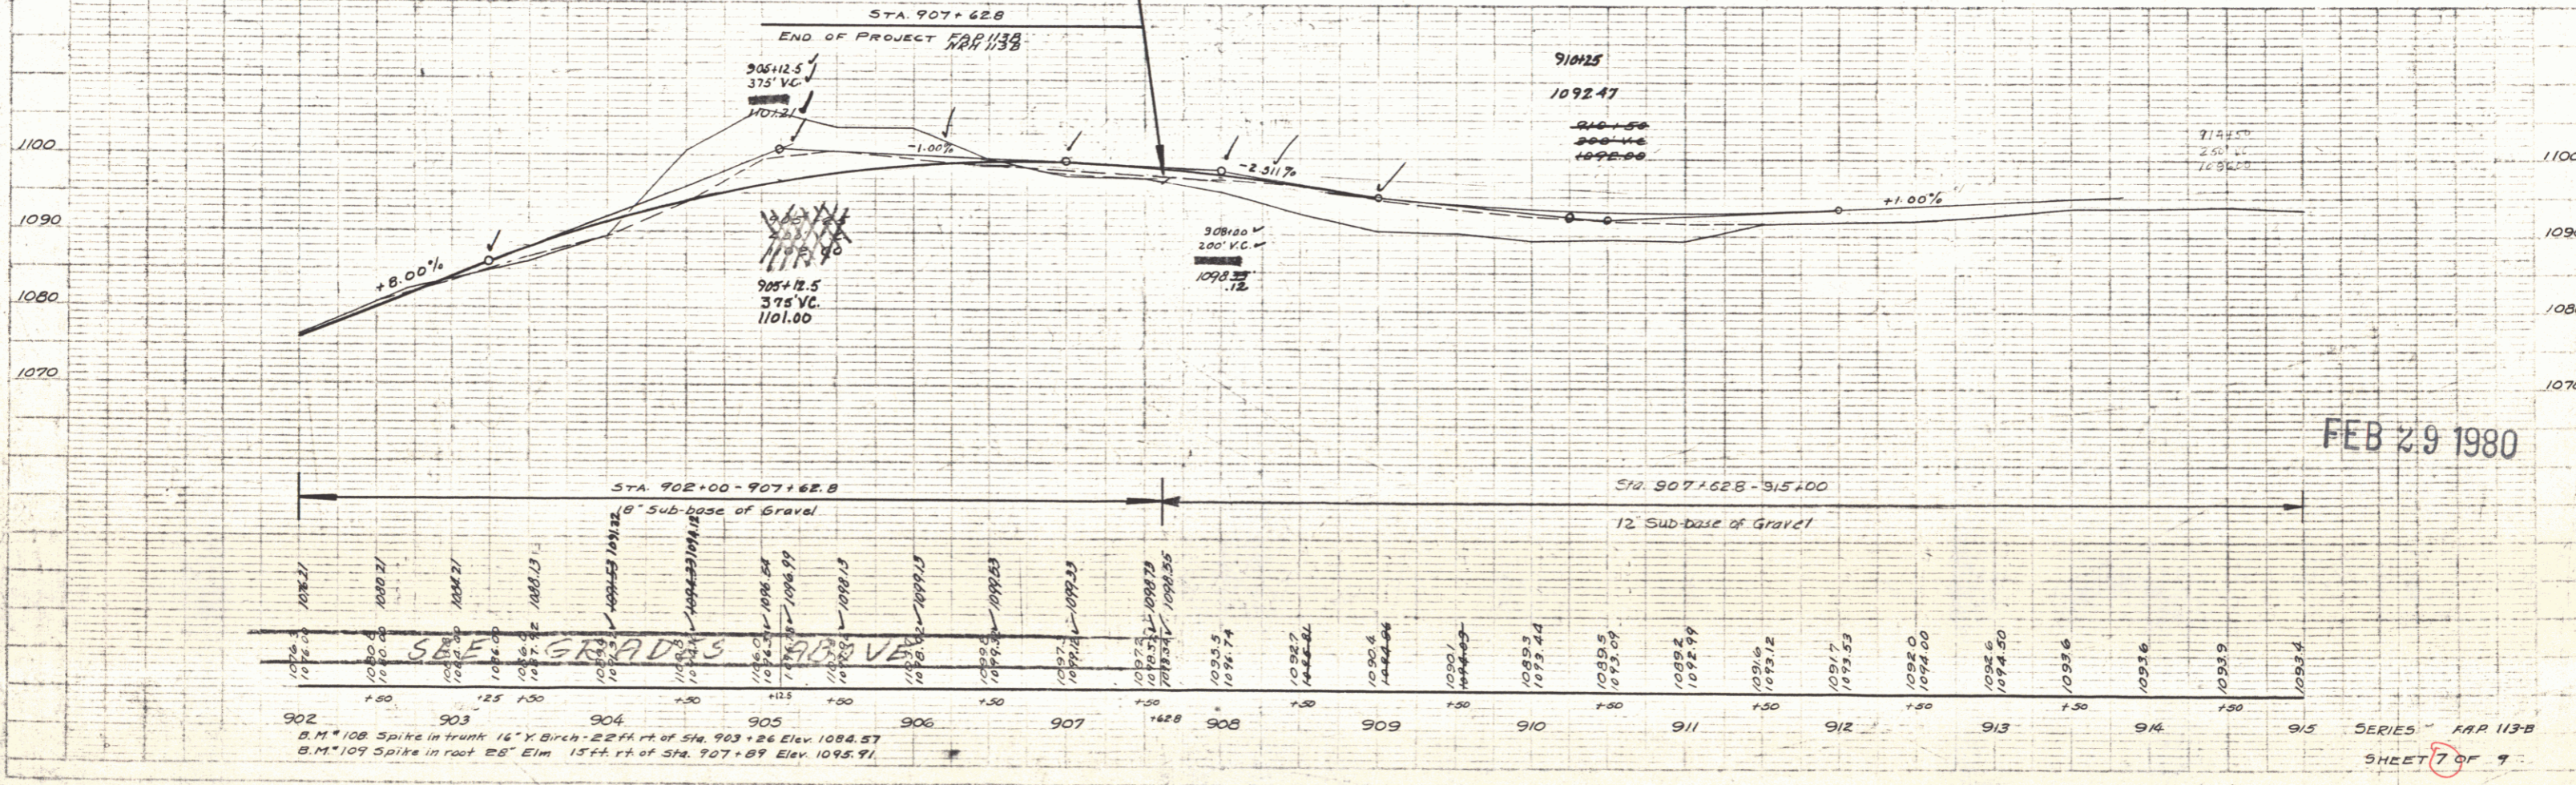


FAP 113B			
WOOD GUARD RAIL	STATION	STATION	LT RT
	902+00	902+68	188

FAP 113D		
WOOD GUIDE POSTS	STA	RT LT
	904+00	1

Parcel	Kind of Instrument	Date of Instrument	Grantor	Grantee	Recorded Book Page	Date	Remarks
E Cohn #3	O.C.D.	1-6-34	T.W. Kirkpatrick	Steph. H. 27	434-19	1-9-34	
		7-31-33	R.W. Gale		16	388-2	8-3-33 Cohn Site 304100

F.R.R.
113-D 1936 7 9

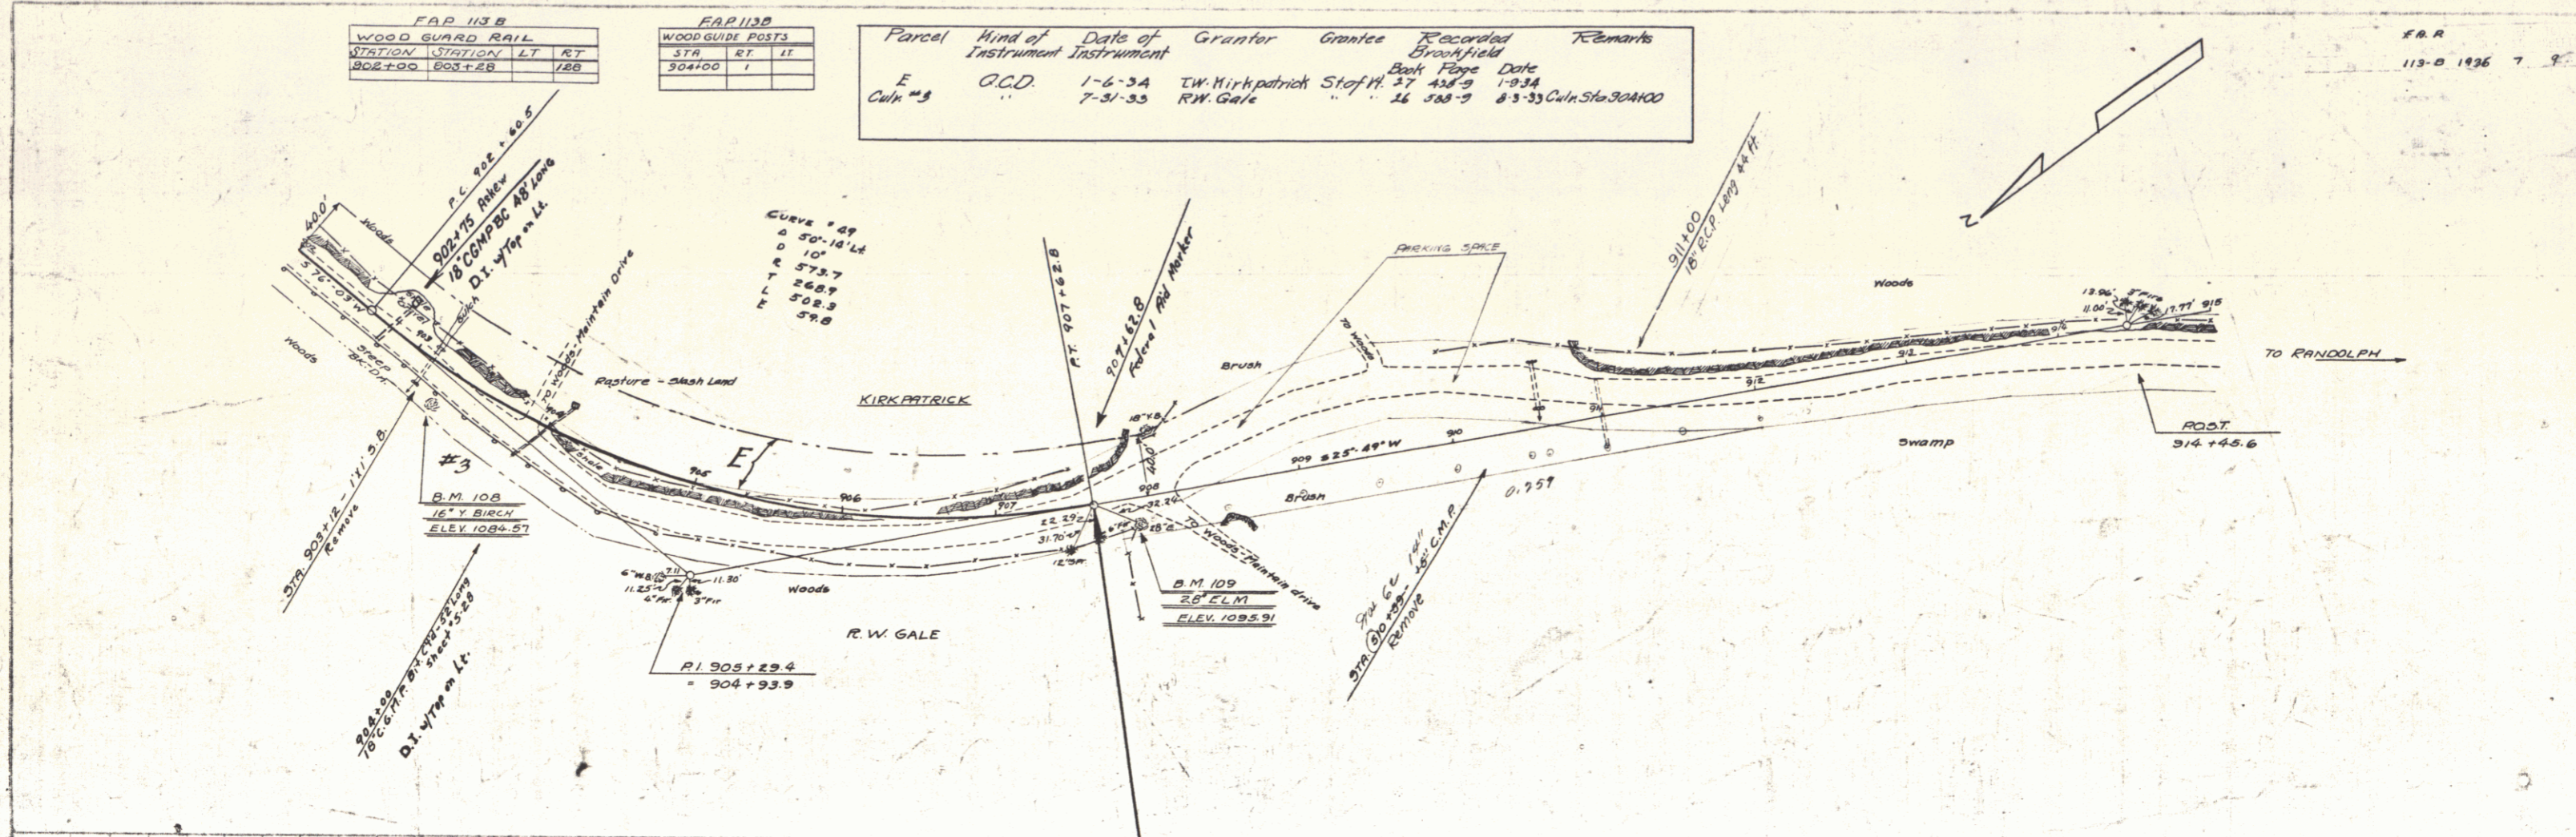

FEB 29 1980

902 B.M. #108 Spike in trunk 16" Y Birch - 22 ft ft of Sta. 903 + 26 Elev. 1088.57
 903 B.M. #109 Spike in root E8 Elm 15 ft ft of Sta. 907 + 89 Elev. 1095.91

SERIES FAP 113-B
SHEET 7 OF 9

5