
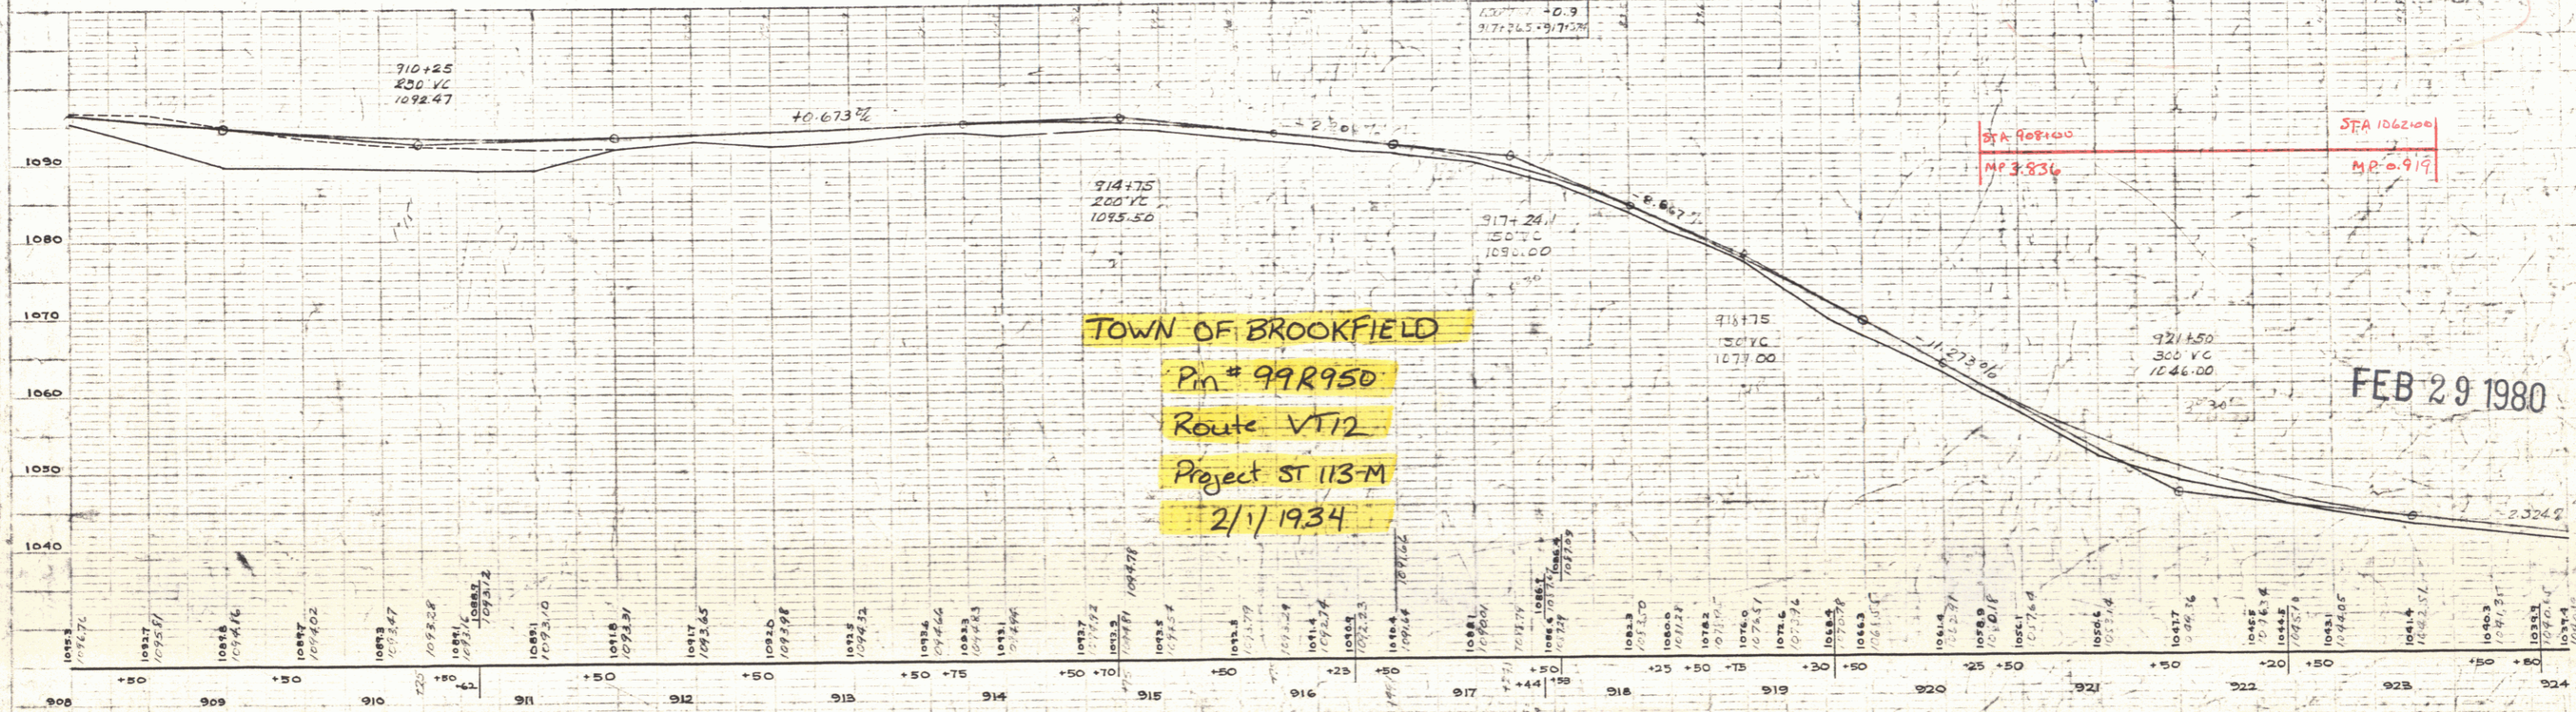


C.E. PUTNAM
 D. MAGGI
 2/74

C.E. PUTNAM
 D. MAGGI

Parcel	Kind of Instrument	Date of Grant	Grantor	Grantee	Recorded Brookfield Book Page	Date (Coh. Sta.)	Remarks
A.C. 14, 15	G.C.D.	7-15-35	C.W. Baker	Stofvt. 37	433	8-28-35	311+00 to 320+00

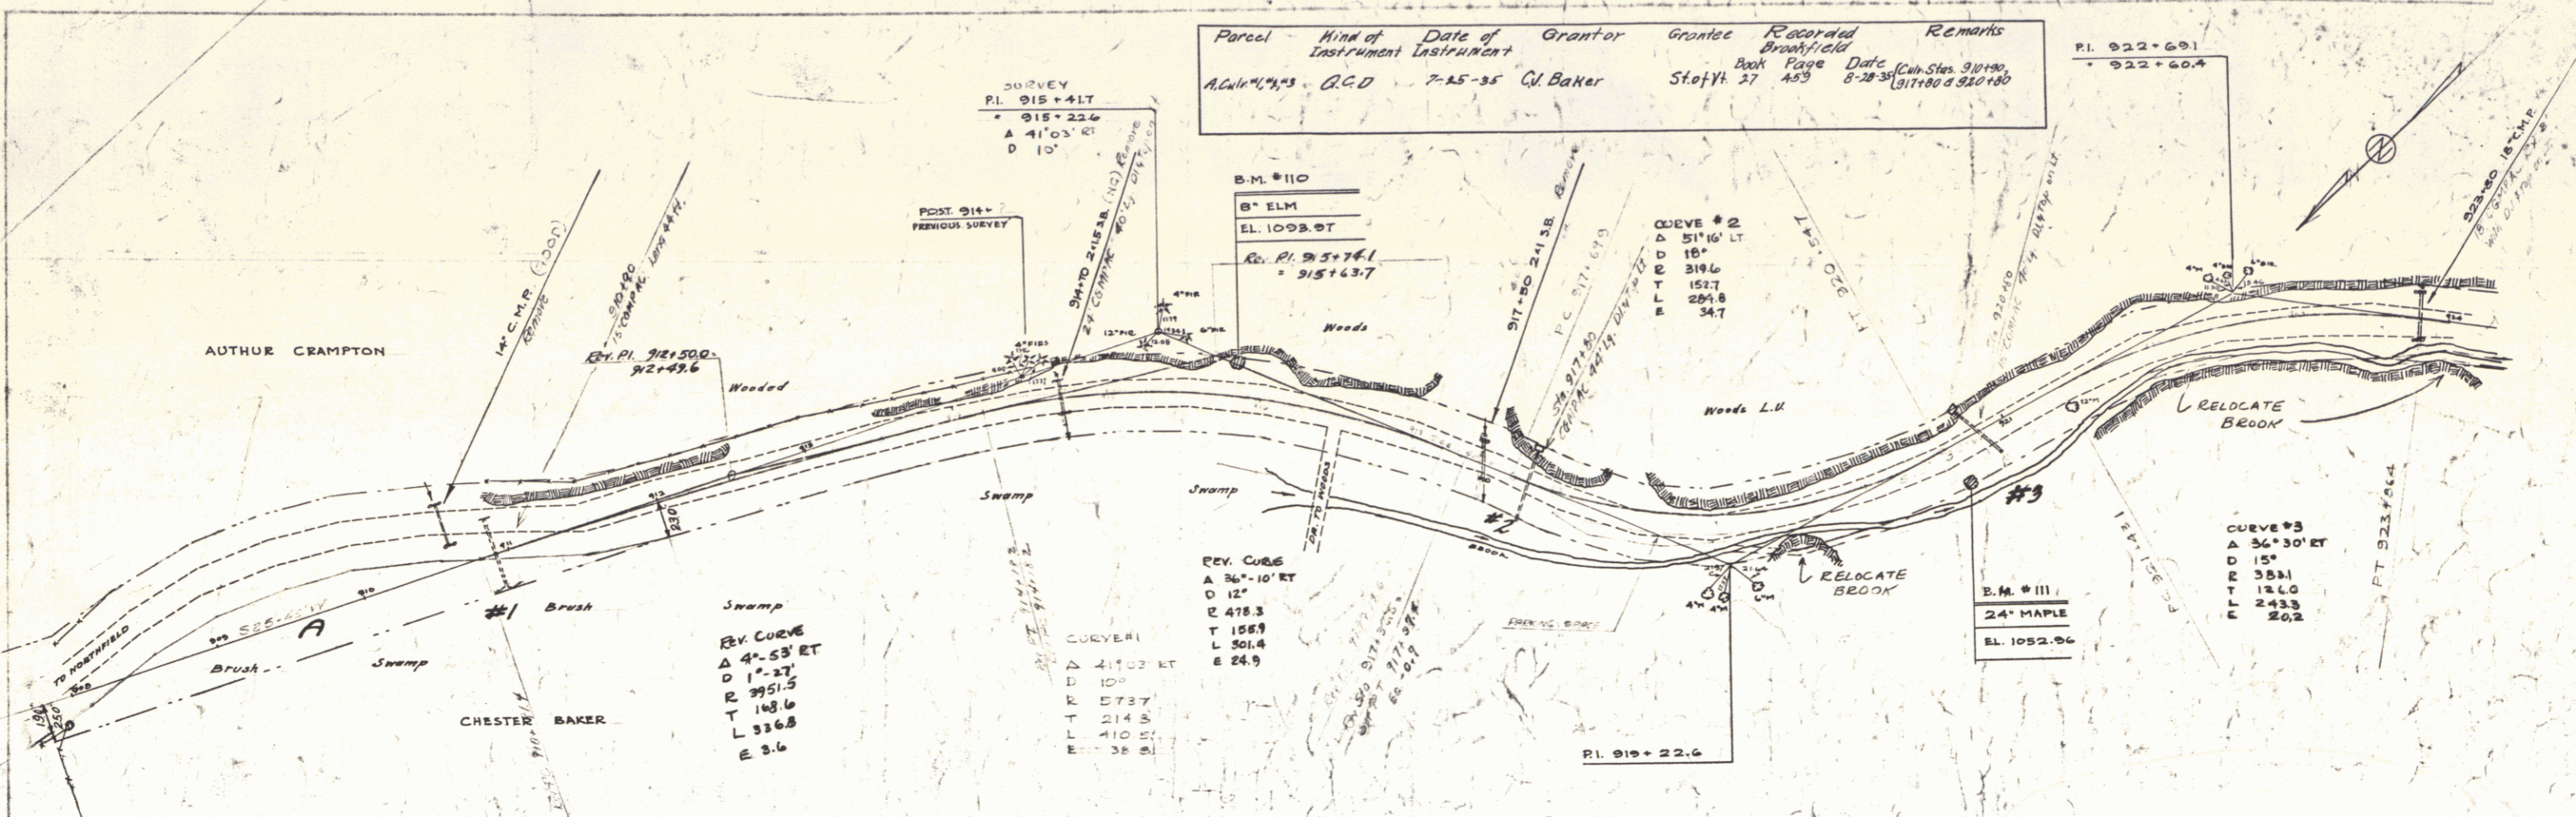

TOWN OF BROOKFIELD
 Pin # 99R950
 Route VT12
 Project ST 113-M
 2/1/1934

SFA 108100
 M.P. 3.836

FEB 29 1980

B.M. #110 SPIKE IN TRUNK B' ELM 18' LT. STA. 915+83 EL. 1093.97
 B.M. #111 ROOT 24' MAPLE 24' RT. STA. 920+61 EL. 1052.96

SHEET 1