


C. E. POTNAM
 D. MACENT
 2/78
 TRACED

C. E. POTNAM
 D. MACENT

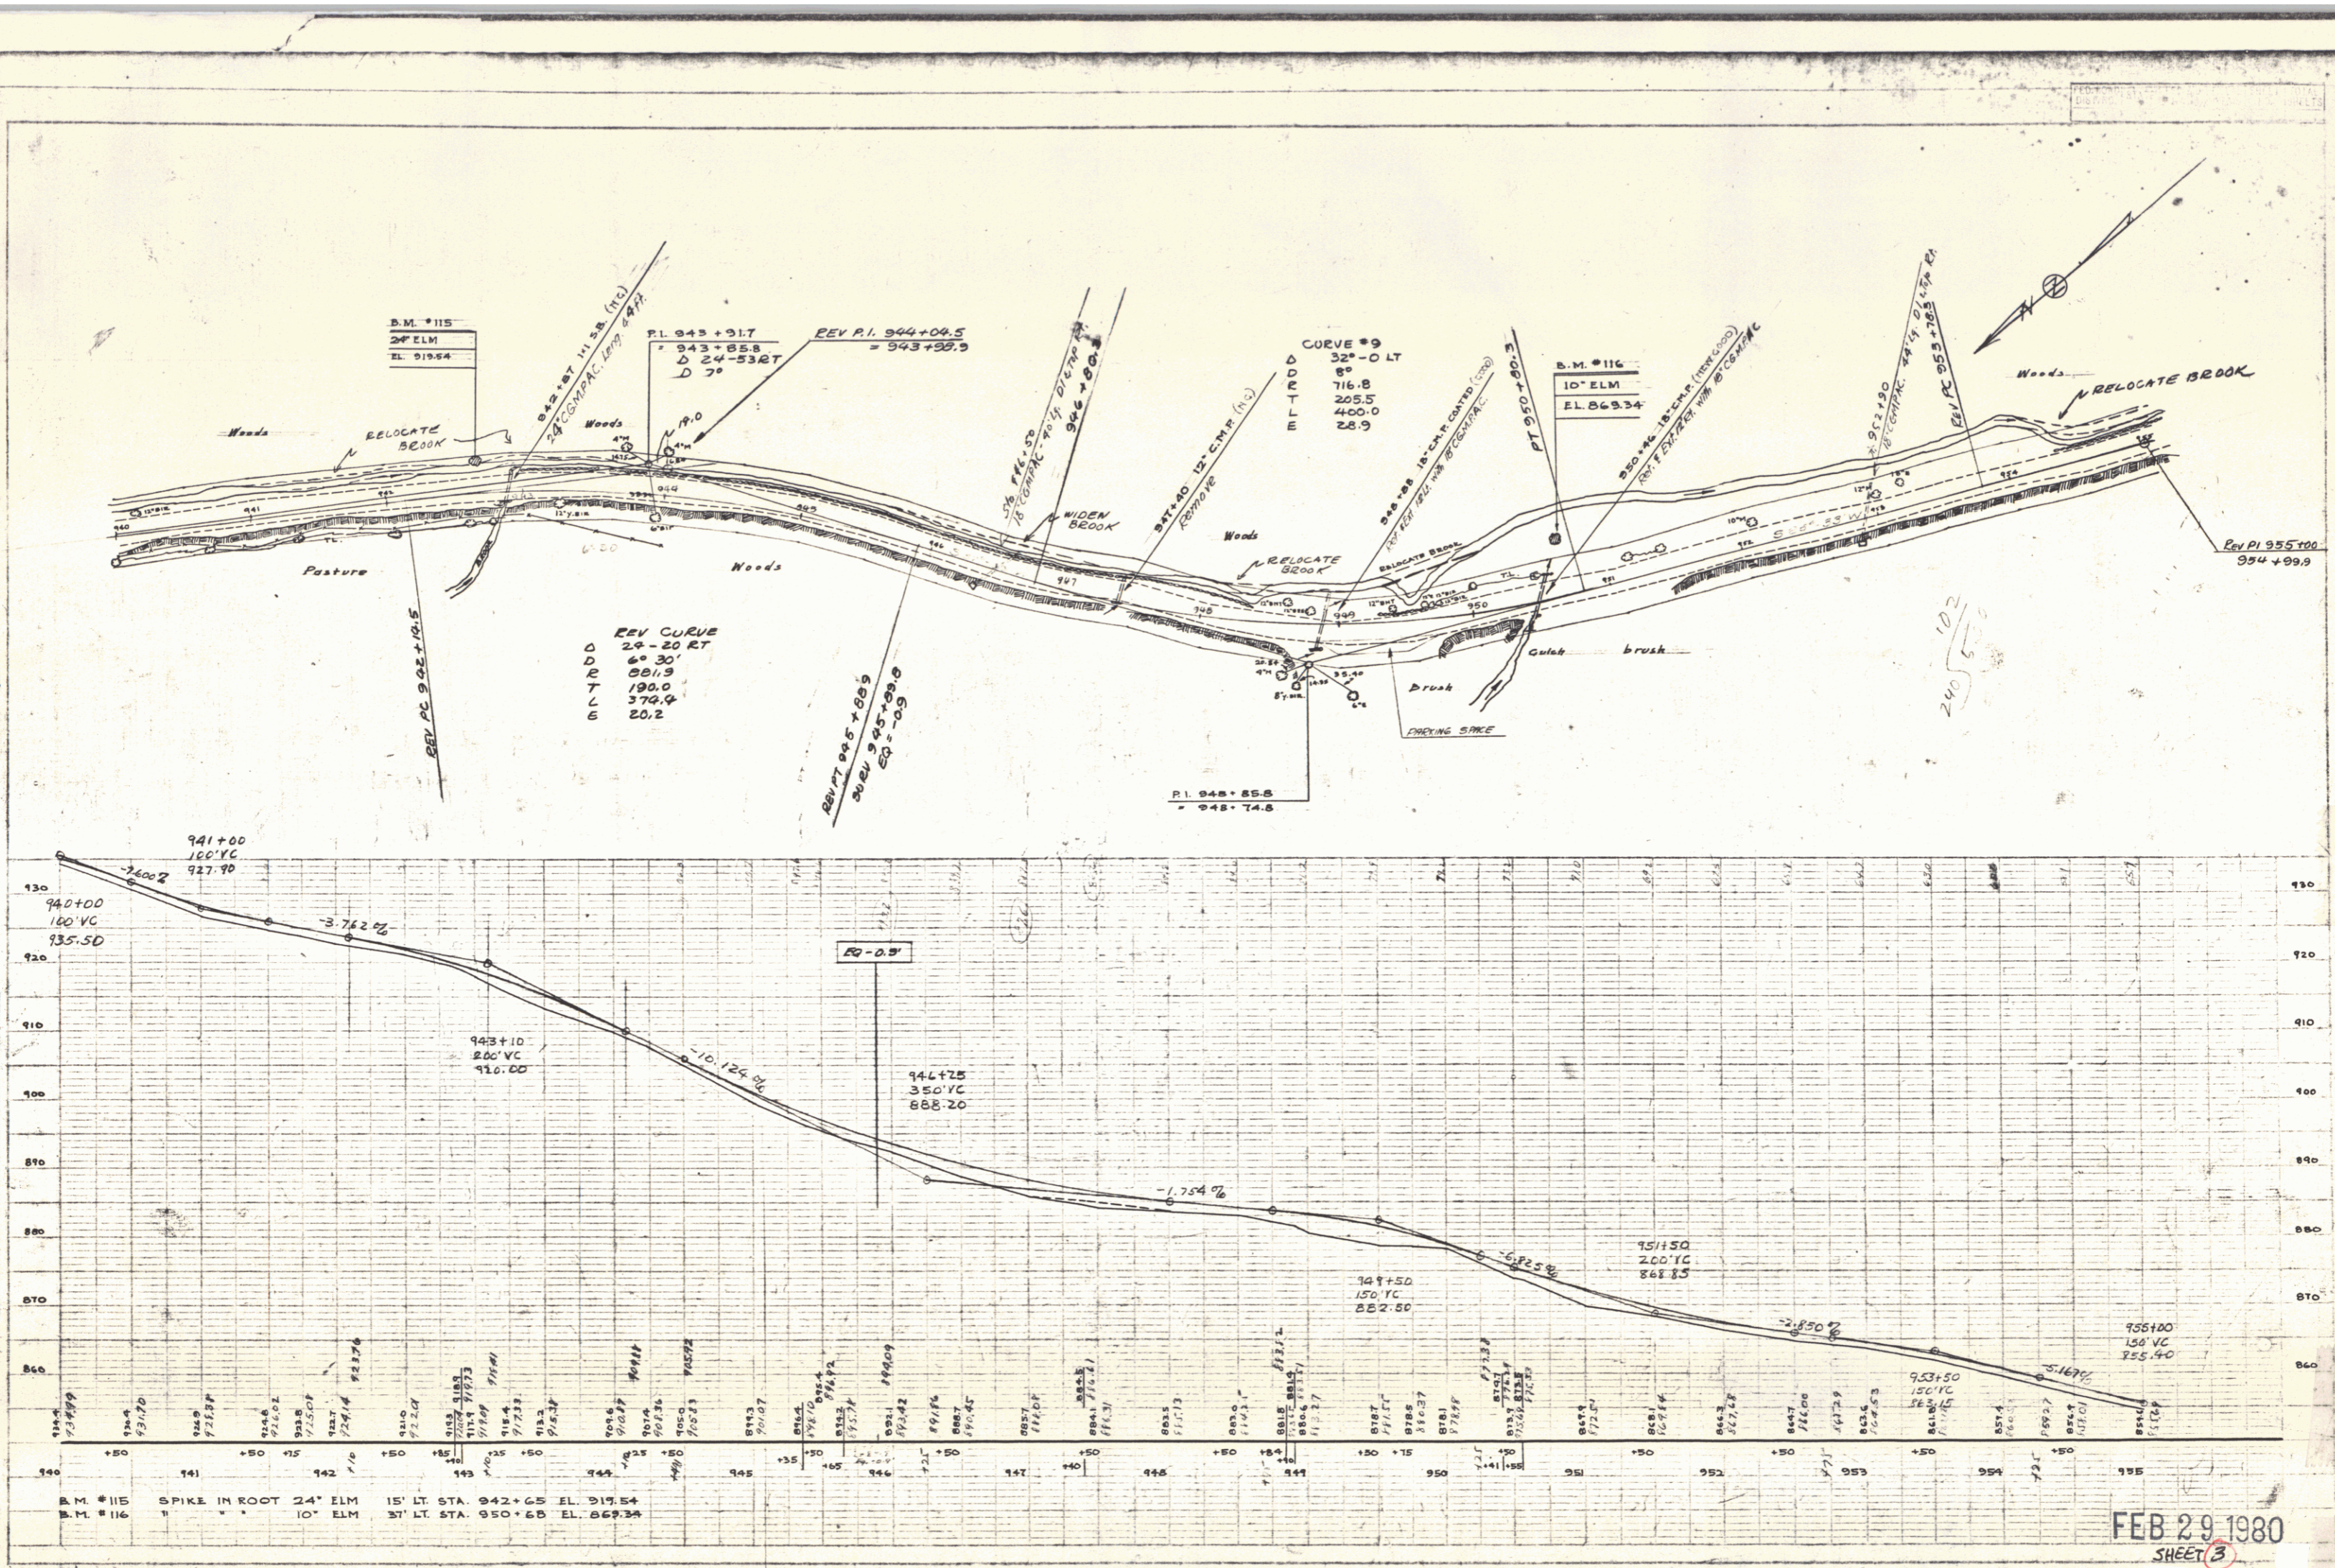

FEB 29 1980
 SHEET 3

3