



PLAN  
 C. E. POTNAM 2/74  
 D. MACCHI 2/74  
 D. MACCHI 2/74

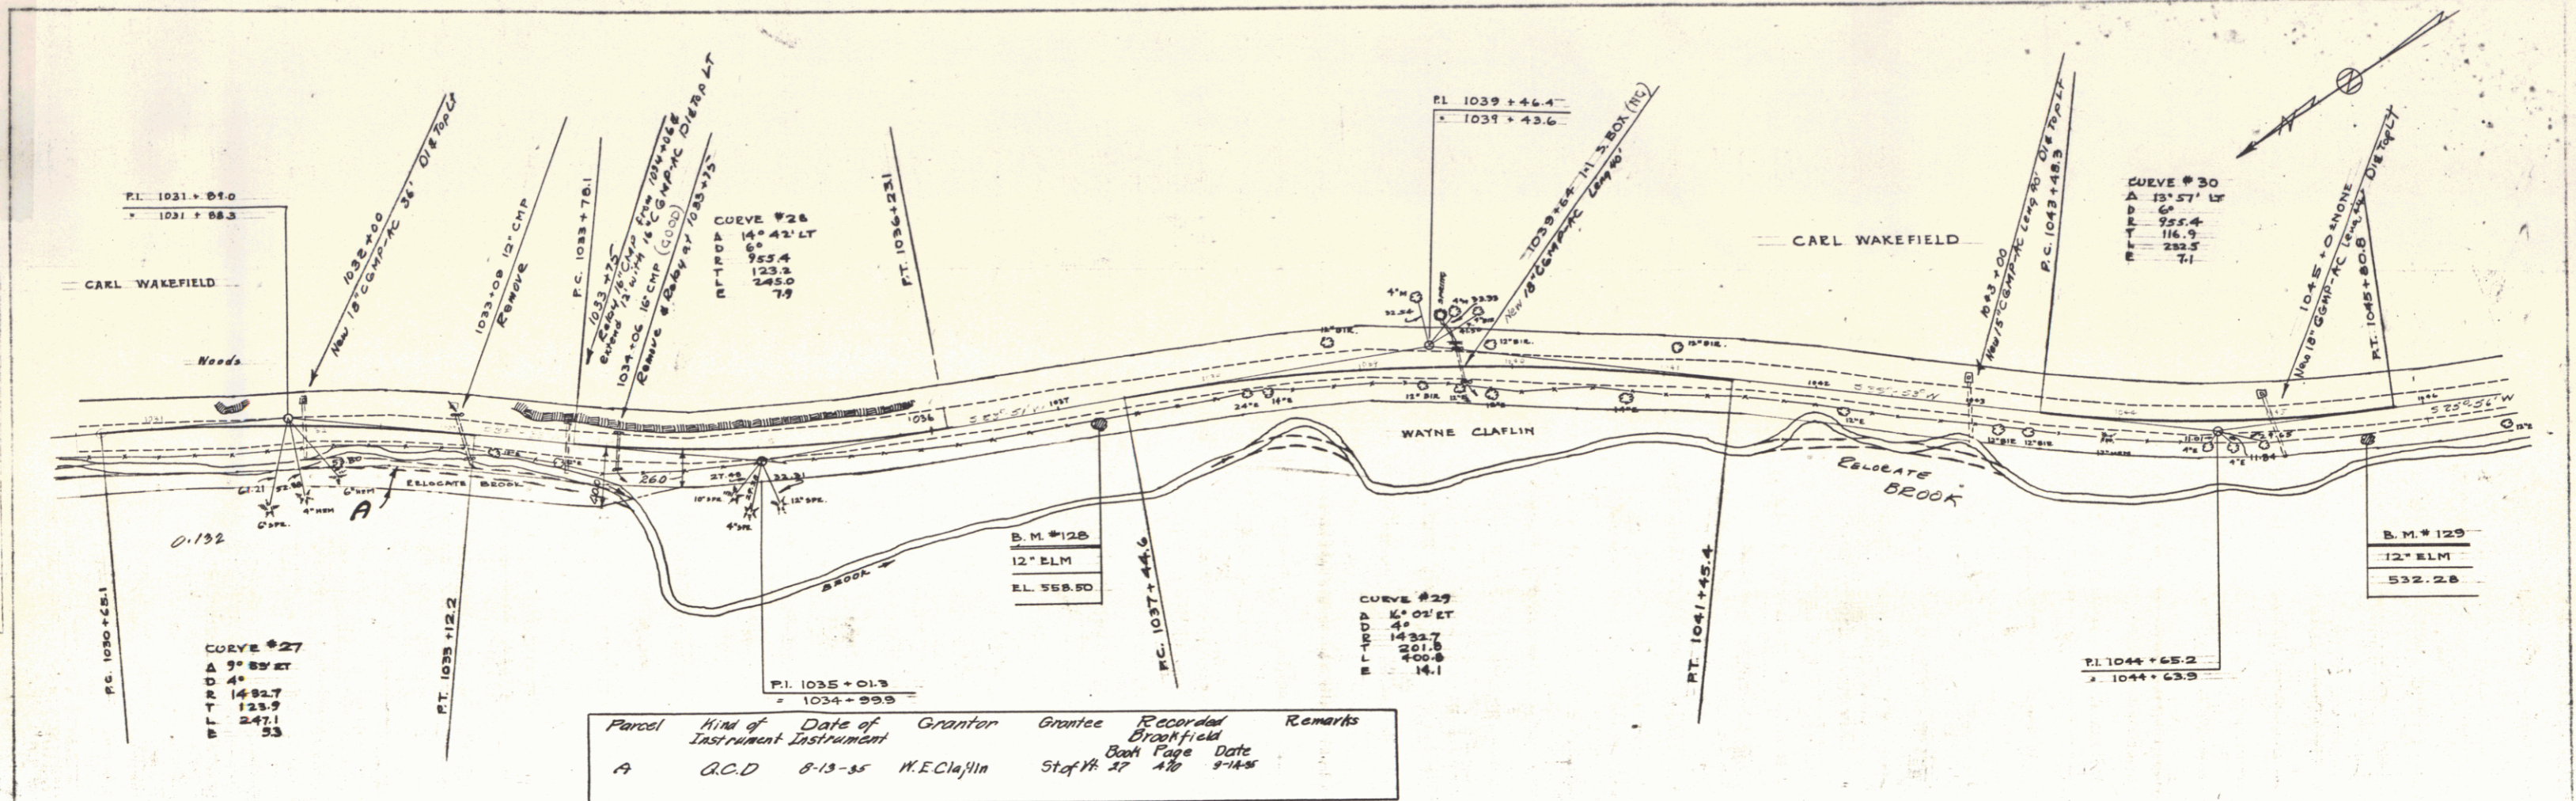

Parcel	Kind of Instrument	Date of Instrument	Grantor	Grantee	Recorded	Remarks
A	C.C.D.	8-13-55	W.E. Clafin	Staff	Book 17 Page 118	Date 8-14-55

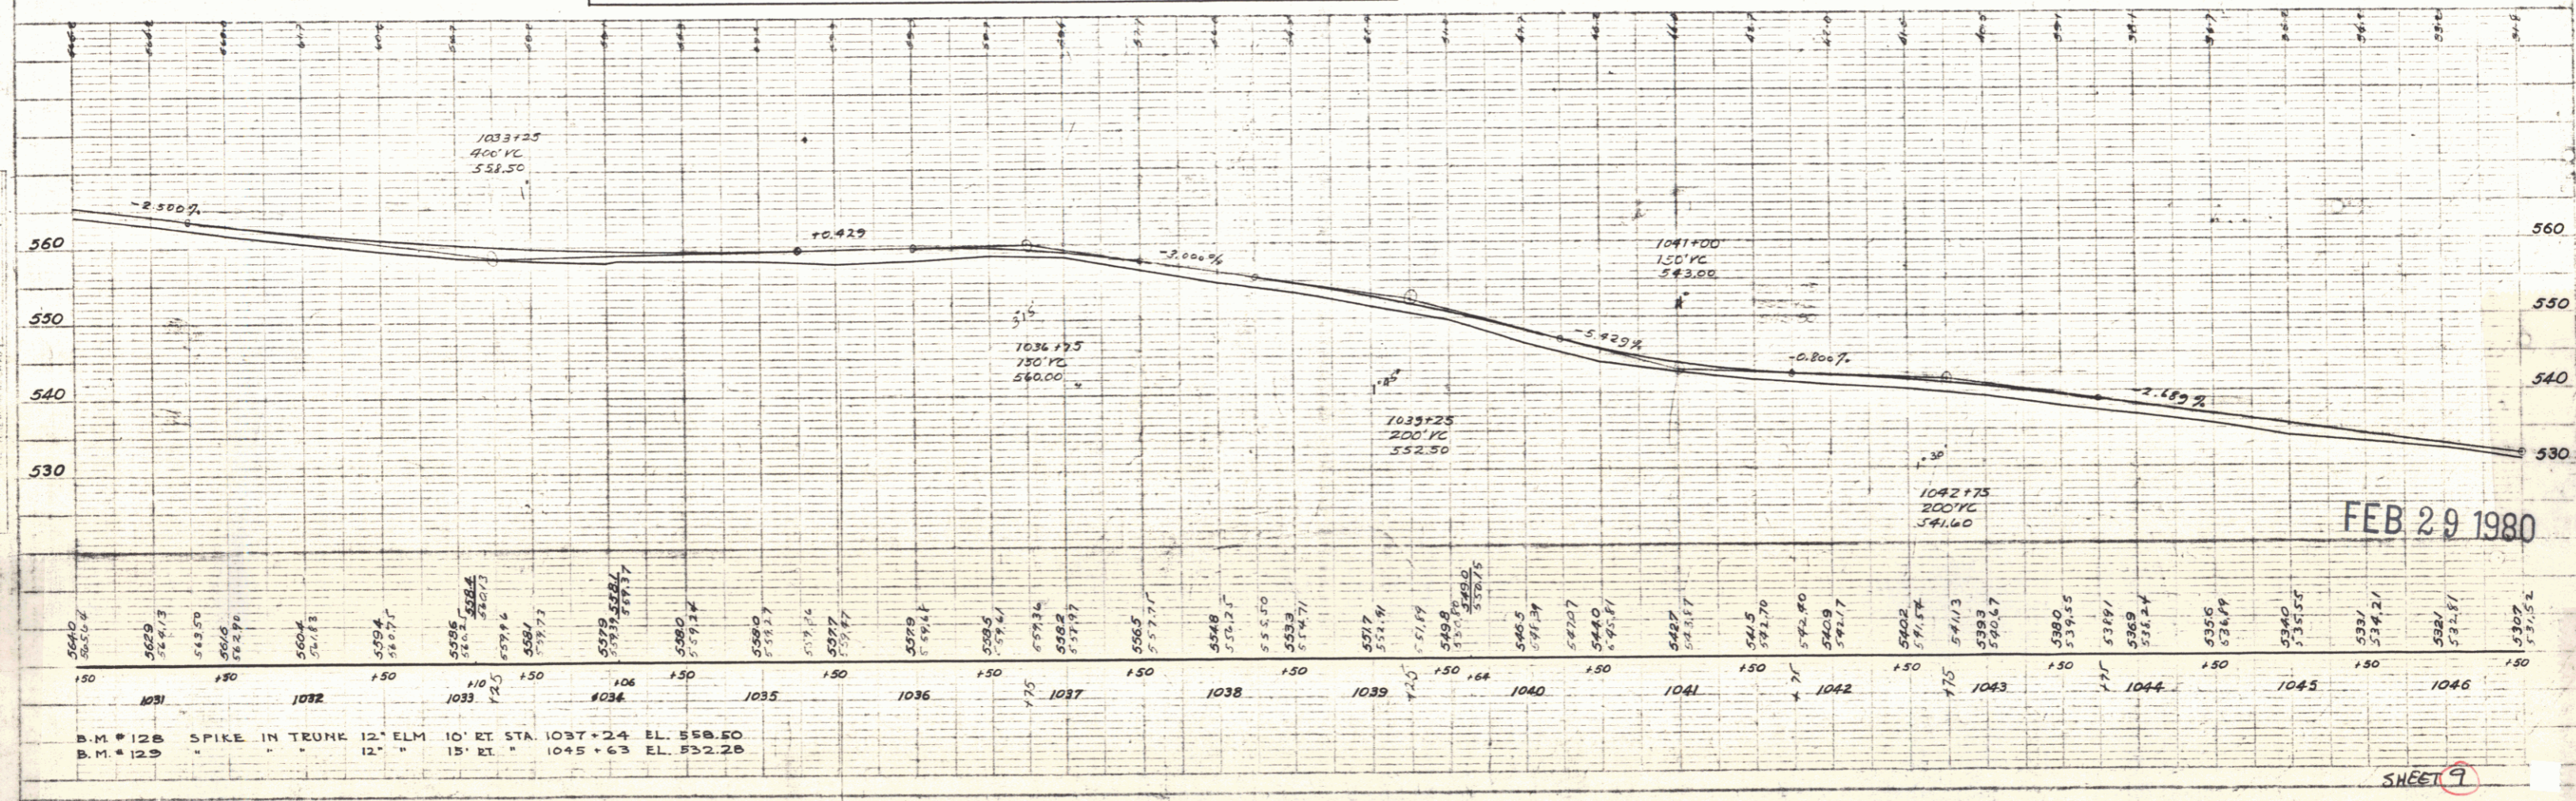

B.M. #128 SPIKE IN TRUNK 12' ELM 10' RT STA. 1037+24 EL. 558.50  
 B.M. #129 SPIKE IN TRUNK 12' ELM 15' RT STA. 1045+63 EL. 552.28

FEB 29 1980

SHEET 9

9