


PLAN
 DRAWN BY: [Name]
 CHECKED BY: [Name]
 DATE: 9-48


PROFILE
 DRAWN BY: [Name]
 CHECKED BY: [Name]
 DATE: 9-48

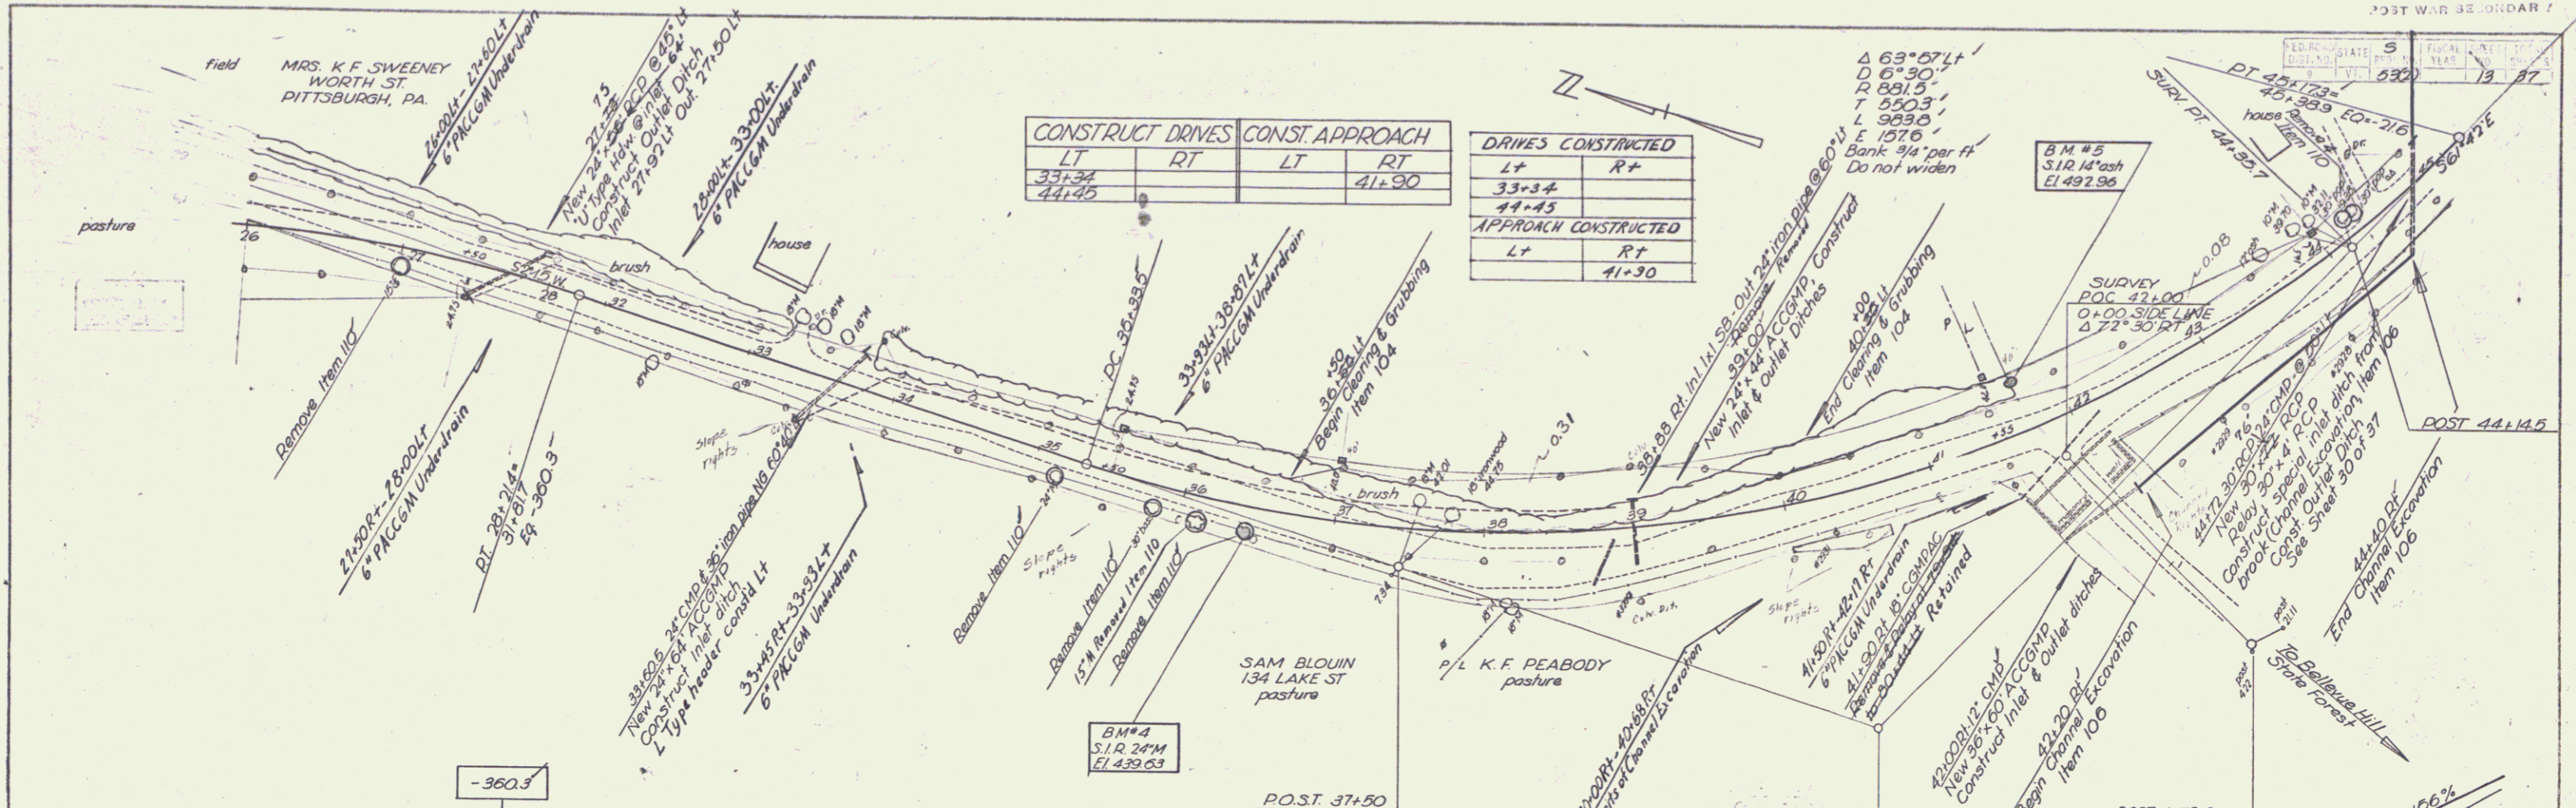

CONSTRUCT DRIVES		CONST. APPROACH	
LT	RT	LT	RT
33+34			41+90
44+45			

DRIVES CONSTRUCTED	
L+	R+
33+34	
44+45	

APPROACH CONSTRUCTED	
L+	R+
	41+30

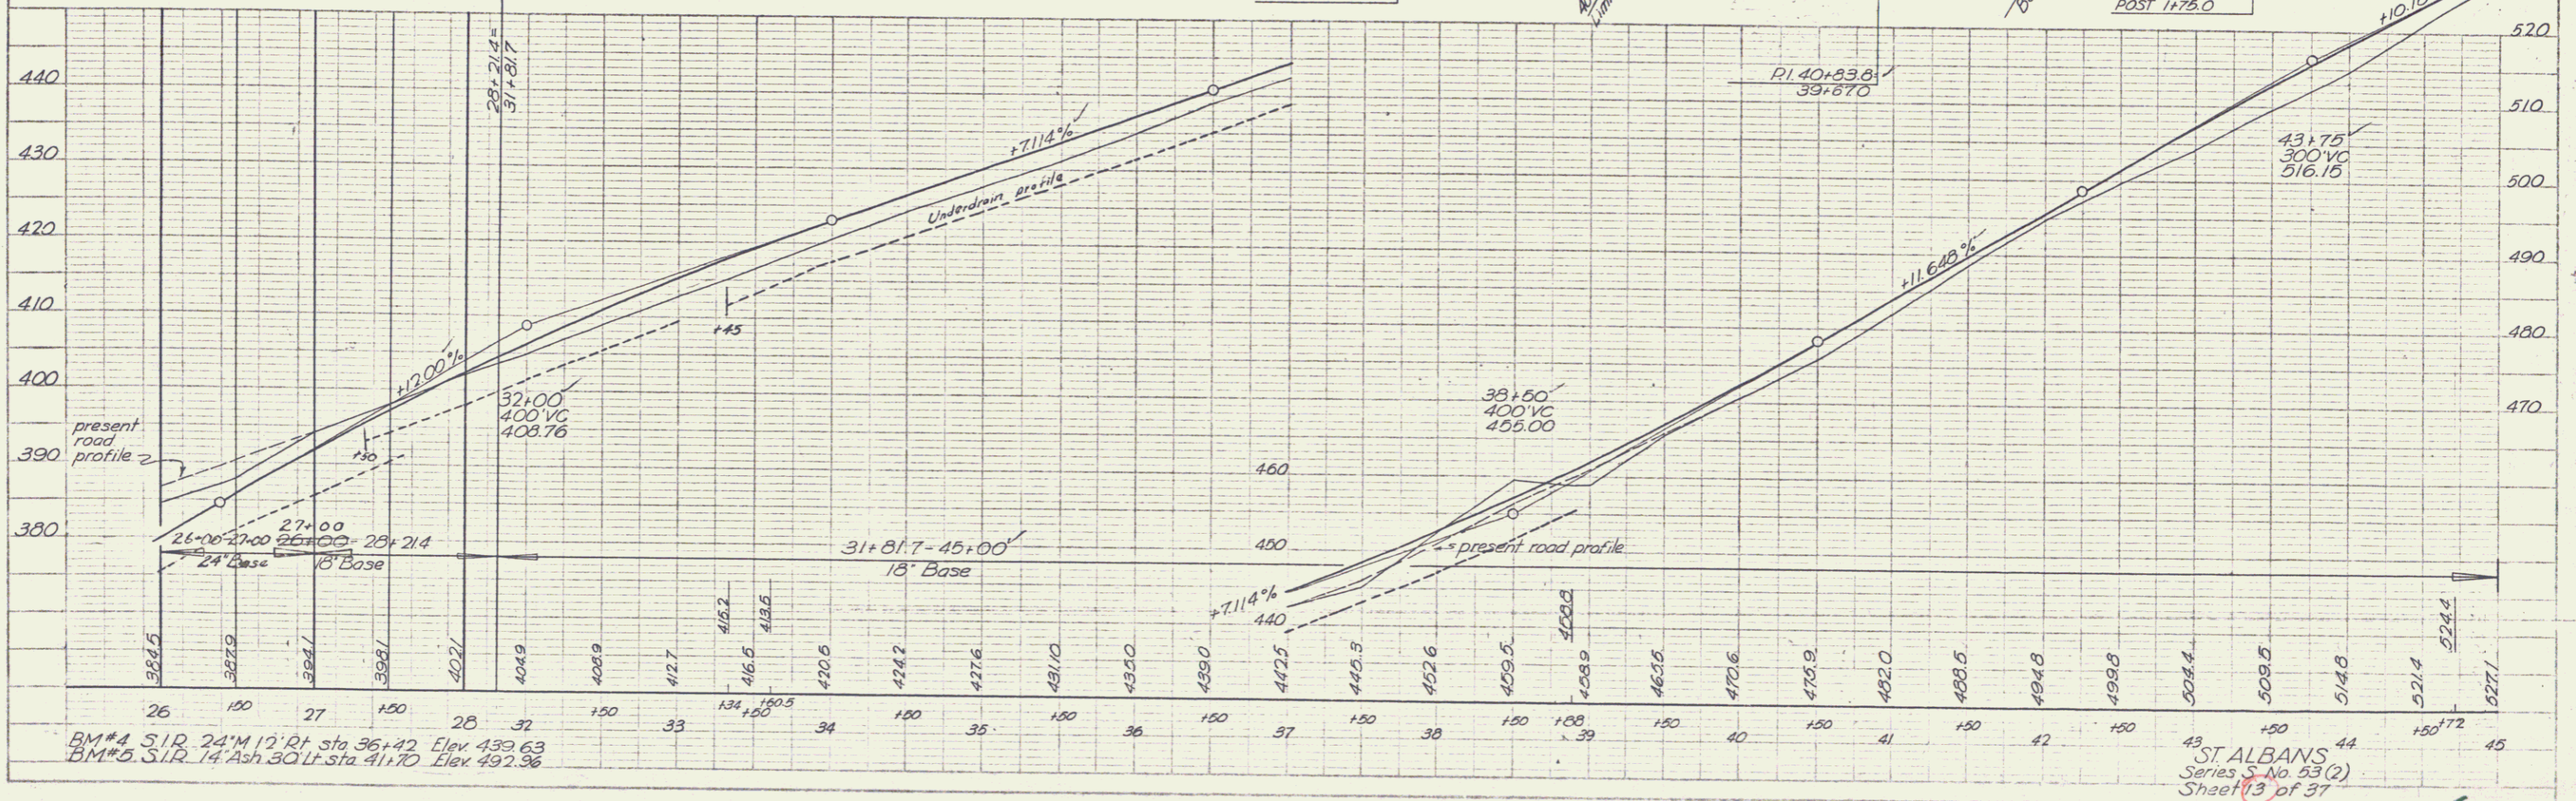

BM#4 S.I.R. 24'M 12' RT sta 36+42 Elev. 439.63
 BM#5 S.I.R. 14' Ash 30' Lt. sta 41+70 Elev. 492.96

ST ALBANS
 Series S No 53(2)
 Sheet 13 of 37