



PLAN	DATE	BY
NO.	2-23	W.H.
NO.		

PROFILE	DATE	BY
NO.	2-23	W.H.
NO.		

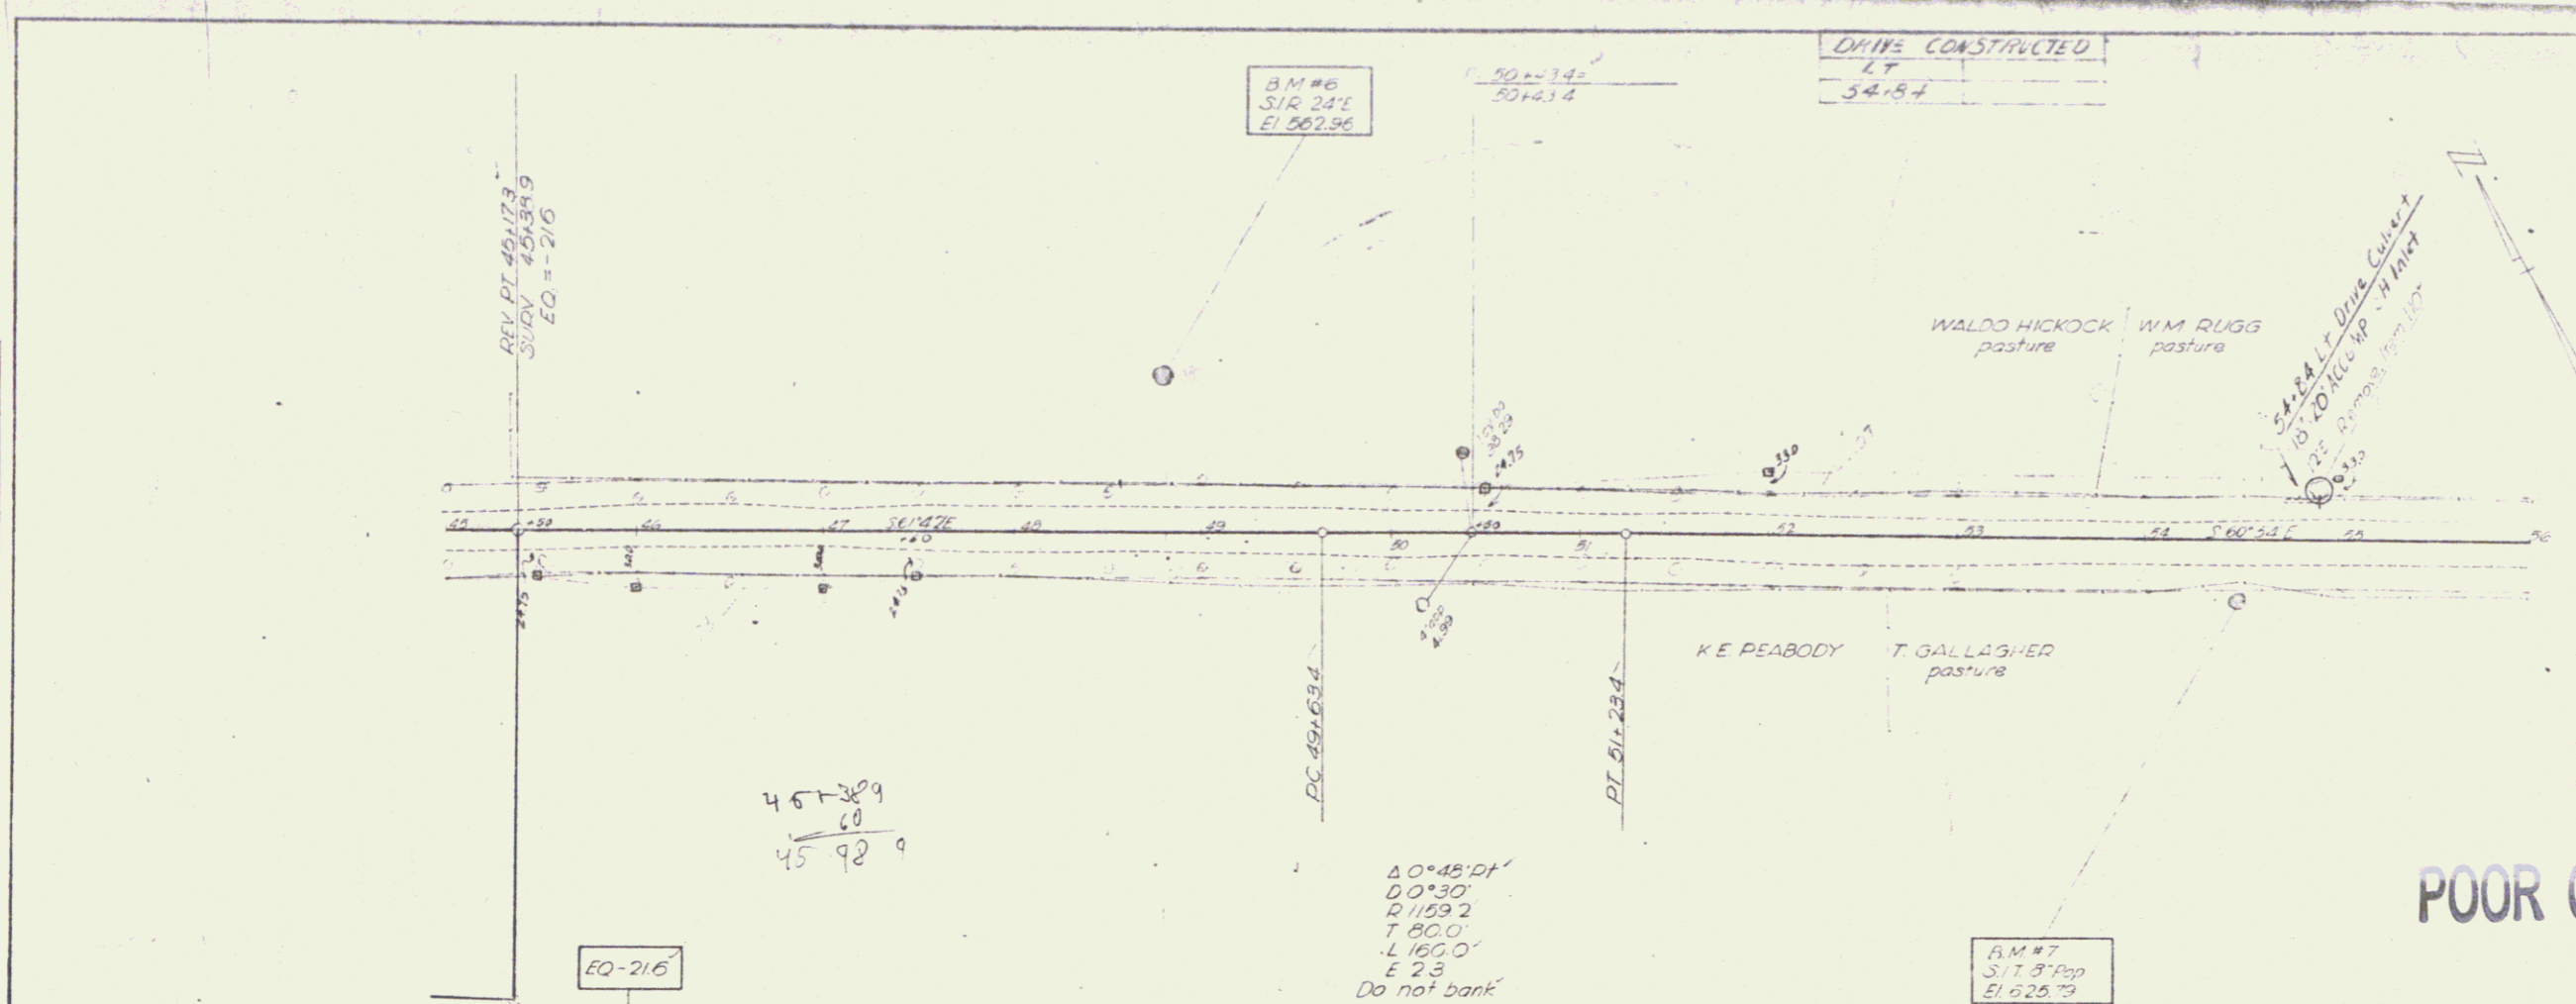

POOR ORIGINAL COPY

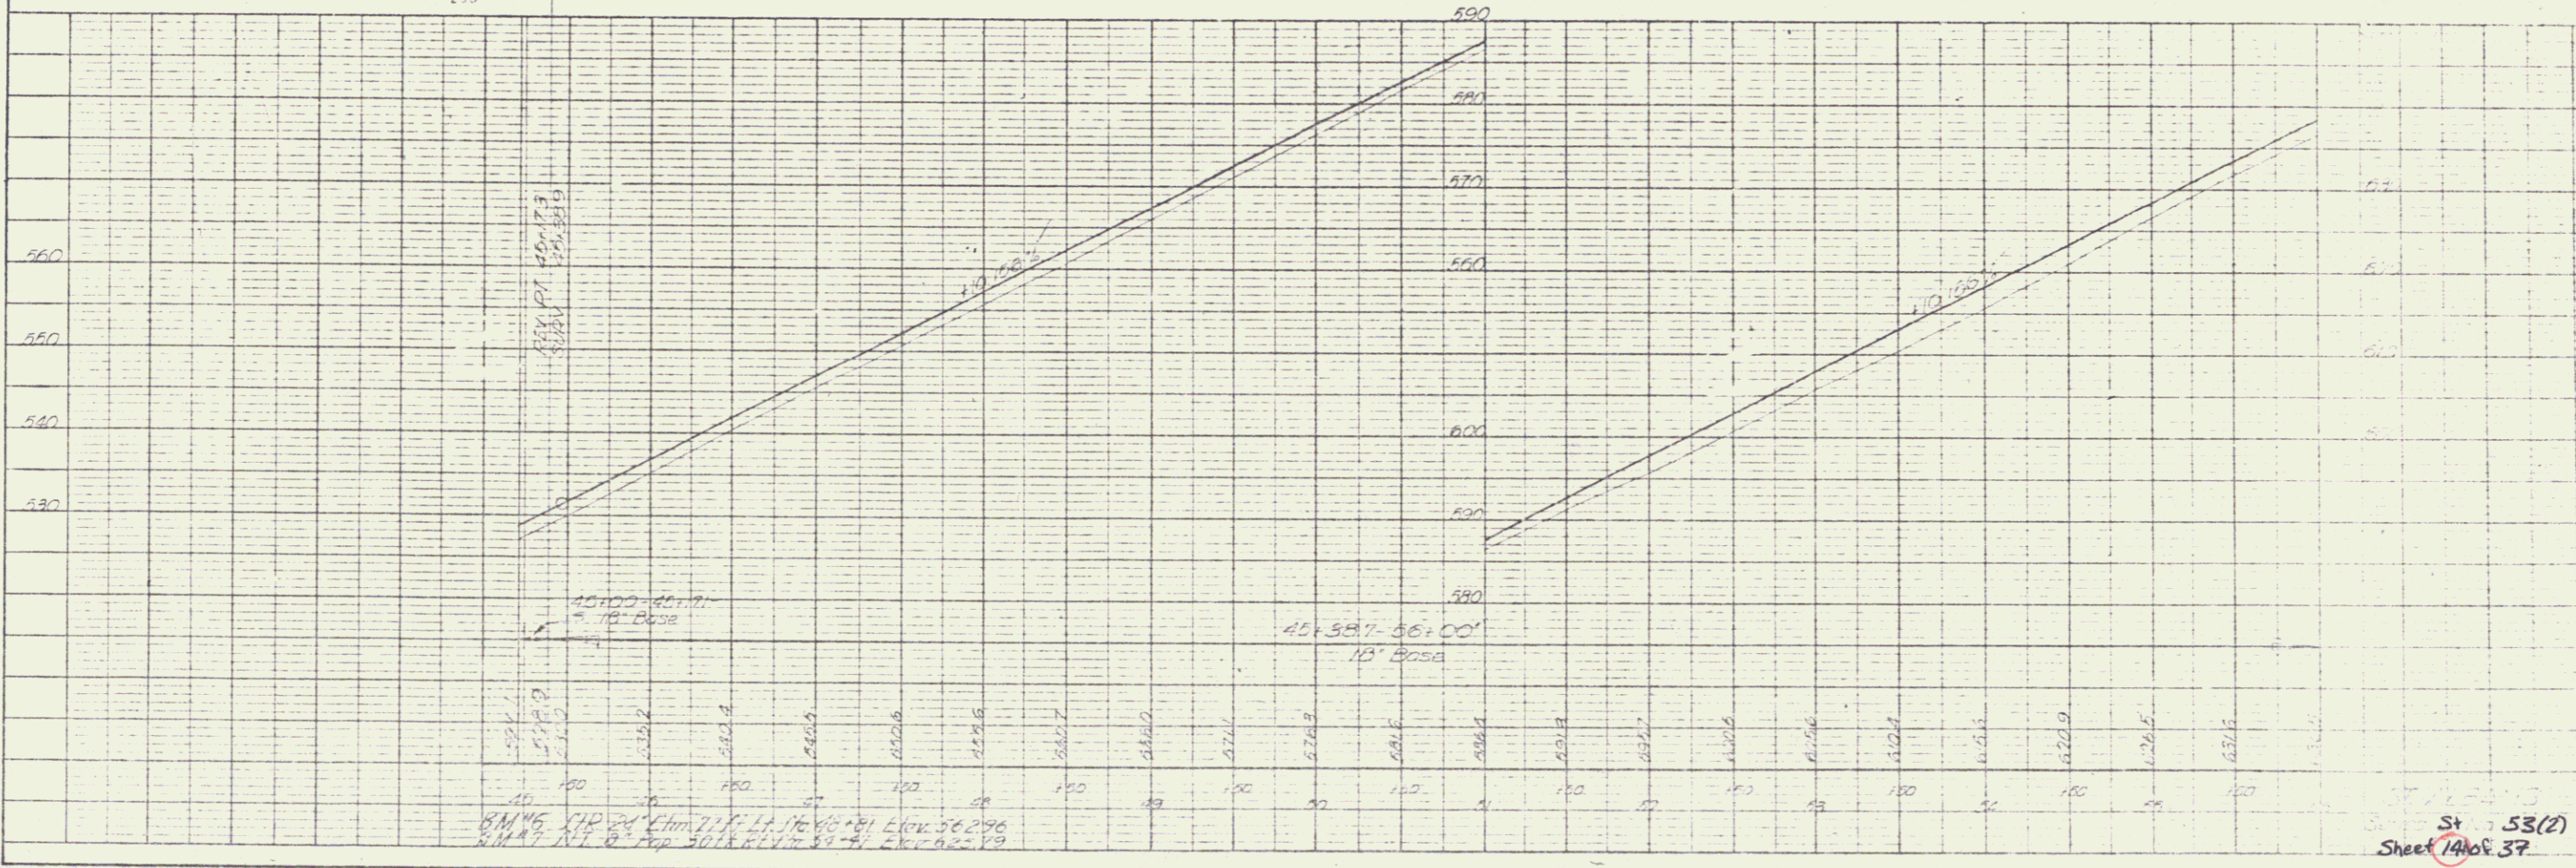

St. 53(2)
 Sheet 14 of 37