


FED. ROAD DIST. NO.	STATE	PROJECT NO.	FISCAL YEAR	SHEET NO.	TOTAL SHEETS
9	VI.	53(2)	19	37	

PLAN
 DRAWN BY: [Signature]
 CHECKED BY: [Signature]
 DATE: 9-48
 SHEET NO. 2-48

PROFILE
 DRAWN BY: [Signature]
 CHECKED BY: [Signature]
 DATE: 9-48
 SHEET NO. 2-48

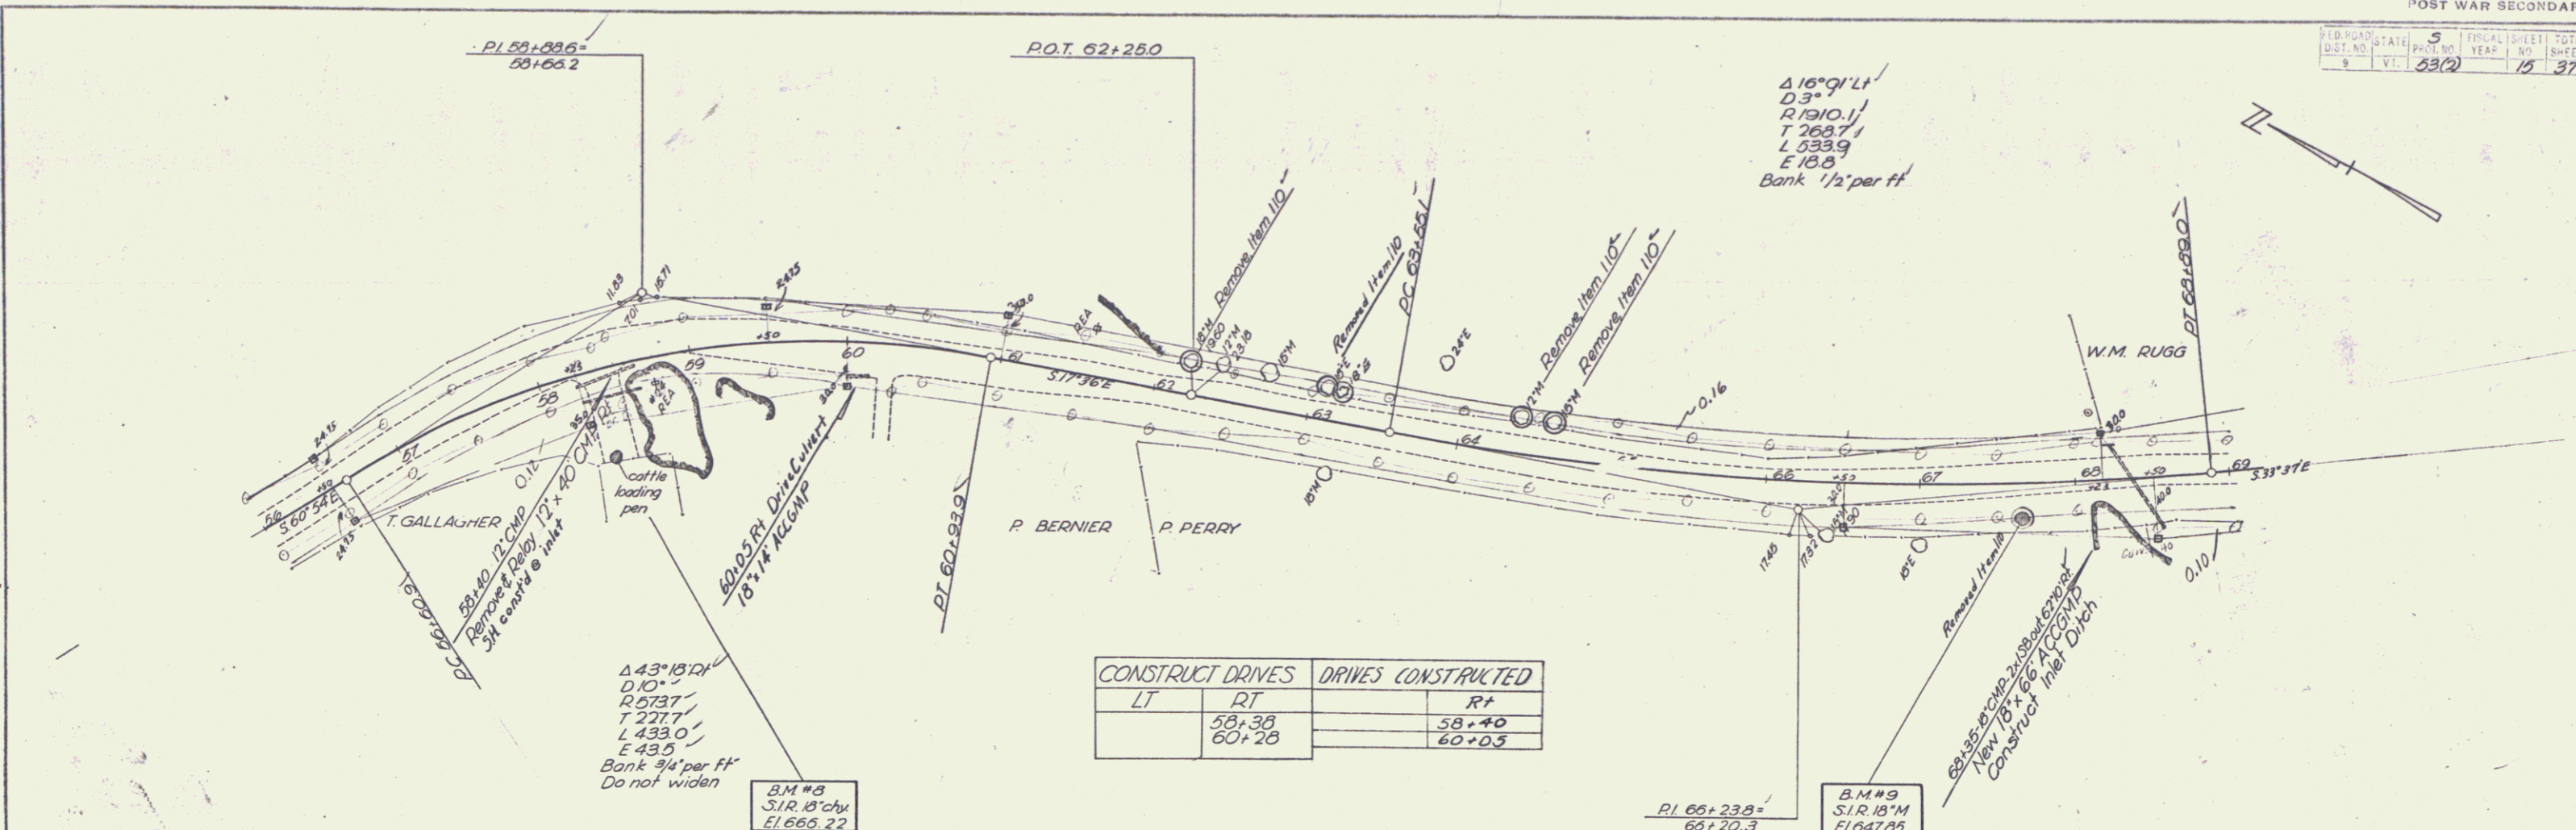

CONSTRUCT DRIVES		DRIVES CONSTRUCTED	
LT	RT	LT	RT
	58+38		58+40
	60+28		60+05

