



PLAN  
 SURVEYED BY  
 PARTIAL  
 DATE  
 SCALE  
 SHEET NO. 16 OF 37

PROFILE  
 SURVEYED BY  
 PARTIAL  
 DATE  
 SCALE  
 SHEET NO. 16 OF 37

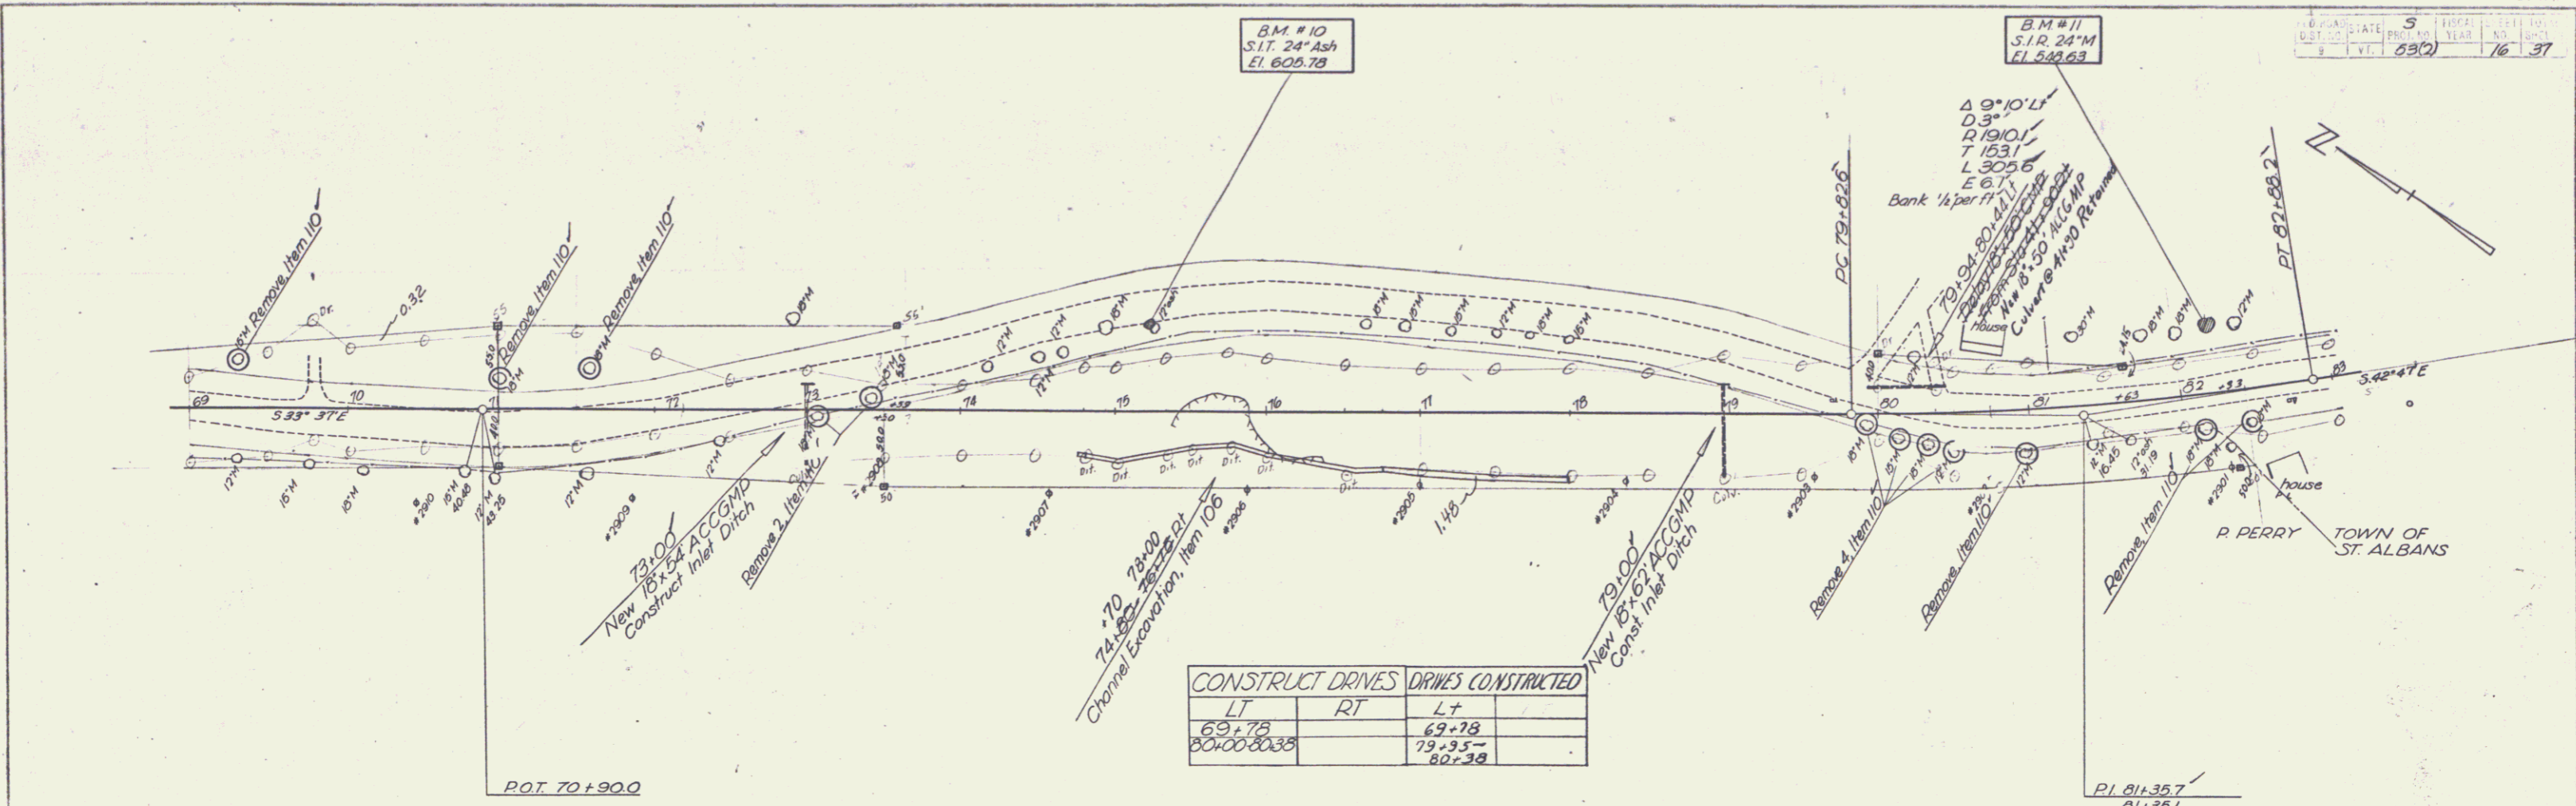

CONSTRUCT DRIVES		DRIVES CONSTRUCTED	
LT	RT	LT	RT
69+78		69+78	
80+00-80.33		79+35-	80+38

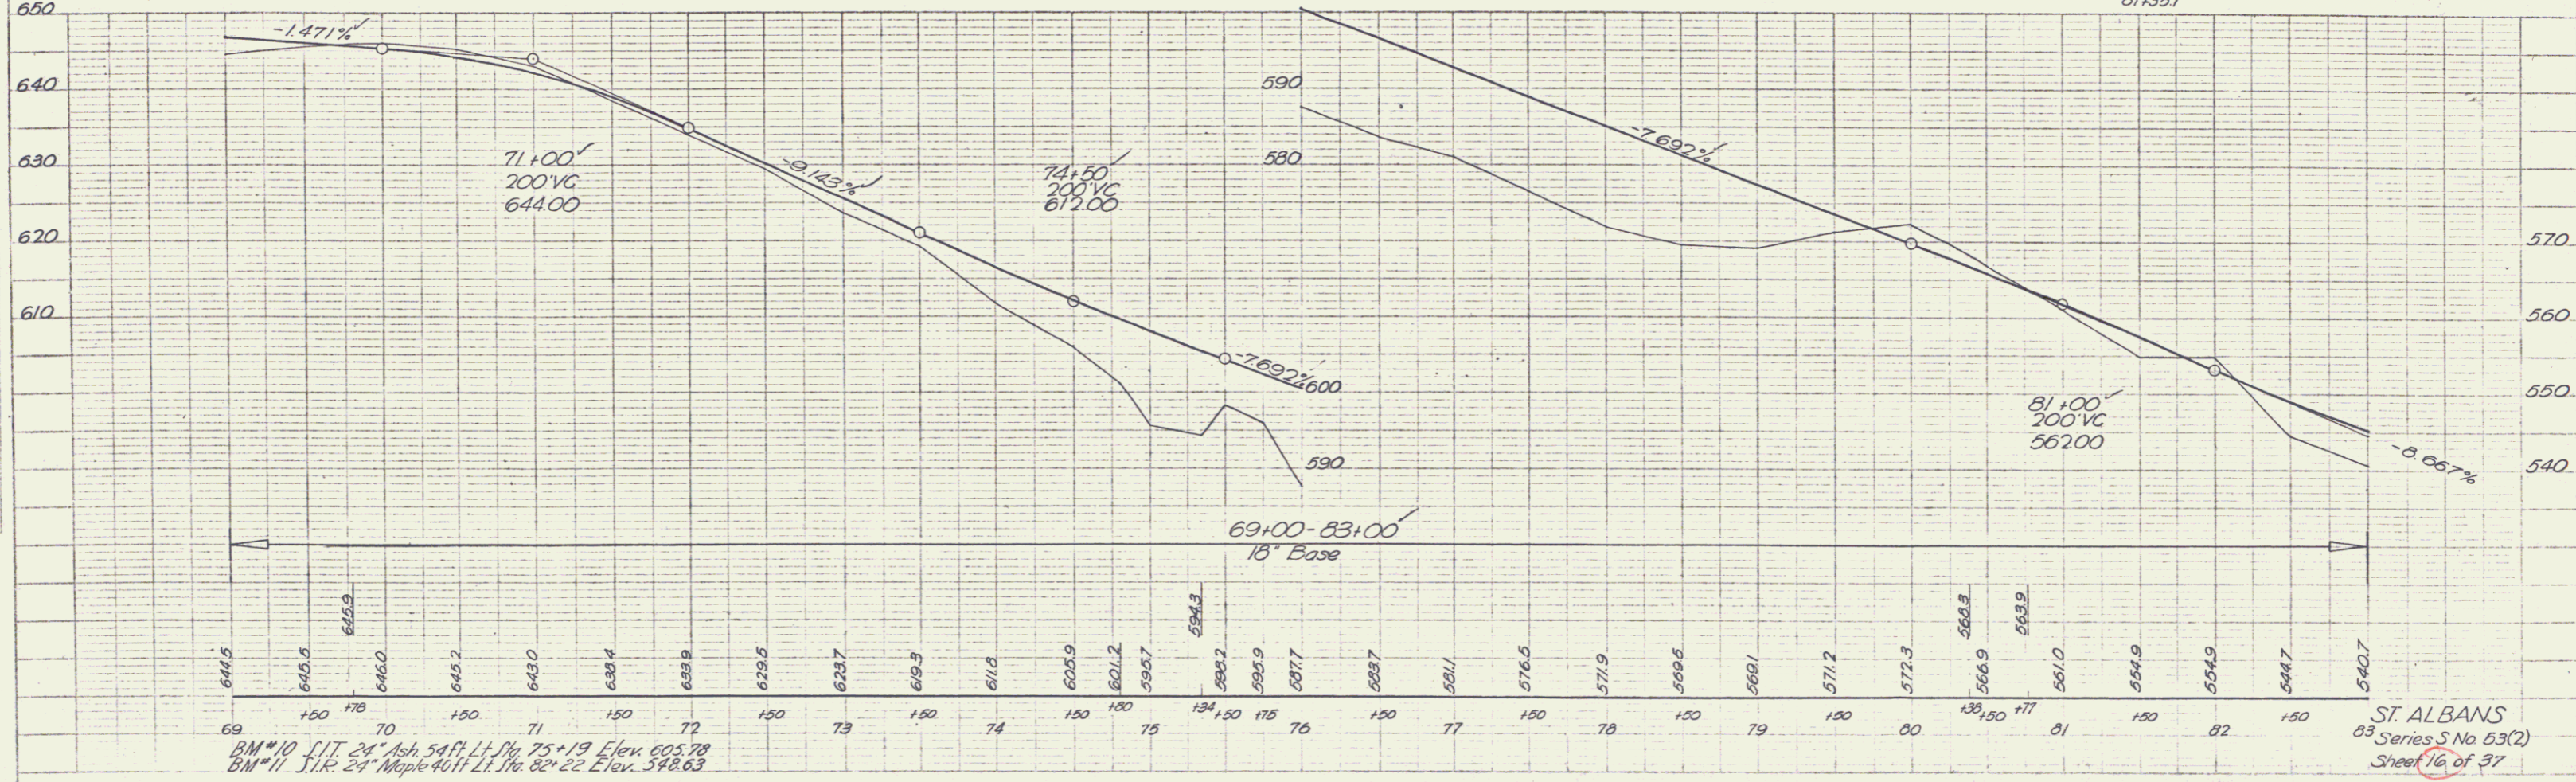

BM #10 S.I.T. 24" Ash 54" H. L. Pk. 75+19 Elev. 605.79  
 BM #11 S.I.R. 24" Maple 40" H. L. Pk. 82+22 Elev. 598.63