

PLAN
 DATE: 1/28/29
 DRAWN BY: H. S. HURLEY
 CHECKED BY: H. S. HURLEY
 PROJECT: ST ALBANS - FAIRFIELD

PROFILE
 DATE: 1/28/29
 DRAWN BY: H. S. HURLEY
 CHECKED BY: H. S. HURLEY
 PROJECT: ST ALBANS - FAIRFIELD

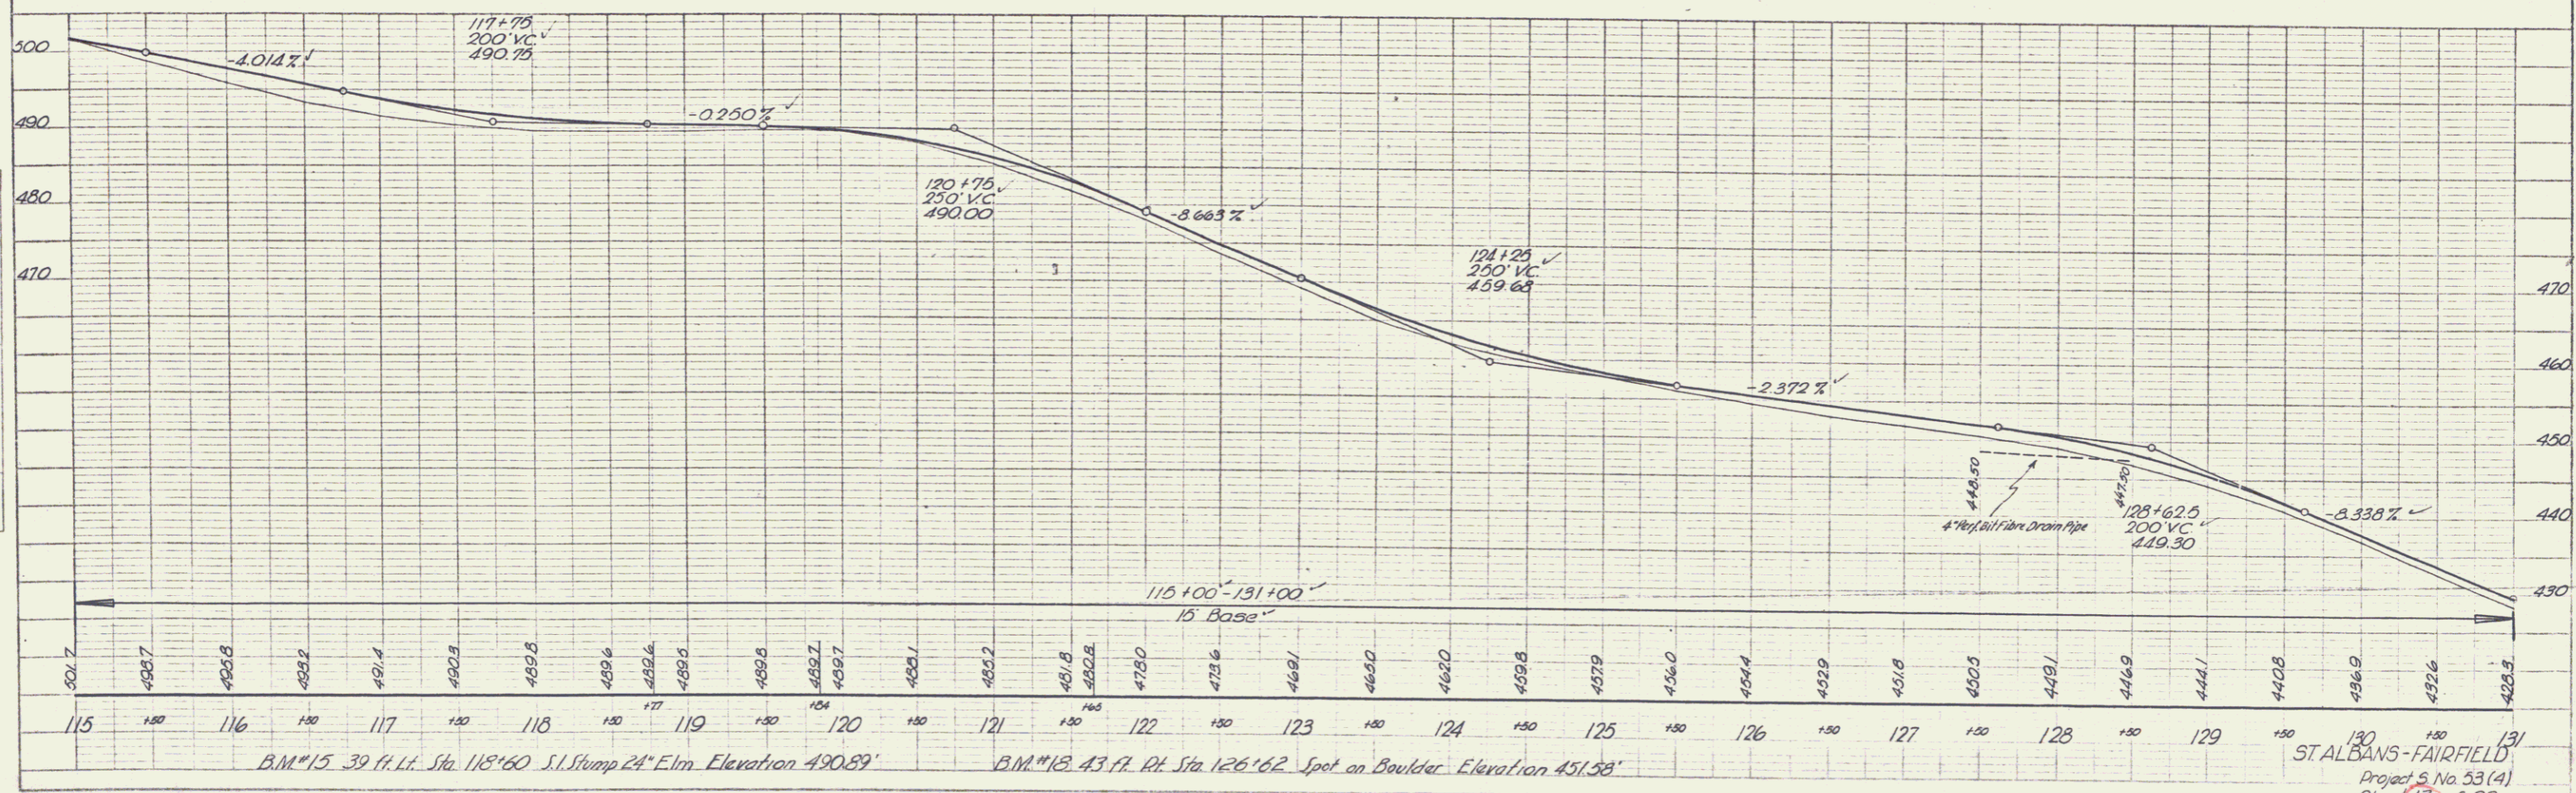
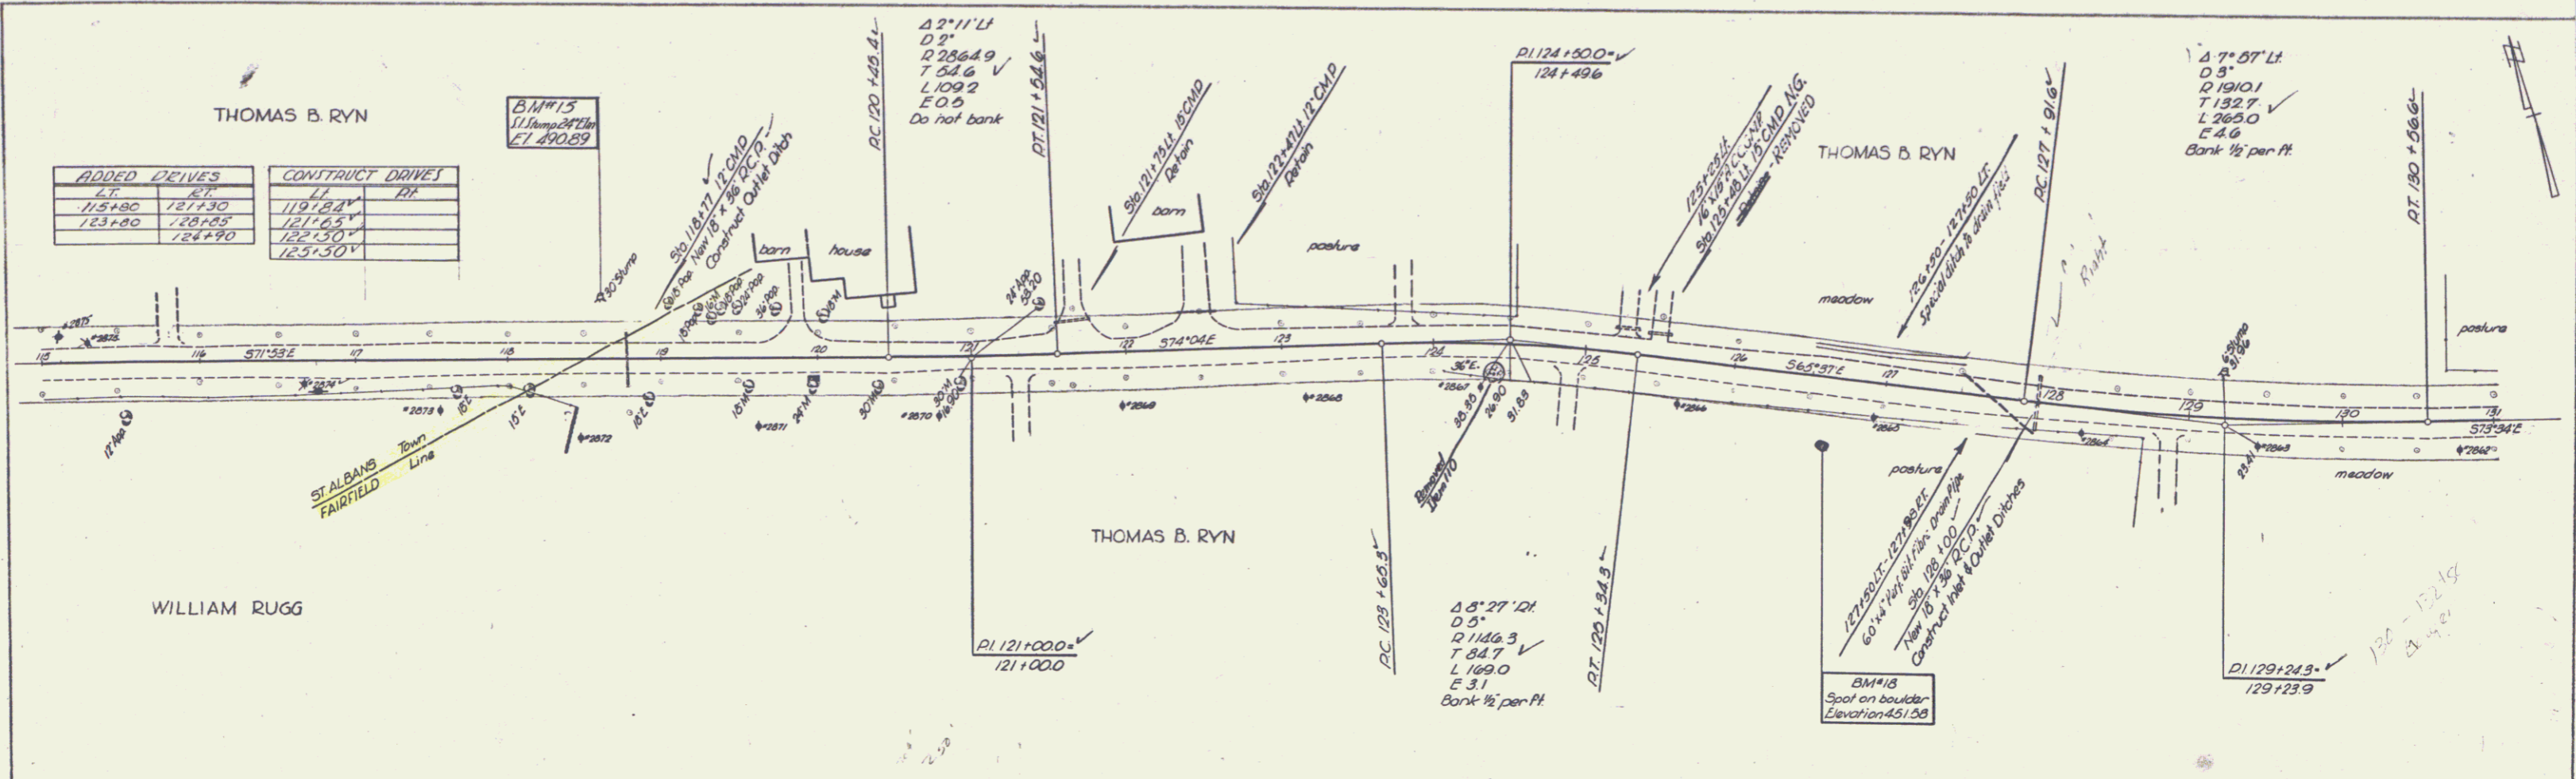


PLATE 1 - PLAN PROFILE
 PROF. G. & E. S. H. HURLEY

ST ALBANS - FAIRFIELD
 Project No. 53 (A)
 Sheet 13 of 29