


PLAN
 DRAWN BY
 CHECKED BY
 DATE
 PROJECT NO.
 SHEET NO.

PROFILE
 DRAWN BY
 CHECKED BY
 DATE
 PROJECT NO.
 SHEET NO.

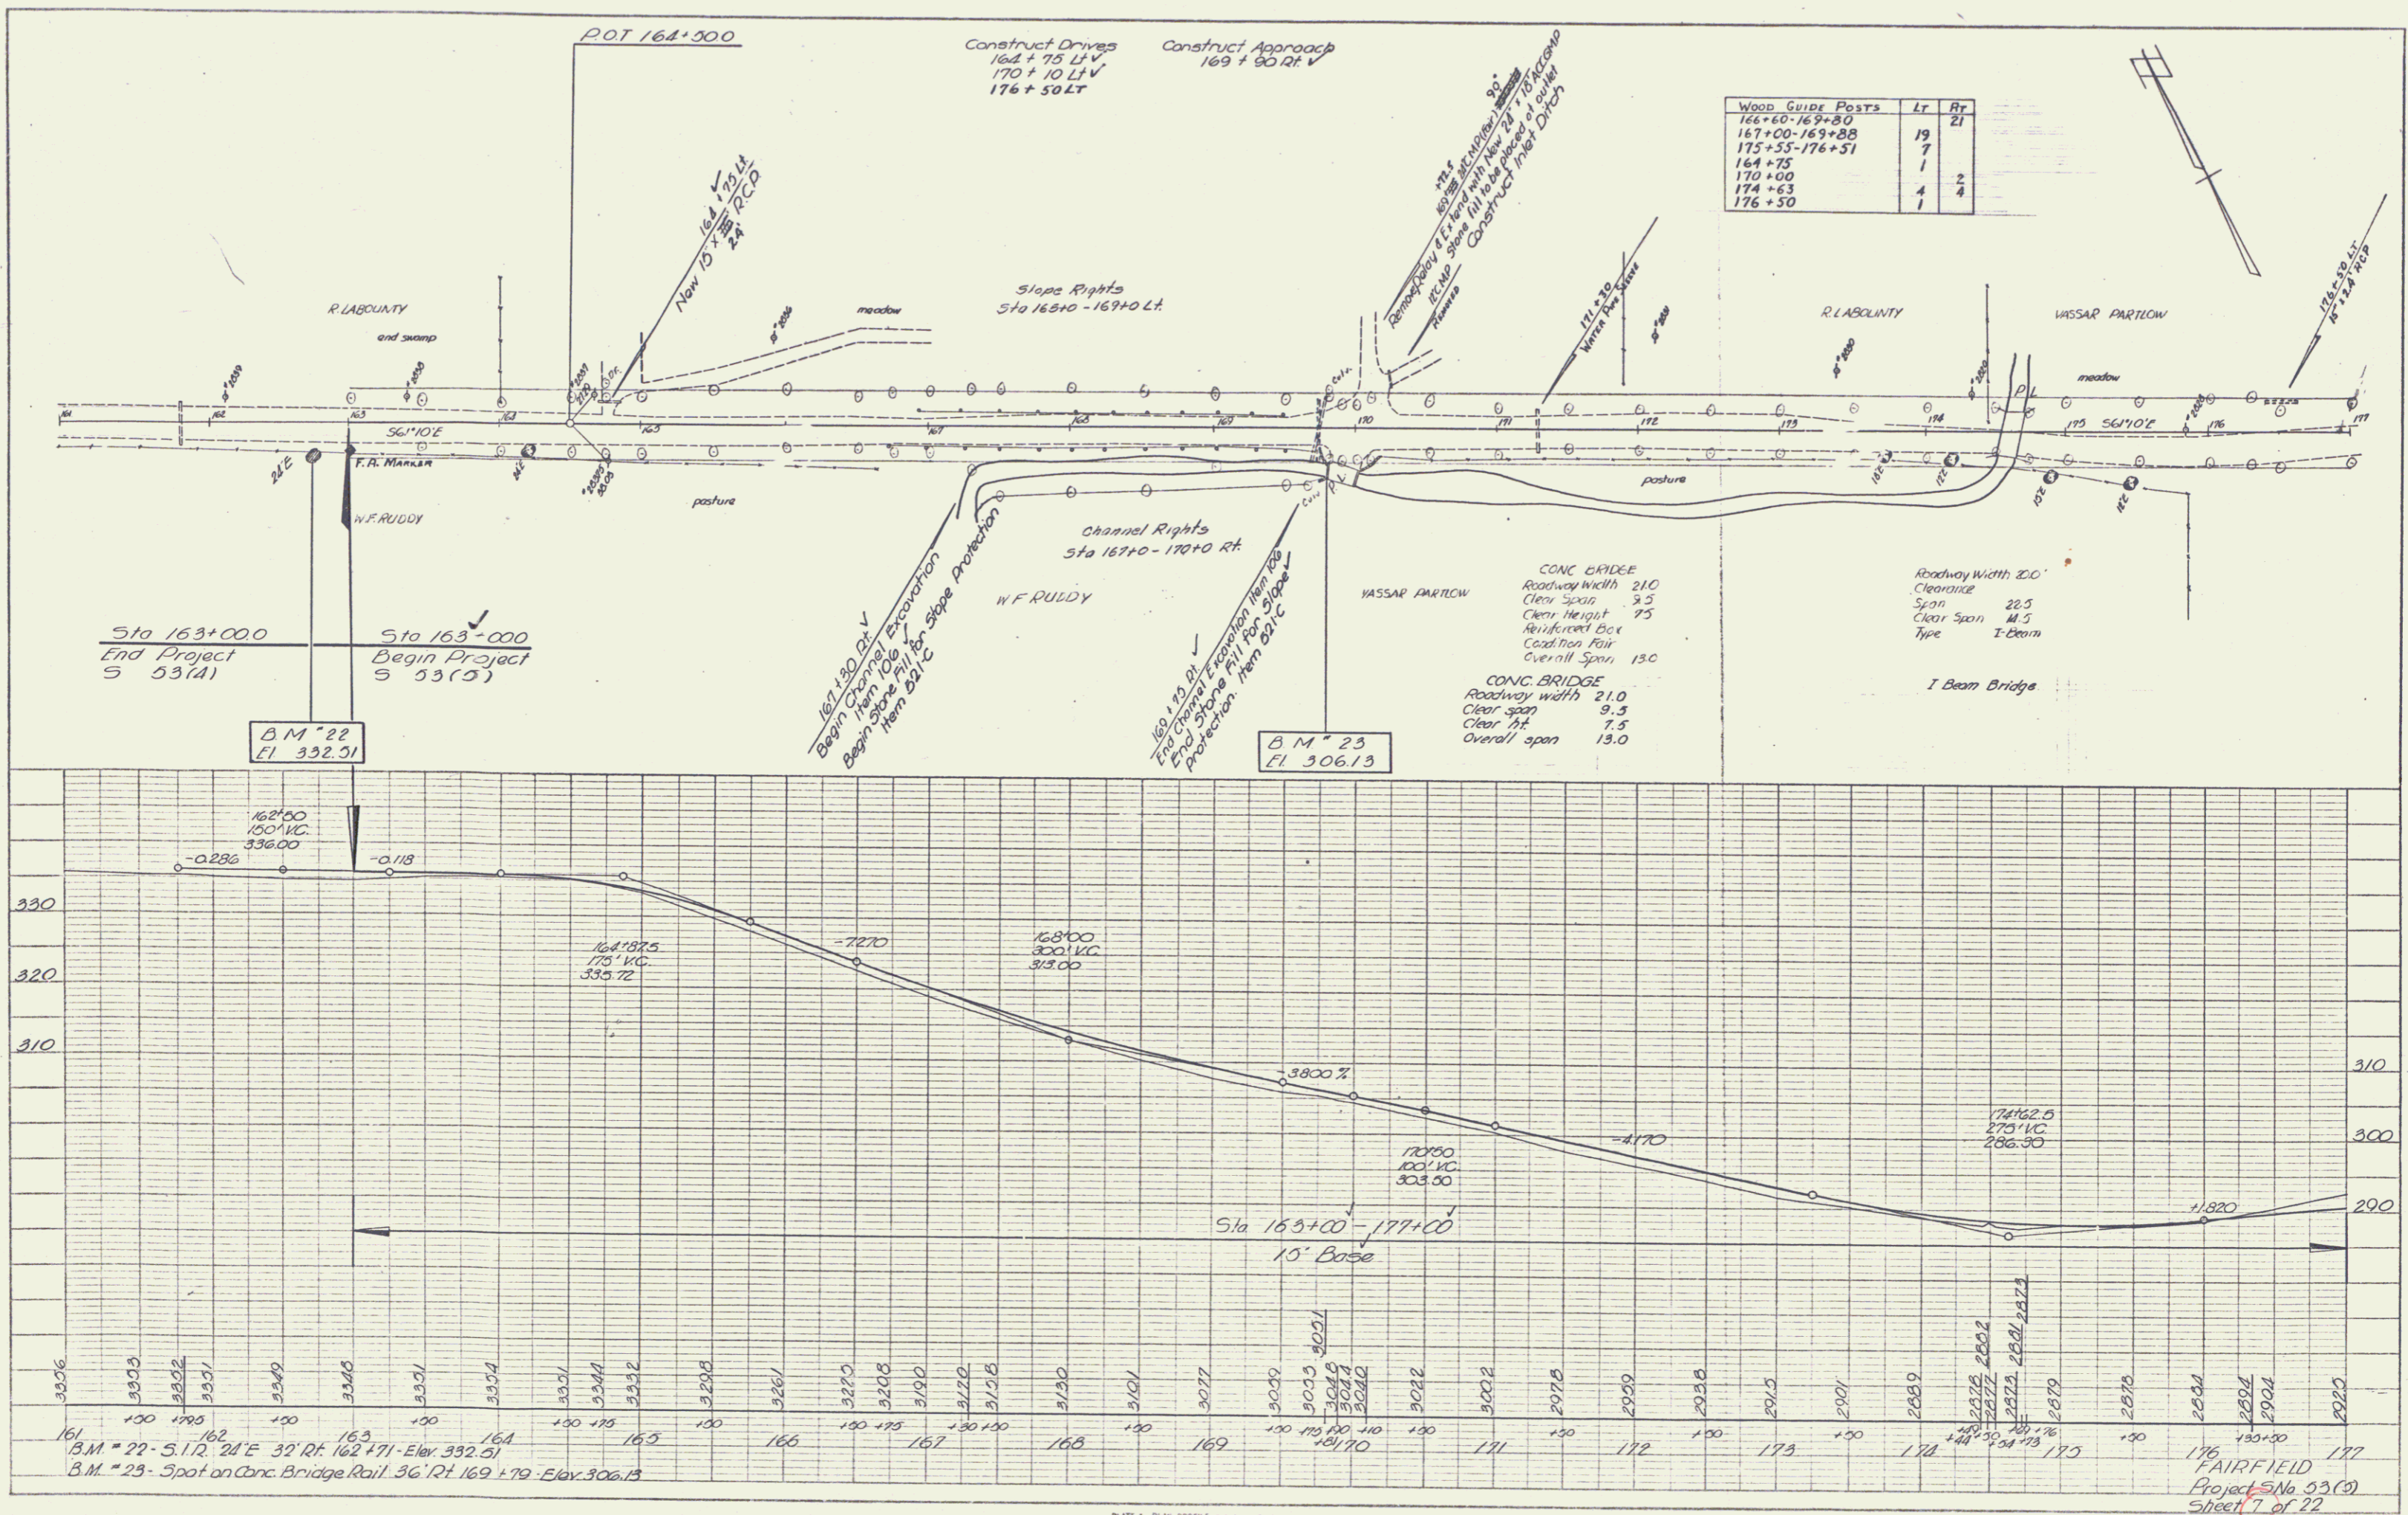

WOOD GUIDE POSTS	LT	RT
166+60-169+80	19	21
167+00-169+88	7	
175+55-176+51	1	2
164+75	4	4
170+00	1	
174+63	1	
176+50		

Sta 163+000
 End Project S 53(41)

Sta 163+000
 Begin Project S 53(5)

B.M. 22
 El. 332.51

B.M. 23
 El. 306.13

B.M. 22 - S. 172. 24' E 32' RT. 162+71 - Elev. 332.51
 B.M. 23 - Spot on Conc. Bridge Rail 36' RT. 169+70 - Elev. 306.13

PLATE 1 - PLAN-PROFILE
 ASHLEY & EMER CO. INC. P.E.
 P.E. No. 2487-C

FAIRFIELD
 Project No 53(5)
 Sheet 7 of 22