

PLAN  
 DATE: 1/28/27  
 DRAWN BY: M. J. MURPHY  
 CHECKED BY: N.L.S.F.  
 PROJECT: VASSAR PARTLOW  
 SHEET: 22 OF 27

PROFILE  
 DATE: 1/28/27  
 DRAWN BY: M. J. MURPHY  
 CHECKED BY: N.L.S.F.  
 PROJECT: VASSAR PARTLOW  
 SHEET: 22 OF 27

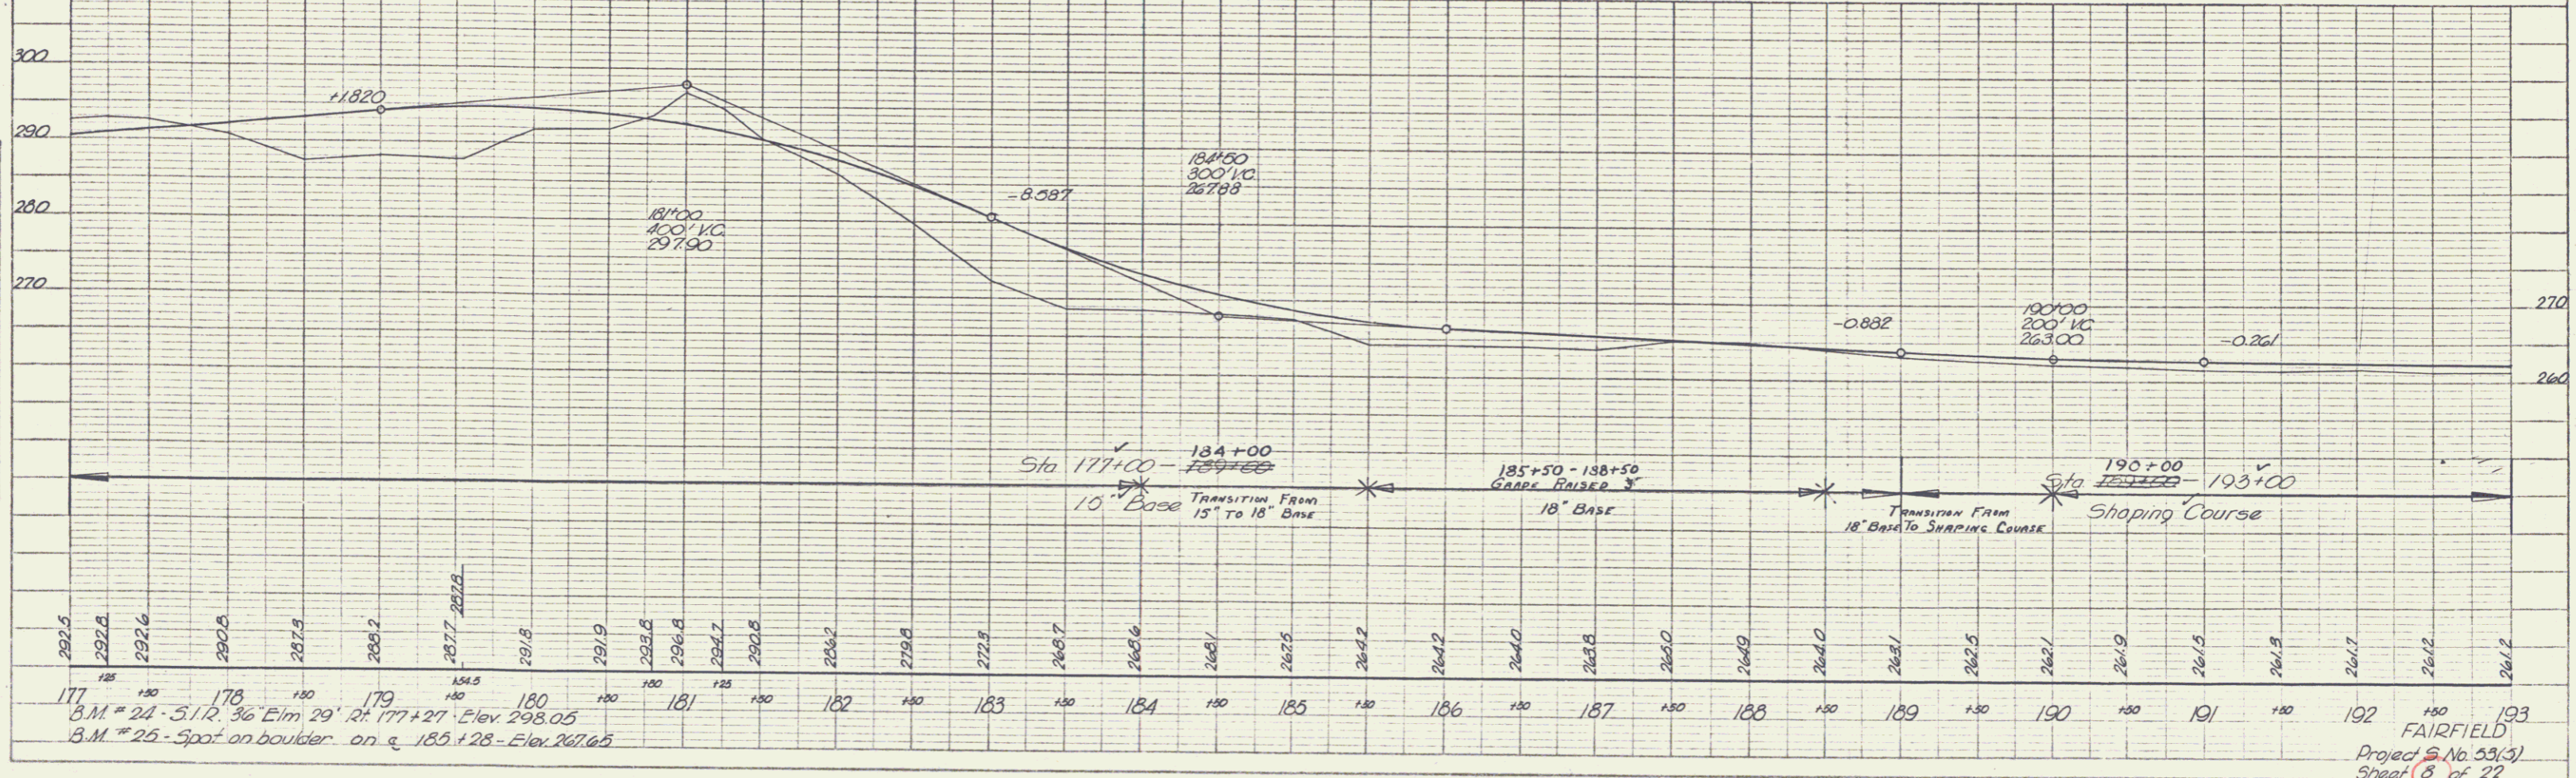
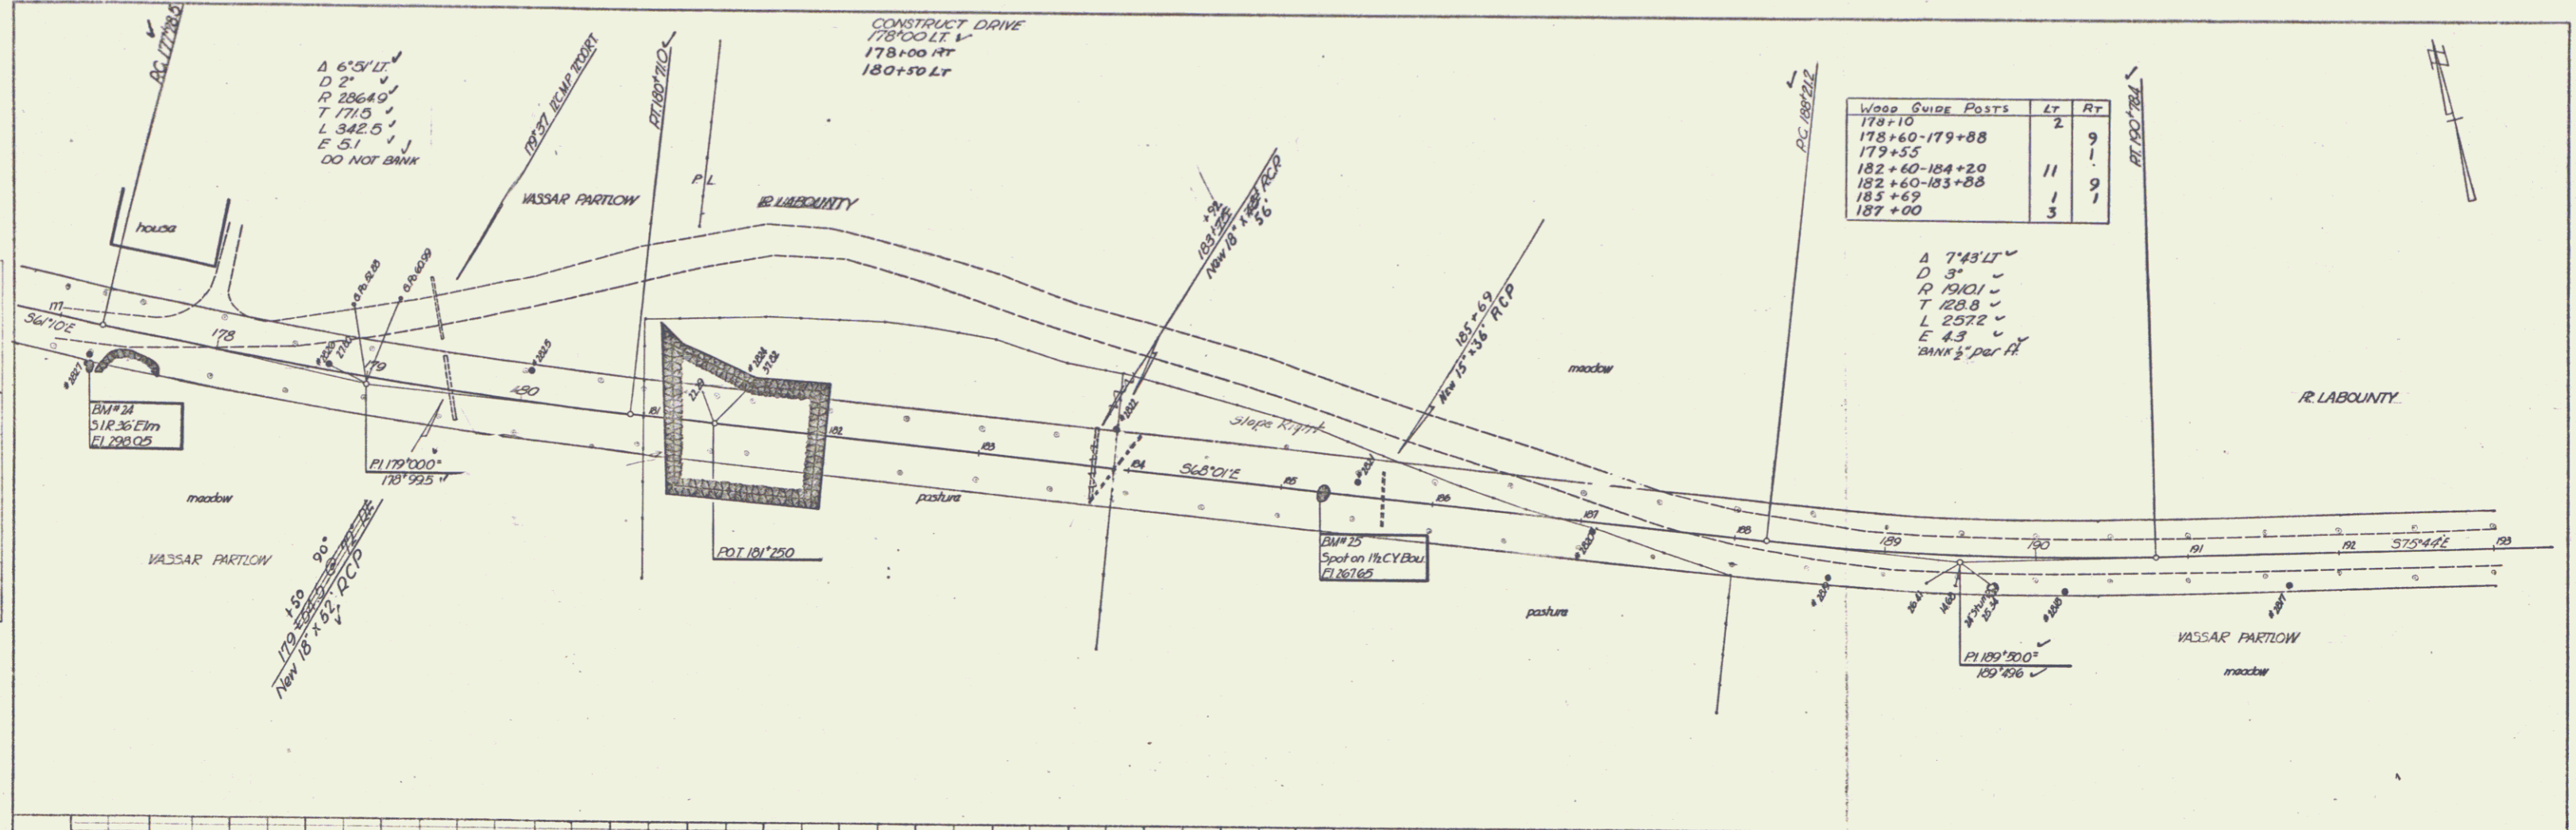


PLATE 1 - PLAN PROFILE & P.R.R.L. STATIONS  
 NEW YORK STATE DEPARTMENT OF TRANSPORTATION  
 BUREAU OF HIGHWAYS  
 1927

FAIRFIELD  
 Project No. 33(3)  
 Sheet 8 of 27  
 3