

PLAN  
 OPERATOR: Linn Murray  
 DATE: 1/18/19  
 NOTE BOOK: FAIRFIELD COUNTY  
 BY: NLS, J.E.

PROFILE  
 PLOTTED: Linn Murray  
 DATE: 1/18/19  
 NOTE BOOK: FAIRFIELD COUNTY  
 BY: NLS, J.E.

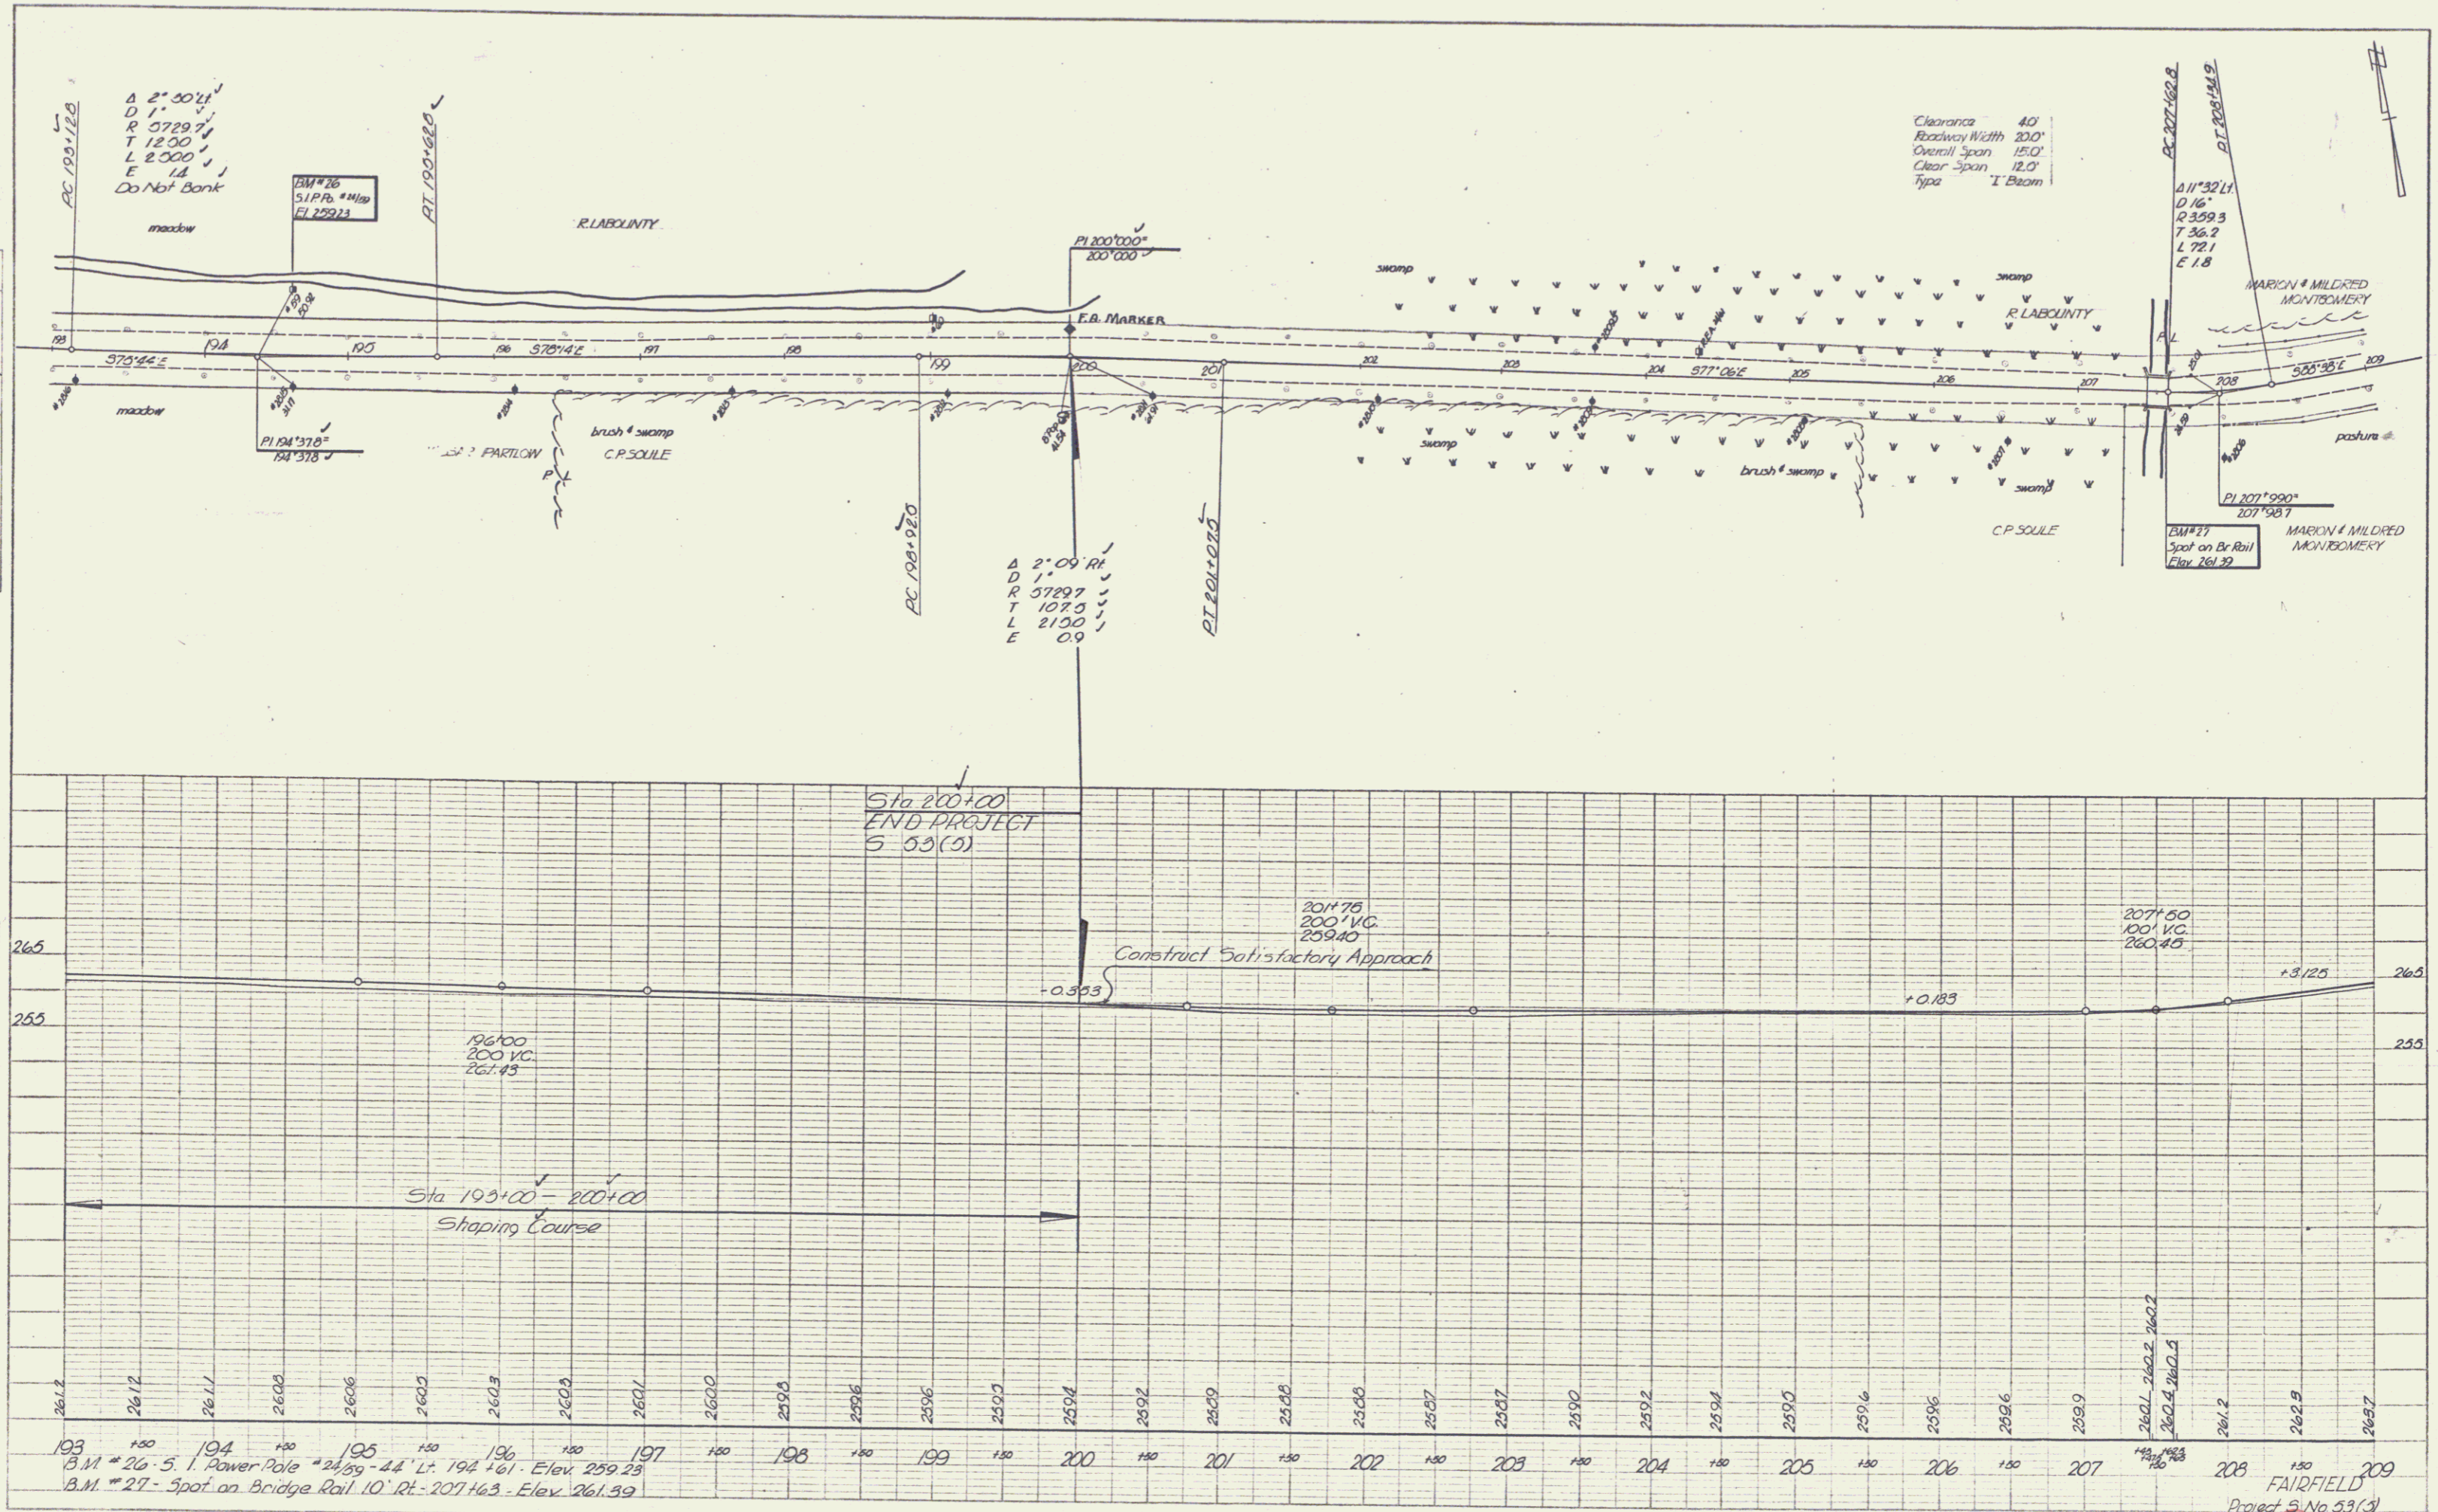


PLATE 1 - PLAN PROFILE D. P. & R. E. STINARD  
 FAIRFIELD COUNTY, NEW YORK  
 P. O. BOX 148, FAIRFIELD, N.Y.

FAIRFIELD  
 Project No. 53(3)  
 Sheet 9 of 22