


INDEX OF SHEETS

- 1 - TITLE
- 2 - ELEVATION
- 3 - DETAIL
- 4 - LAYOUT & PROFILE

List of Standards
 E3 12-15-78 R
 SCB-01-75 9-14-81 R

STATE OF VERMONT
 AGENCY OF TRANSPORTATION

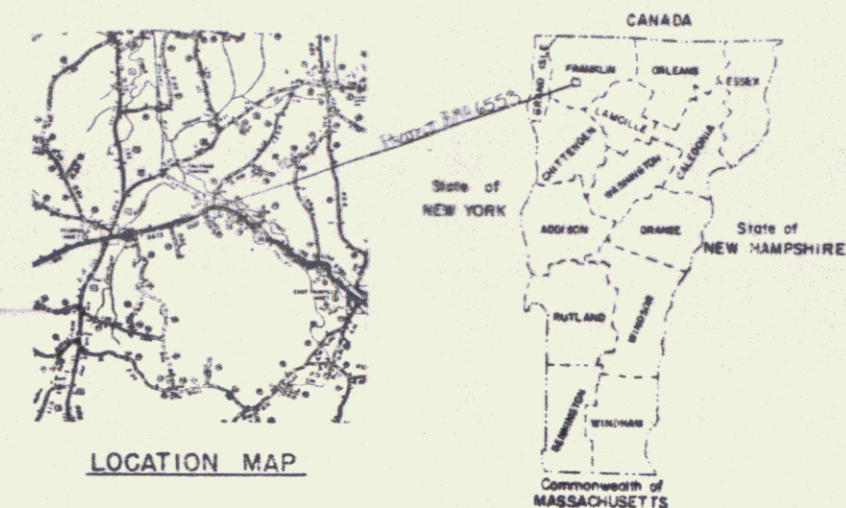

R.O.W. PLANS

PROPOSED IMPROVEMENT
 BRIDGE PROJECT

TOWN OF FAIRFIELD
 COUNTY OF FRANKLIN

Pin # 99R959

ROUTE NO: VT RTE. 36 BRIDGE NO: 6

PROJECT LOCATION: PROJECT IS LOCATED 0.25 MI. EAST OF FAIRFIELD VILLAGE ON VT RTE 36

PROJECT DESCRIPTION: PROJECT CONSISTS OF THE CONSTRUCTION OF A CONCRETE GRAVITY WALL TO BE DOWELLED TO LEDGE ALONG WITH JAILING. ELEVATION NECESSARY FOR BACKFILL OF STONE FILL.

LENGTH OF STRUCTURE:	82.00 FEET
LENGTH OF PARTICIPATION ROADWAY:	0.00 FEET
LENGTH OF NON-PARTICIPATION ROADWAY:	0.00 FEET
LENGTH OF PROJECT:	82.00 FEET
LENGTH OF R.O.W. PROJECT:	100.00 FEET

GENERAL NOTES

1. GRAVITY WALL TO BE DOWELLED TO SOLID LEDGE, APPROXIMATE ELEVATION 470.00.
2. QUANTITIES ARE ESTIMATED FOR LEDGE ELEVATION OF 470. LEDGE PROFILE ALONG GRAVITY WALL WILL BE TAKEN BY THE ENGINEER, AND QUANTITIES ADJUSTED ACCORDINGLY.
3. CONTRACTOR'S ATTENTION IS CALLED TO STANDARD SHEET SCB-01-75. NOTES OF PARTICULAR CONCERN ARE # 4, # 6, # 7, # 8, & # 16.


BEGIN R.O.W. PROJECT
 MA 3527 STA. 8+50 (58' LT.)

END R.O.W. PROJECT
 MA 3527 STA. 9+50 (42' LT.)

- CONVENTIONAL SIGNS
- COUNTY LINE
 - TOWN LINE
 - LIMITS OF ACCESS
 - POINT OF ACCESS
 - FENCE LINE
 - STONE WALL
 - TRAVELED HWY
 - GUARD RAIL
 - RAILROAD
 - SURVEY LINE
 - CULVERT
 - POWER POLE
 - TELEPHONE POLE
 - TREES
 - CONTROL OF ACCESS
 - PROPERTY LINE
 - R.O.W. TAKING LINE
 - SLOPE RIGHTS
 - TOP OF CUT
 - TOE OF SLOPE

DATUM

VERTICAL	_____
HORIZONTAL	_____

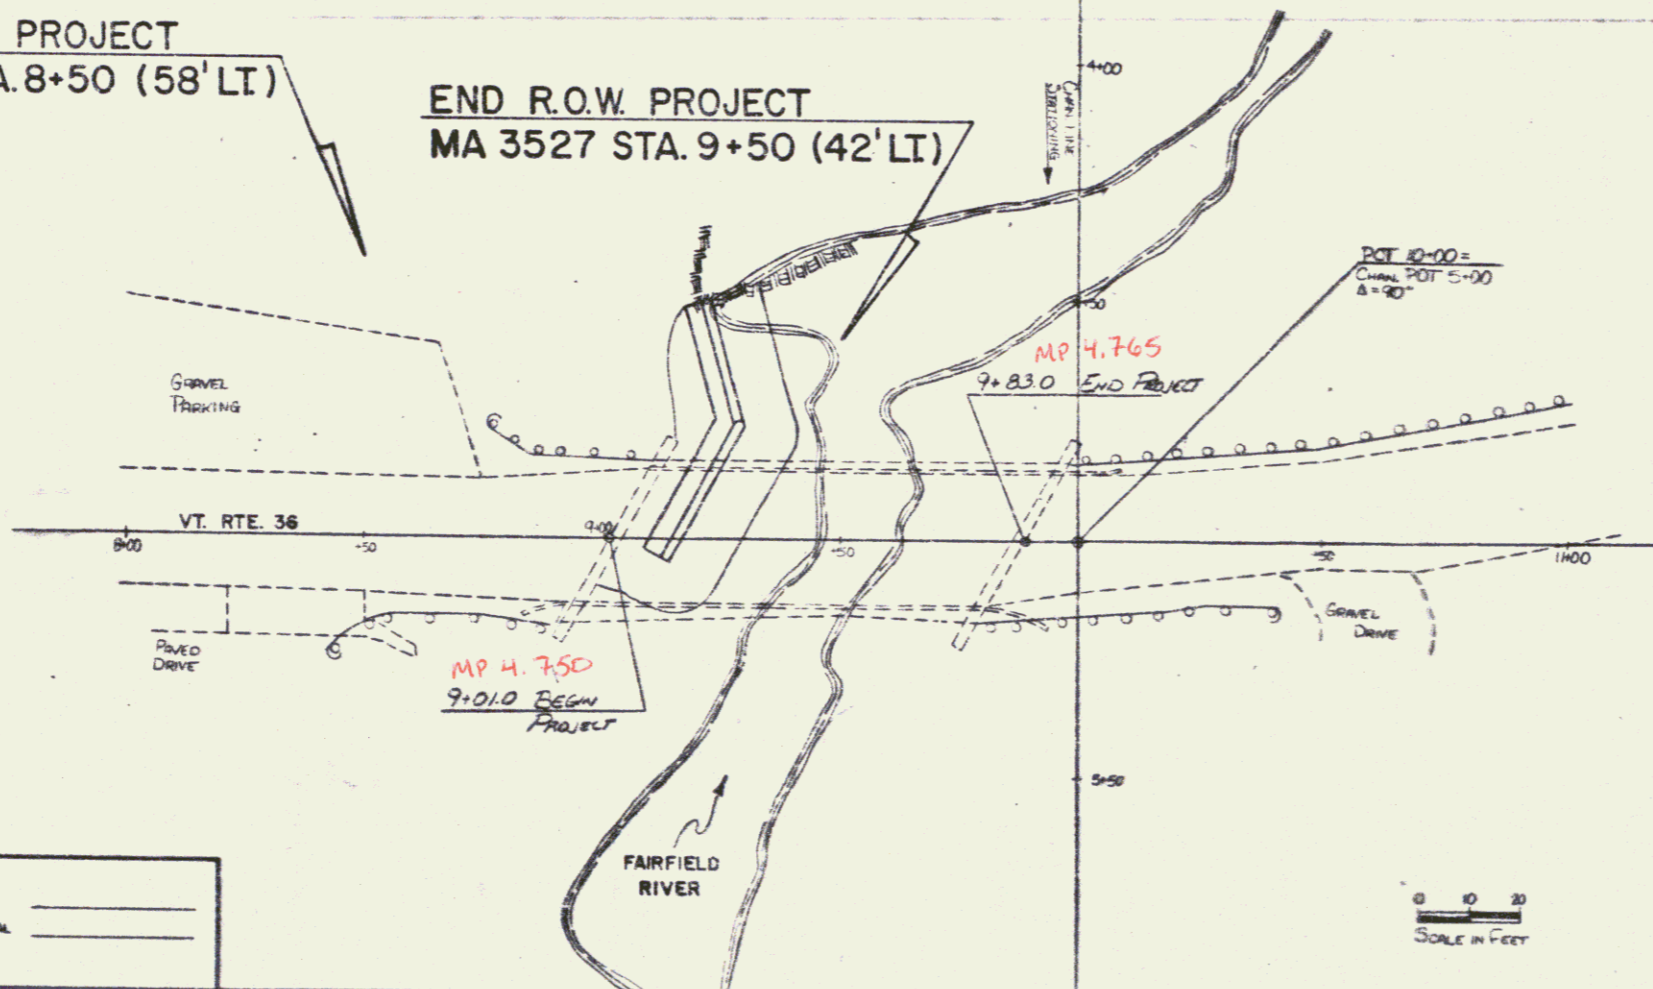

SCALE IN FEET

These plans are subject to such engineering changes as may be required by the Federal Highway Administration or the Director of Engineering and Construction.

Construction is to be carried on in accordance with these plans and the Standard Specifications for Highway and Bridge Construction dated March, 1976, as approved by the Federal Highway Administration on October 27, 1976 for use on this project, including all subsequent revisions and such revised specifications and special provisions as are incorporated in these plans.

APR 10 1987

SUBMITTED BY ORDER OF THE STATE TRANSPORTATION BOARD	
APPROVED: <i>[Signature]</i>	DATE: 6-6-85
DIRECTOR OF ENGINEERING AND CONSTRUCTION	
APPROVED: <i>[Signature]</i>	DATE: 6-5-85
CHIEF, PROPERTY ADMINISTRATION	
PROJECT: FAIRFIELD	PROJECT NO. MA 3527
SHEET 1 OF 4	

STATE OF VERMONT
AGENCY OF TRANSPORTATION
RIGHT-OF-WAY PLANS
DETAIL SHEET

TABLE OF PROJECT PROPERTY ACQUISITION

PARCEL NO.	GRANTOR	SHEET NO.	BEGINNING STATION	ENDING STATION	TAKING	REM.	RIGHTS	TITLE TAKEN	DATE	TOWN OR CITY RECORDED	BK.	PG.	REMARKS
1	HOWEGAN, RICHARD J. & KATHLEEN A.	4	8+50 LI. 9+17 LI. 9+22 LI.	9+50 LI. 9+24 LI. 9+35 LI.			CONST. EASE. (T) (800 S.F.s) INSTALL & MAINTAIN (P) CHANNEL (P) (72 S.F.s)	WDOE.	7-19-85	FAIRFIELD	50	88-89	CONCRETE RETAINING WALL
2	NEW ENGLAND TELEPHONE & TELEGRAPH CO.												UTILITY
3	CENTRAL VERMONT PUBLIC SERVICE CORP.												UTILITY

TABLE OF REVISIONS

REVISION NO.	SHEET NO.	DESCRIPTION OF REVISION	DATE	MADE BY	APPROVED BY

MADE BY: B.A.M. DATE 8-5-85
CHECKED BY: L.W.B. DATE 8-5-85

DR. RT - DRAINAGE RIGHT
DIT. RT - DITCHING RIGHT
CH. RT - CHANNEL RIGHT
DRIVE RT - DRIVE RIGHT
CUL. RT - CULVERT RIGHT
⊙ - DEMOLITION OR REMOVAL
W - WATER SOURCES

----- PRESENT R.O.W.
// --- // TAKING WITHOUT ACCESS
// P --- // TAKING WITHOUT ACCESS ALONG PROPERTY LINES
----- TAKING WITH ACCESS
(P) PERMANENT EASEMENT
(T) TEMPORARY EASEMENT

LEGEND
----- CONST. EASE. ----- CONST. EASEMENT
SR ----- SR ----- SLOPE RIGHTS
P ----- P ----- PROPERTY LINE
----- Δ ----- Δ ----- TOP OF CUT
O ----- O ----- O ----- TOE OF SLOPE

APPROVED Laura W. Blinn DATE 6/22/85
CHIEF OF PLANS & TITLES


NOV 13 1985
PROJECT FAIRFIELD
NO. MA 3527
SHEET 3 OF 4

BEGIN R.O.W. PROJECT
MA 3527 STA. 8+50 (58' LT.)

END R.O.W. PROJECT
MA 3527 STA. 9+50 (42' LT.)

PLAN	DESIGNED BY	DATE
	CHECKED BY	DATE
PROFILE	DESIGNED BY	DATE
	CHECKED BY	DATE

PROFILE	DESIGNED BY	DATE
	CHECKED BY	DATE
PLAN	DESIGNED BY	DATE
	CHECKED BY	DATE

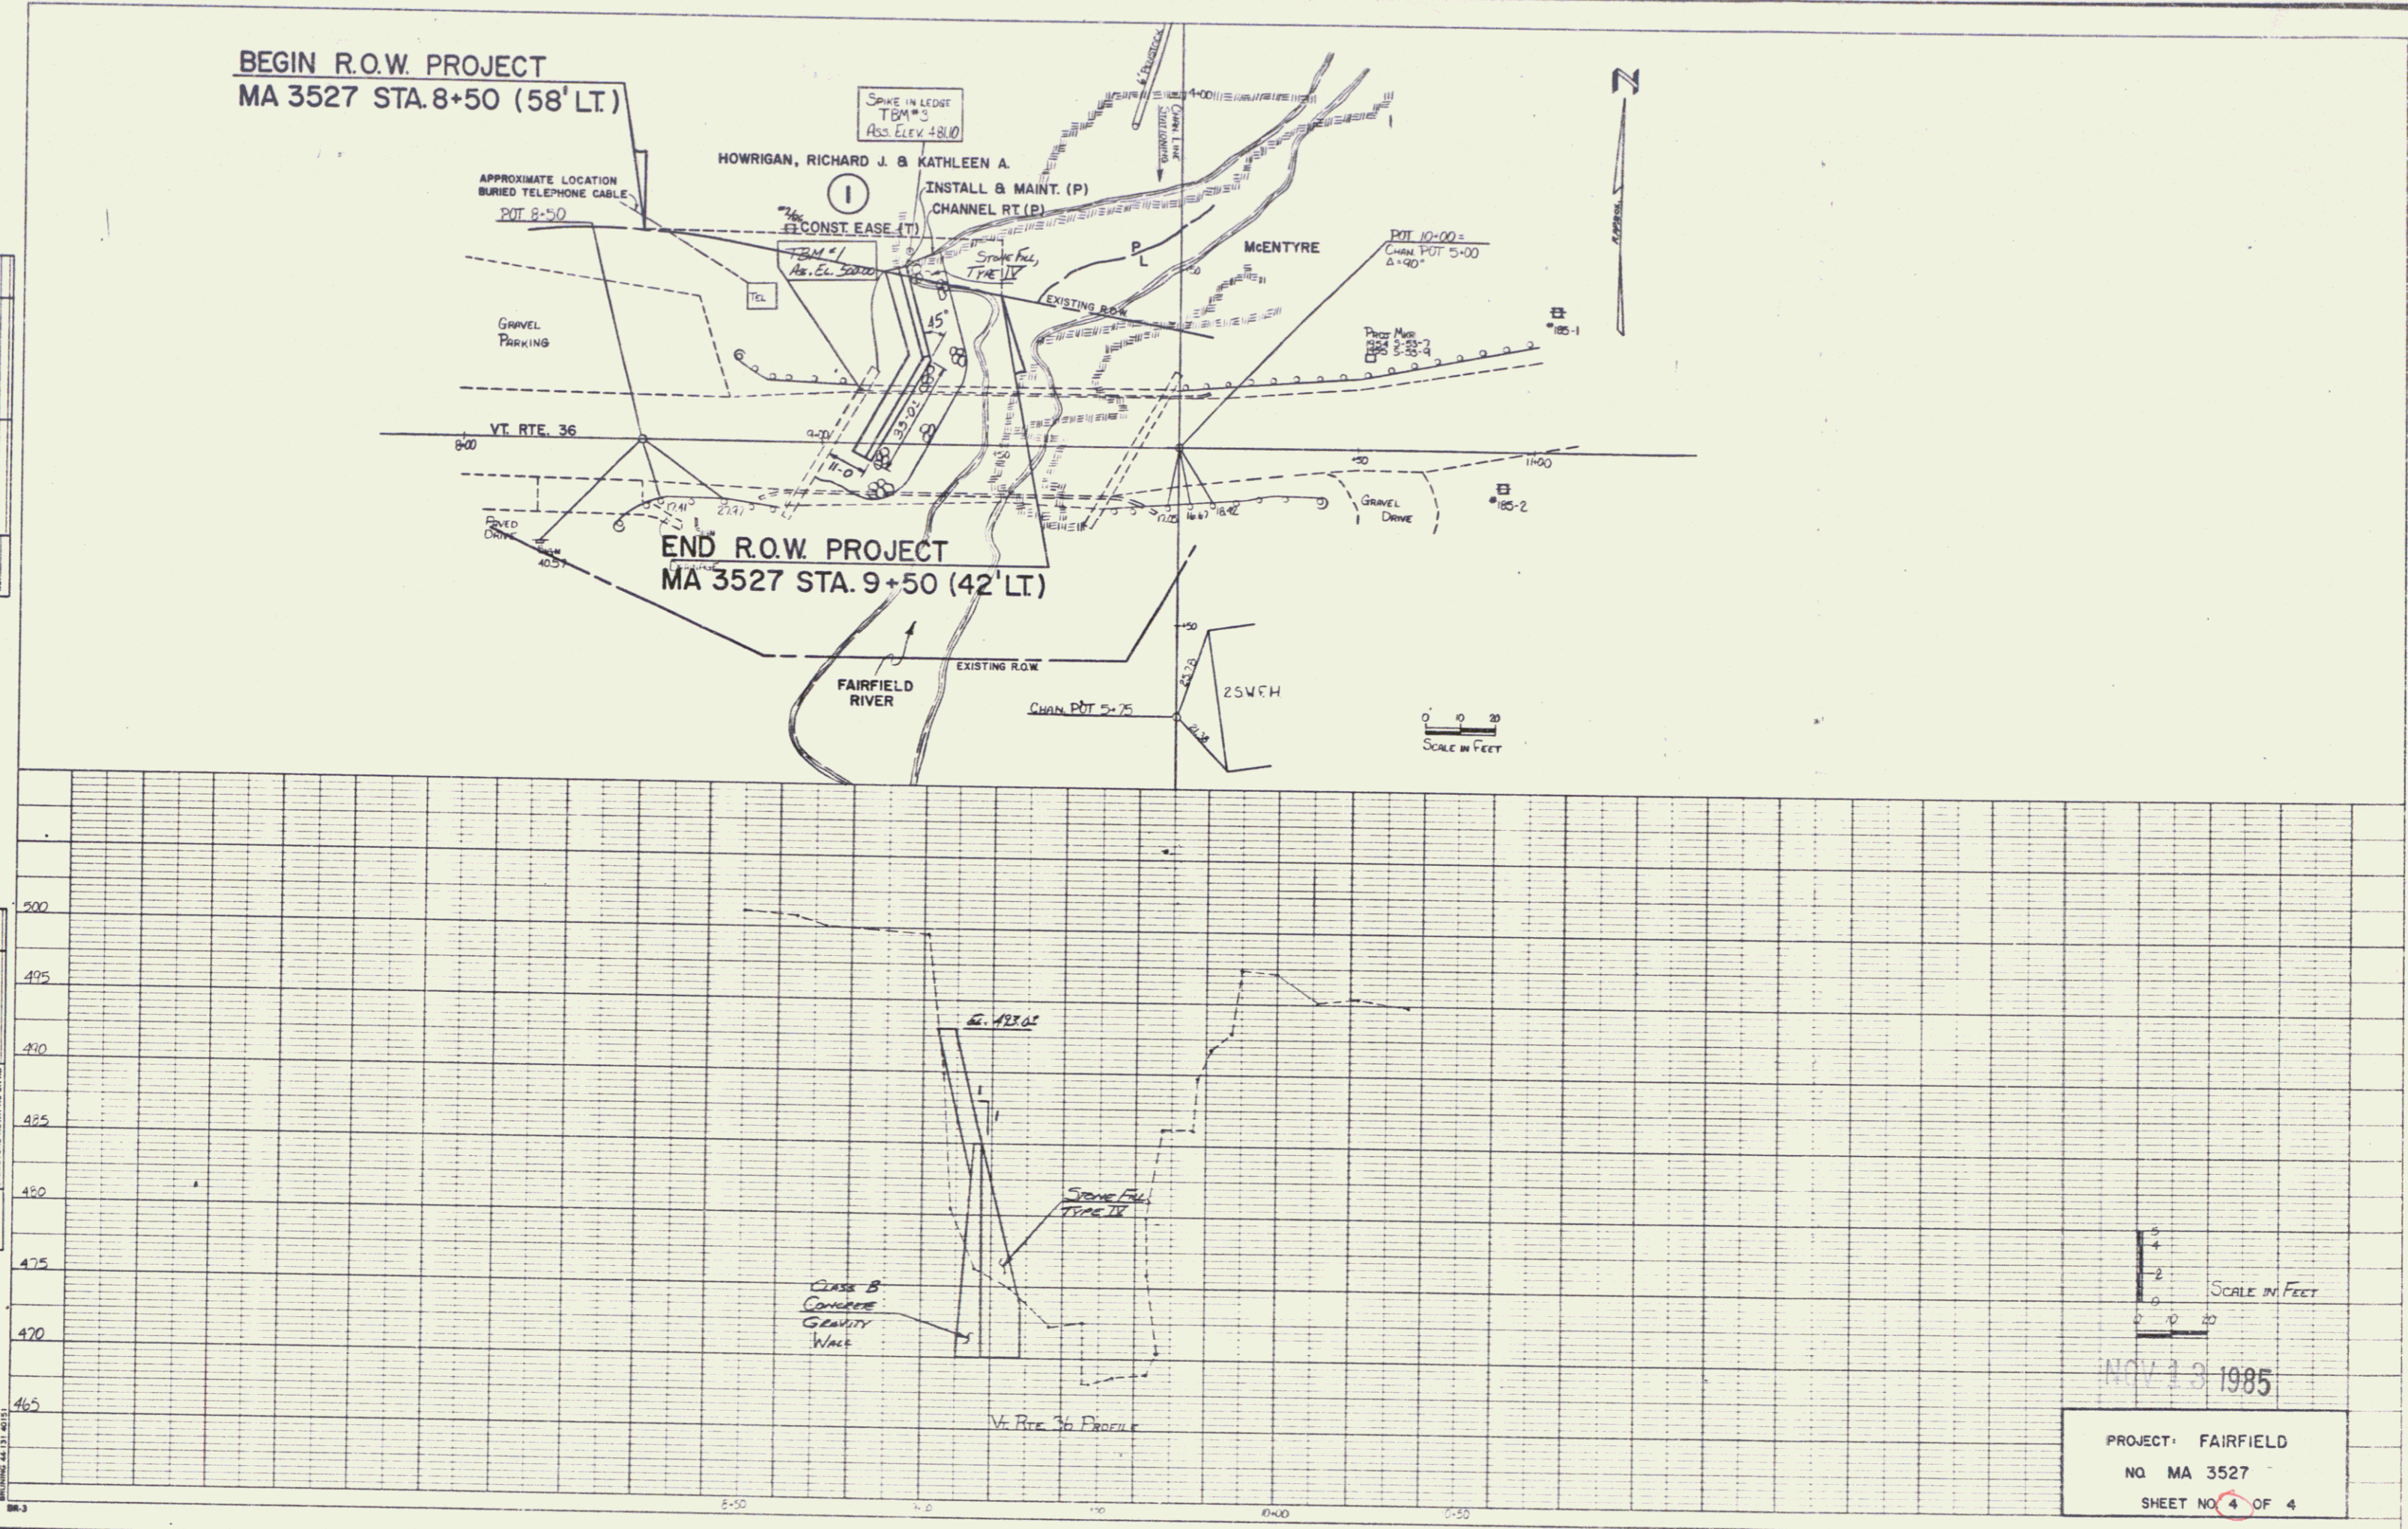

020

3

NOV 23 1985
PROJECT: FAIRFIELD
NO MA 3527
SHEET NO. 4 OF 4