
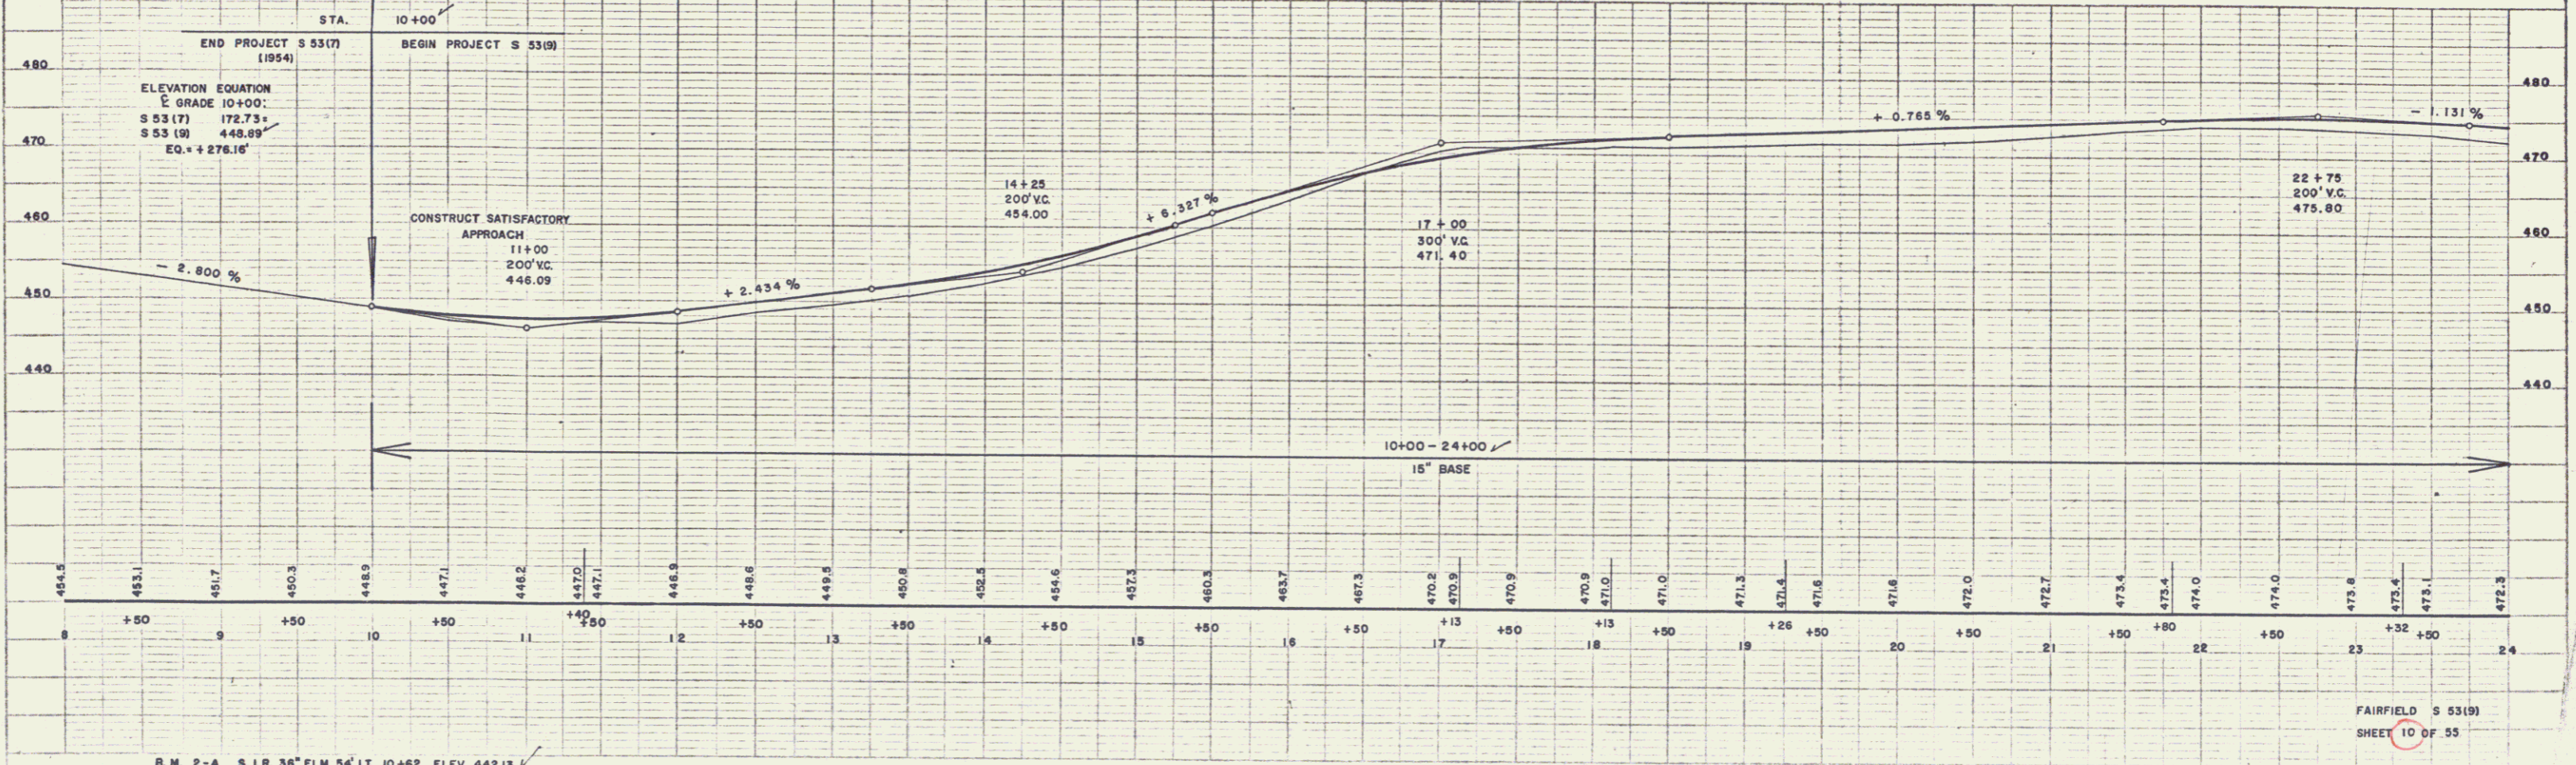


SPRAULING  
WESTER-MARTIN INC. 10-54  
NOTE: ALL DIMENSIONS SHOWN ARE AS SHOWN UNLESS OTHERWISE SPECIFIED.  
SCALE: AS SHOWN

SPRAULING  
WESTER-MARTIN INC. 10-54  
NOTE: ALL DIMENSIONS SHOWN ARE AS SHOWN UNLESS OTHERWISE SPECIFIED.  
SCALE: AS SHOWN

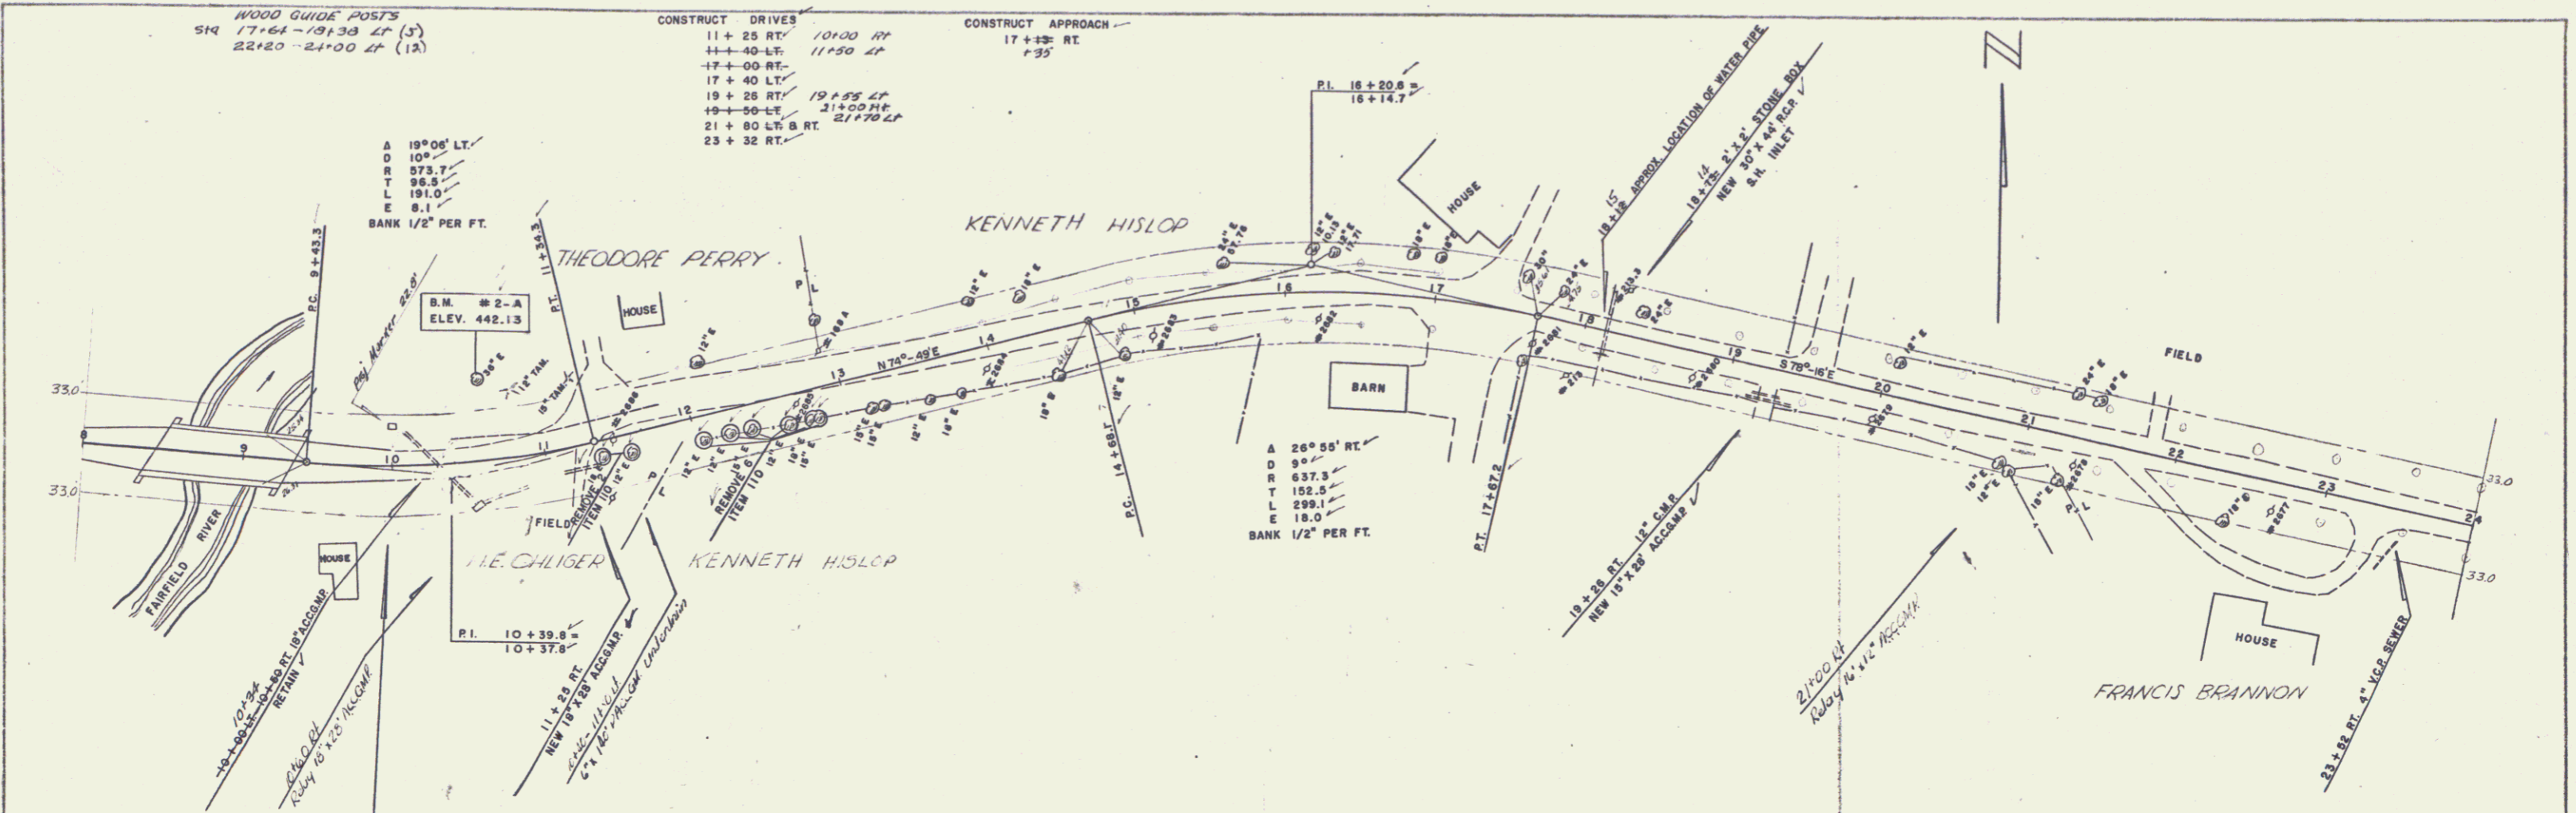

B.M. 2-A S.I.R. 36" ELM 54" LT. 10+62 ELEV. 442.13

FAIRFIELD S 53(9)  
SHEET 10 OF 55

PLATE 1 - PLAN-PROFILE C.P.A. & E. SHEPARD  
DESIGNED & DRAWN BY NEW HAVEN  
C.P.A. & E. SHEPARD  
NEW HAVEN, CONNECTICUT