
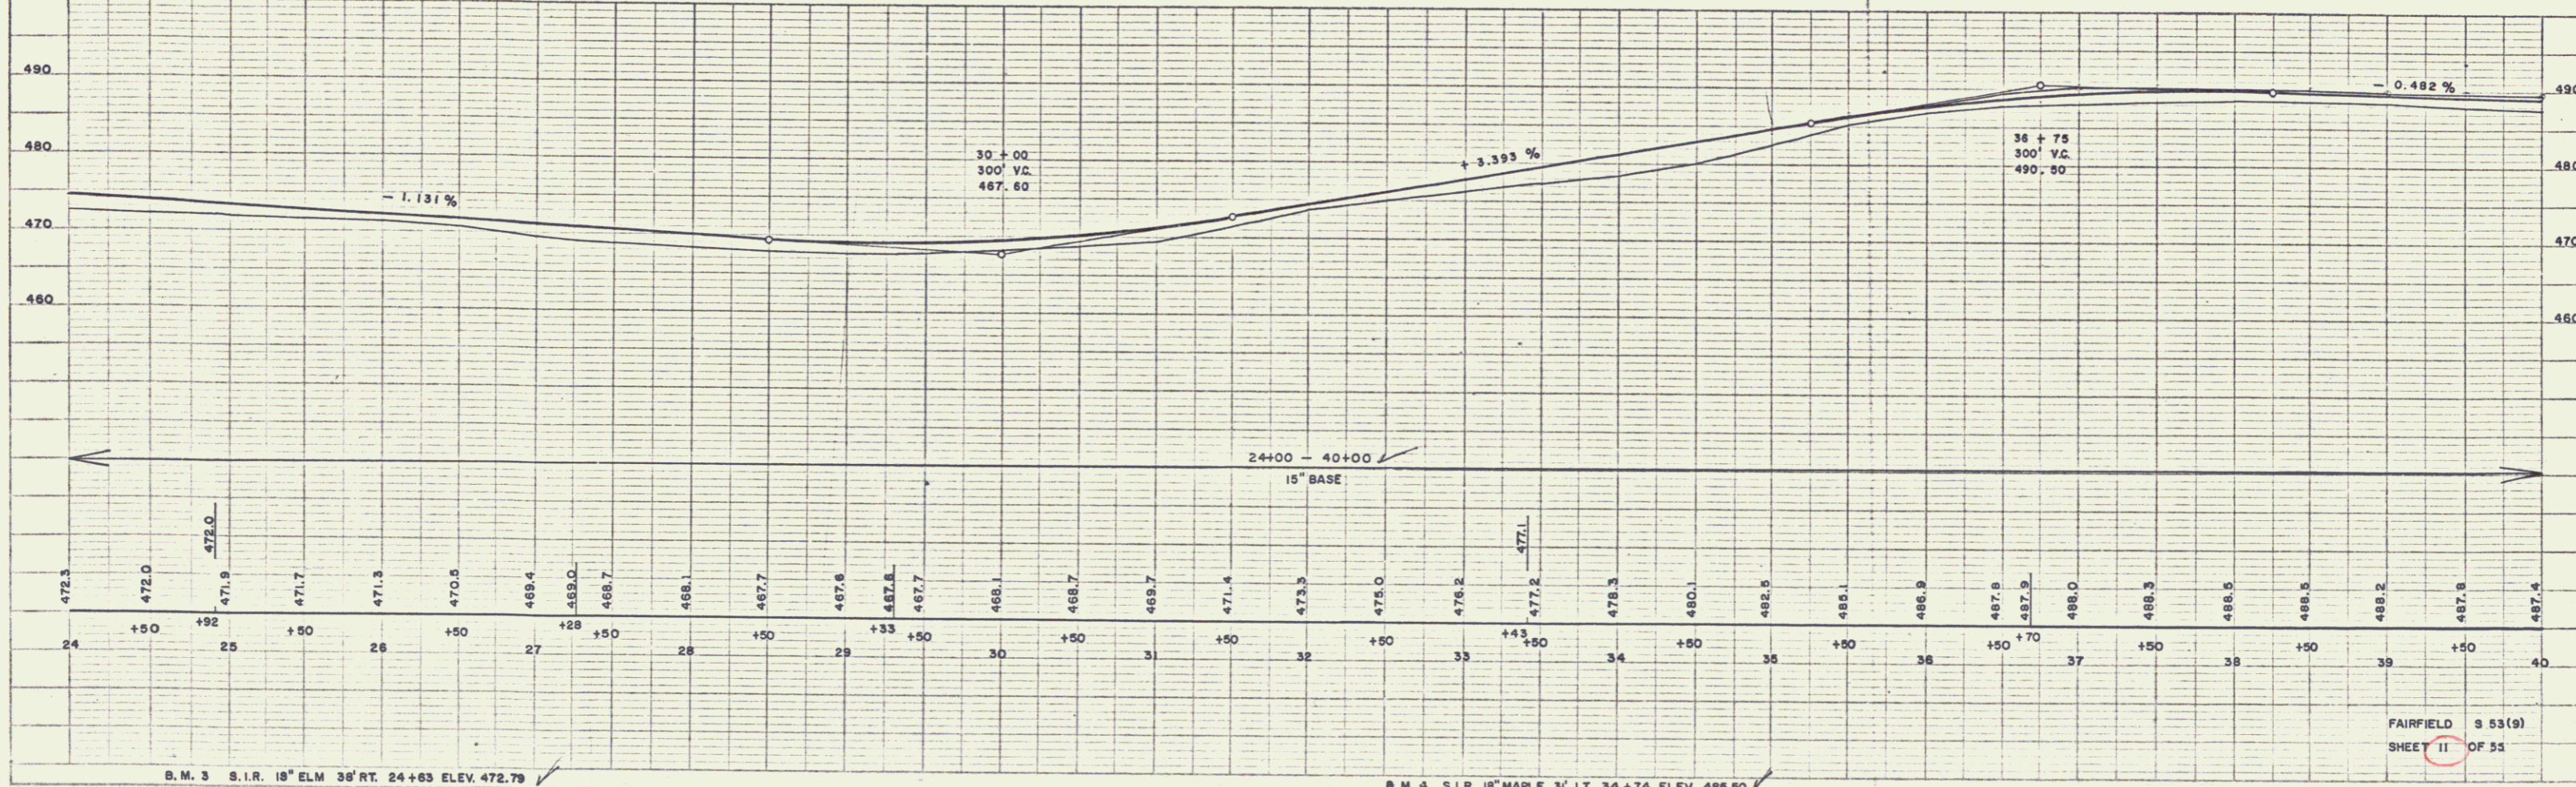


PLAN
 SHEET NO. 11
 PROJECT NO. 10-34
 DATE: 10/15/10
 DRAWN BY: J. J. MARTIN
 CHECKED BY: J. J. MARTIN
 SCALE: AS SHOWN

PLAN
 SHEET NO. 11
 PROJECT NO. 10-34
 DATE: 10/15/10
 DRAWN BY: J. J. MARTIN
 CHECKED BY: J. J. MARTIN
 SCALE: AS SHOWN

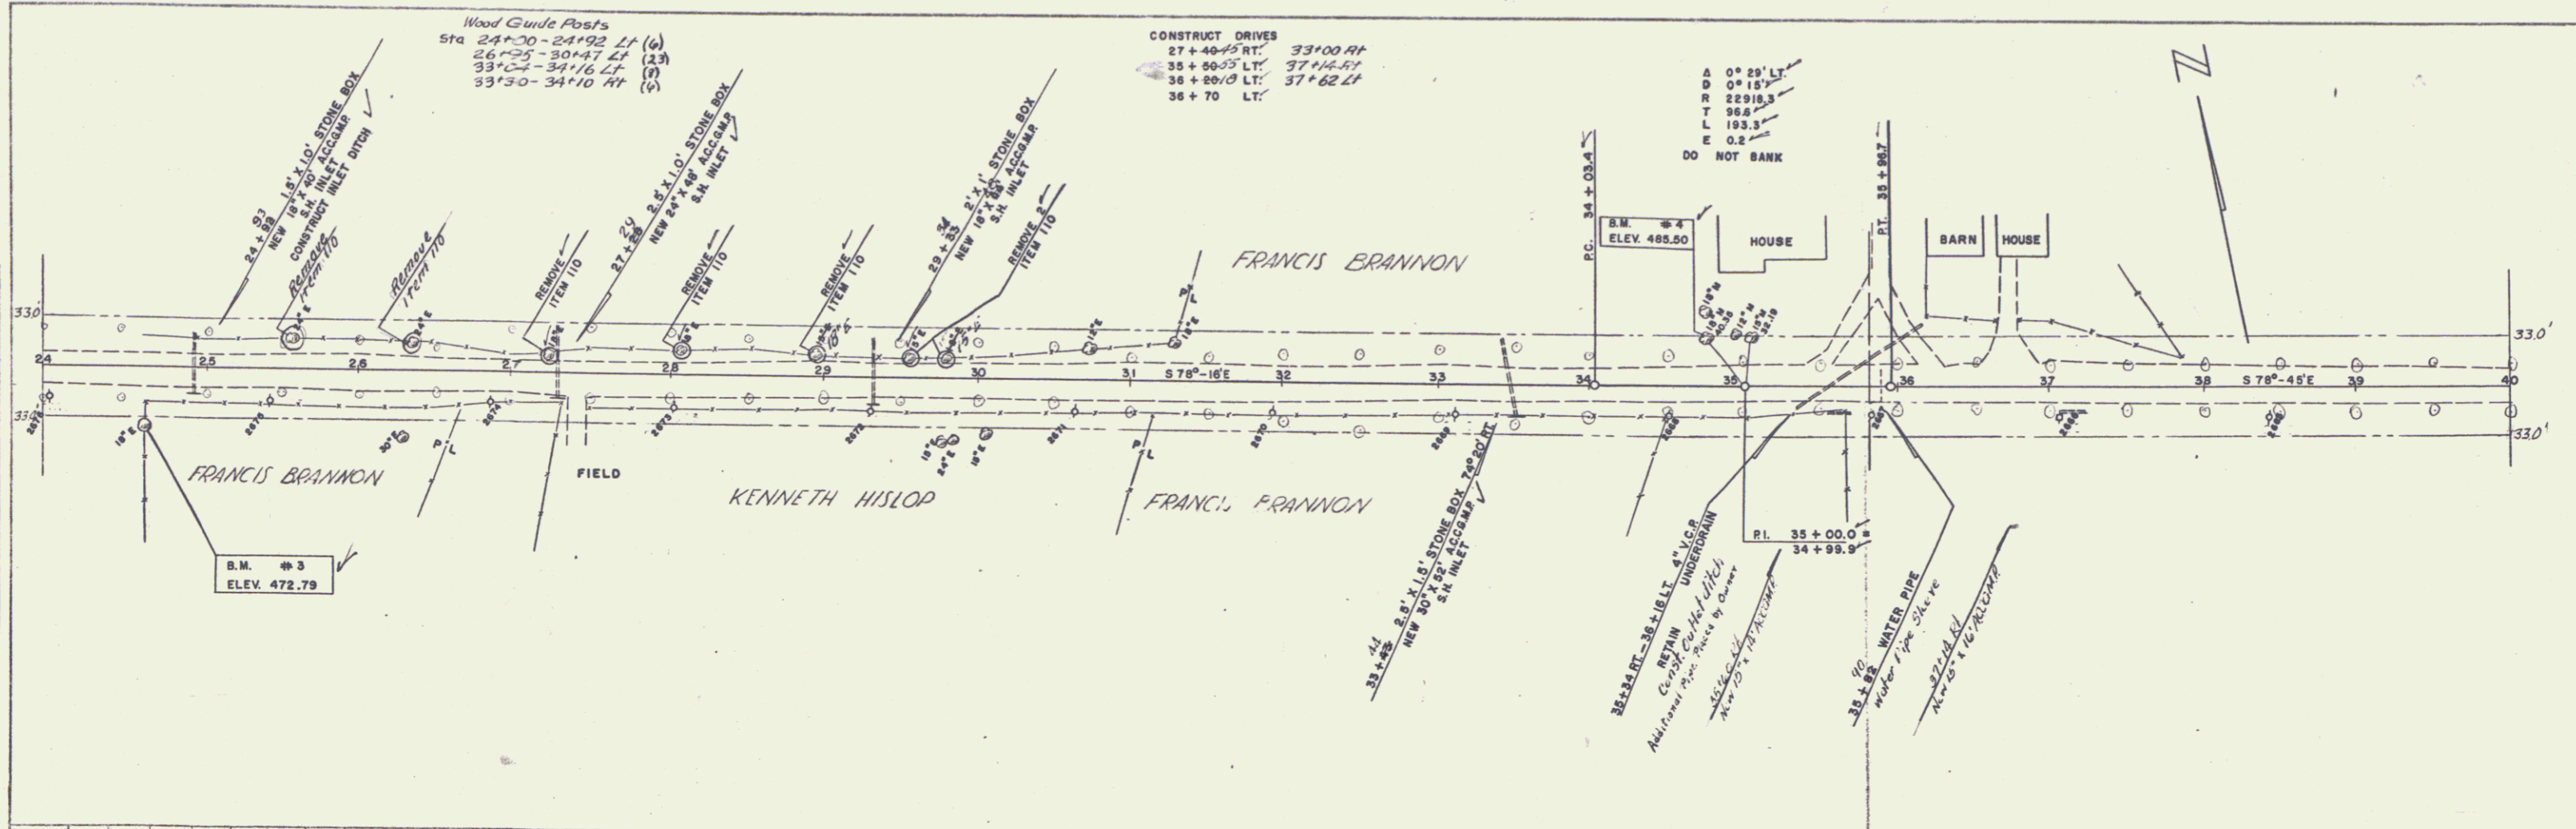

FAIRFIELD S 53(9)
 SHEET 11 OF 55

PLATE 1 - PLAN-PROFILE
 SHEET NO. 11
 PROJECT NO. 10-34
 DATE: 10/15/10
 DRAWN BY: J. J. MARTIN
 CHECKED BY: J. J. MARTIN
 SCALE: AS SHOWN

3