

NO. 8-54  
 BRANDING  
 RESISTER-MARTIN INC. 10-54  
 NOTE: INK MUST BE USED IN ALL DIMENSIONS.  
 NO. 10-54

NO. 8-54  
 DELANO  
 RESISTER-MARTIN INC. 10-54  
 NOTE: INK MUST BE USED IN ALL DIMENSIONS.  
 NO. 10-54

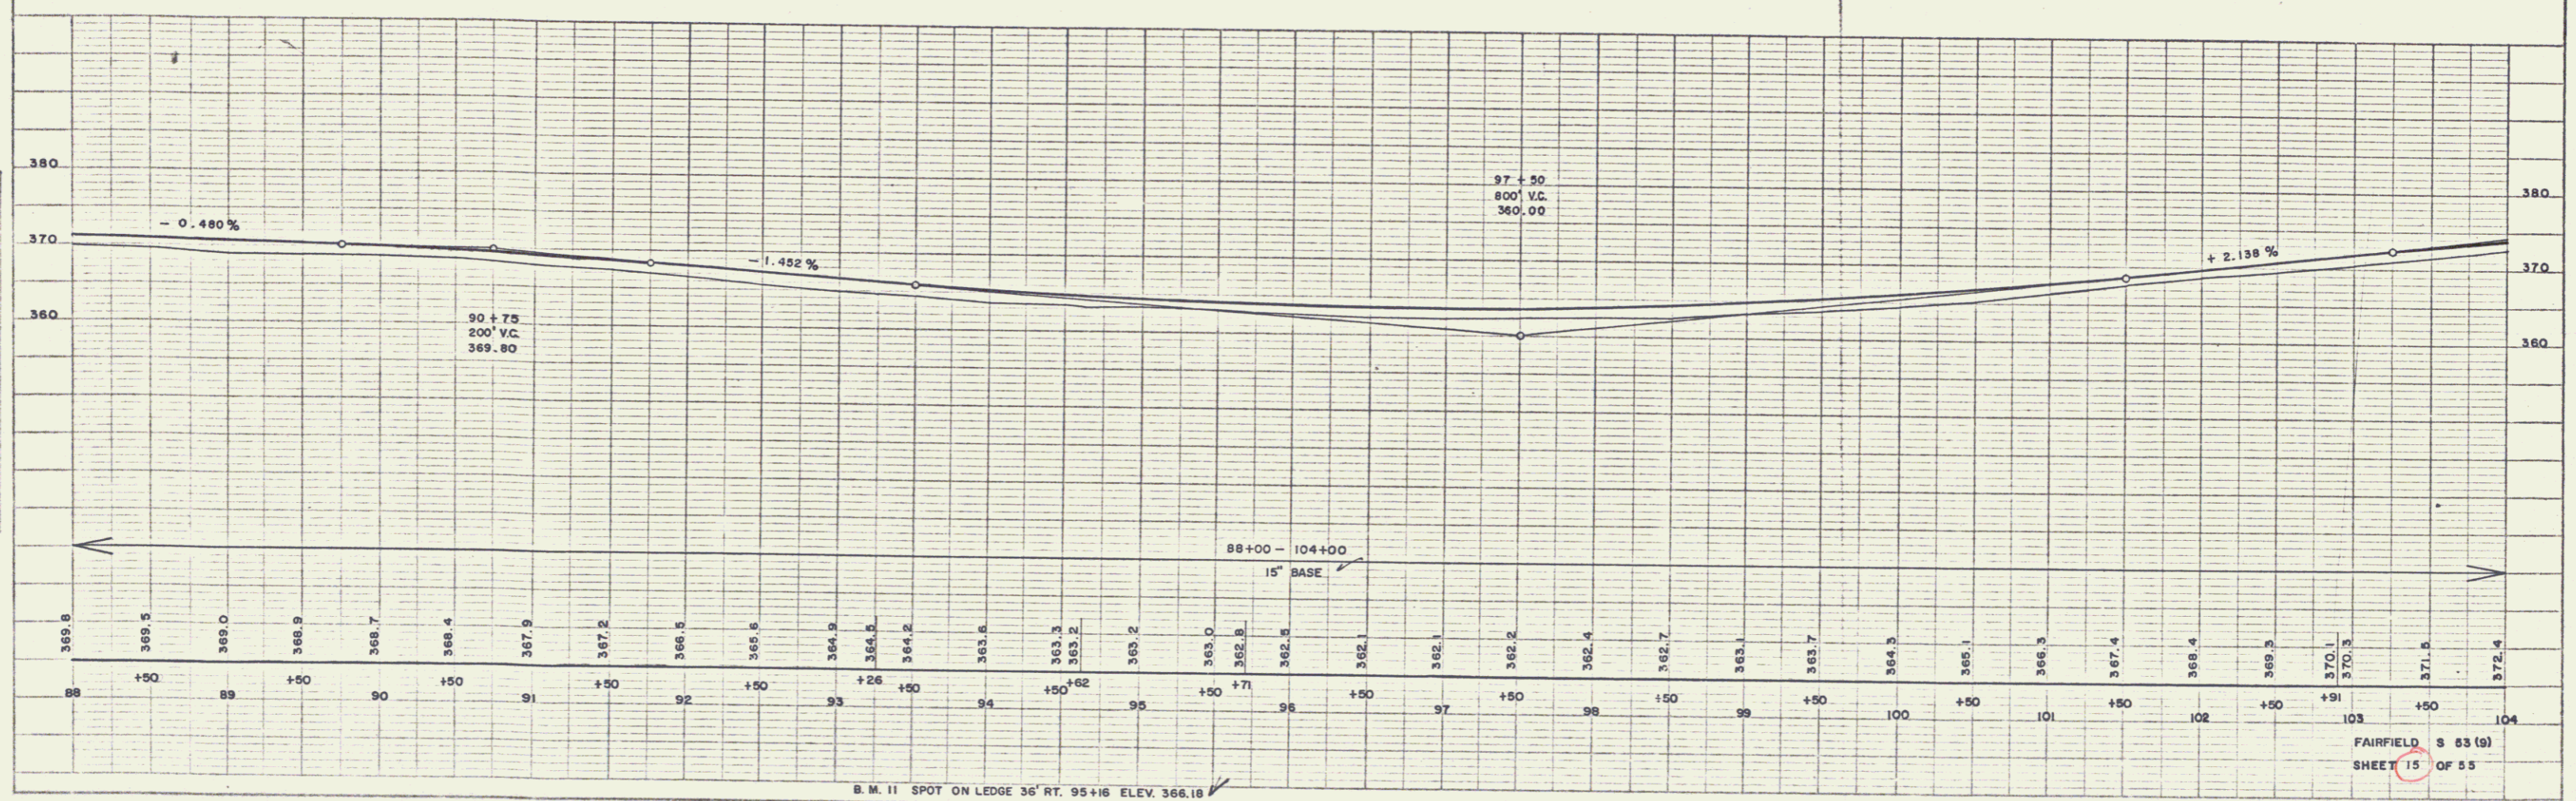
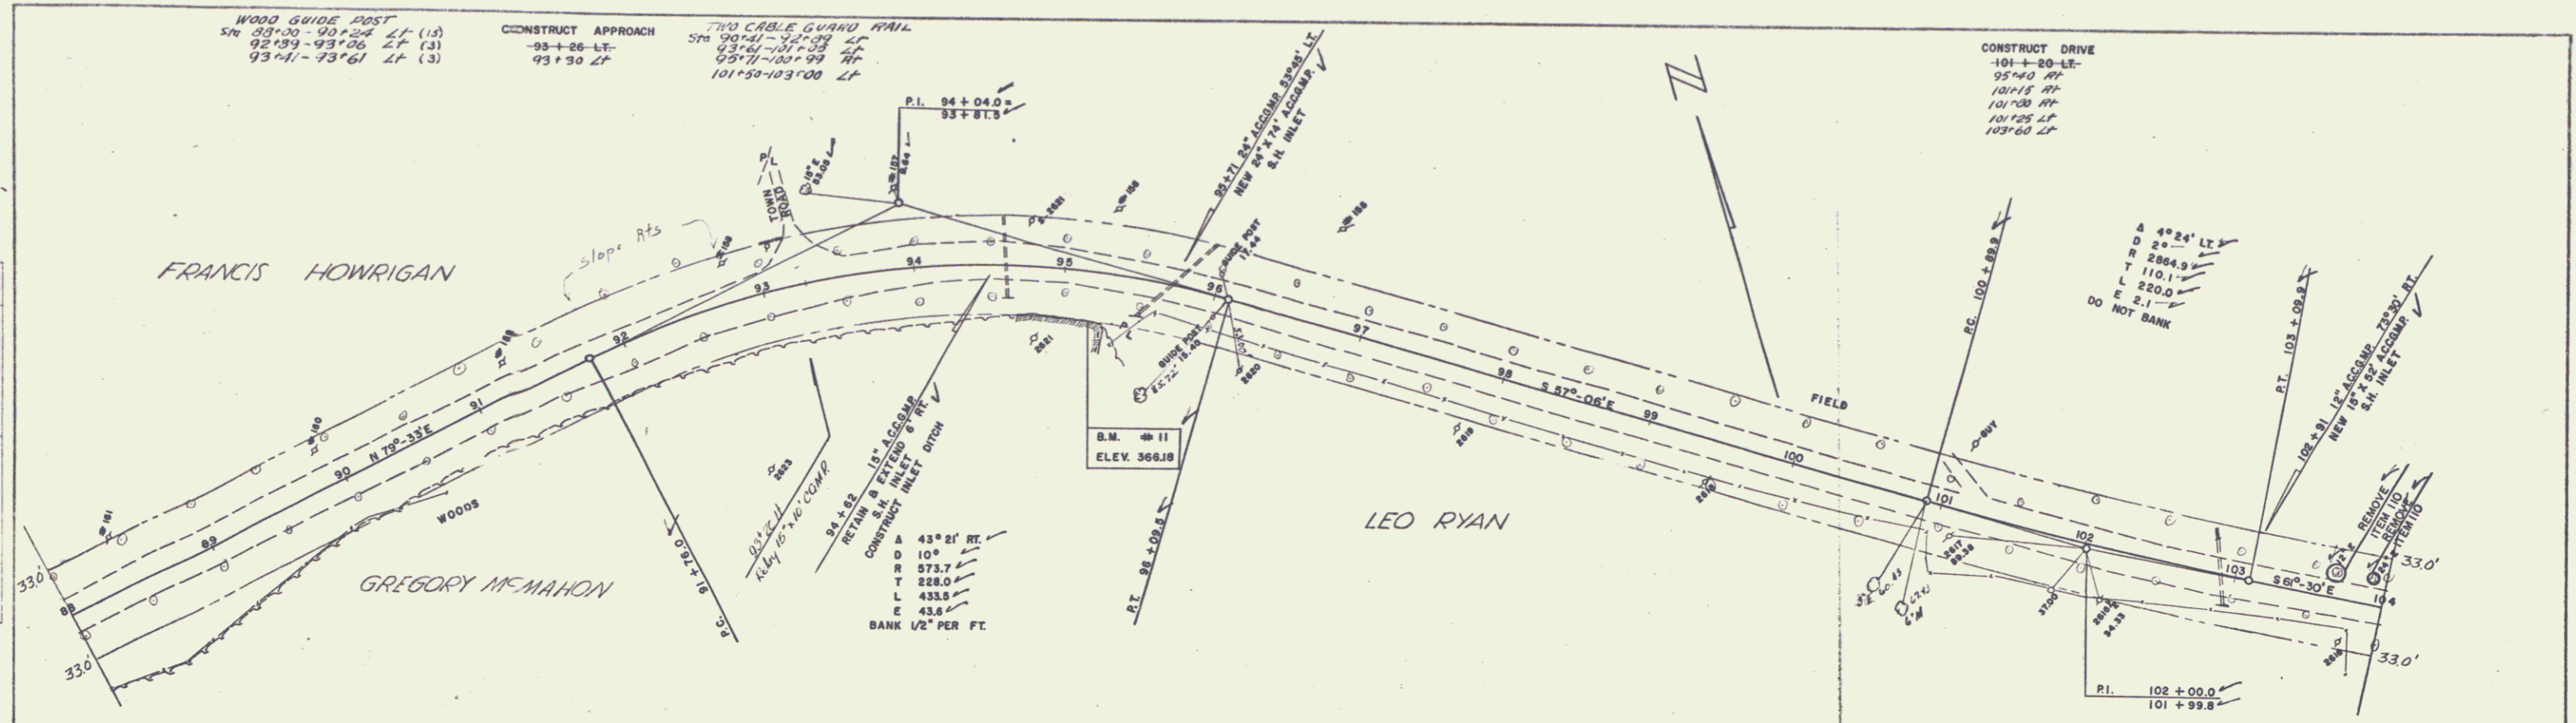


PLATE 1-7-FLY-PROFILE © P. M. & R. STANHOPE  
 400/TEL. & TYP. CO., NEW YORK  
 R. & E. Co. No. 345-12

FAIRFIELD S 53 (9)  
 SHEET 15 OF 55