

PLAN
 DELAND WEBSTER-MARTIN INC. 10-54
 DATE BOOK
 NO.

DELAND WEBSTER-MARTIN INC. 10-54
 DATE BOOK
 NO.

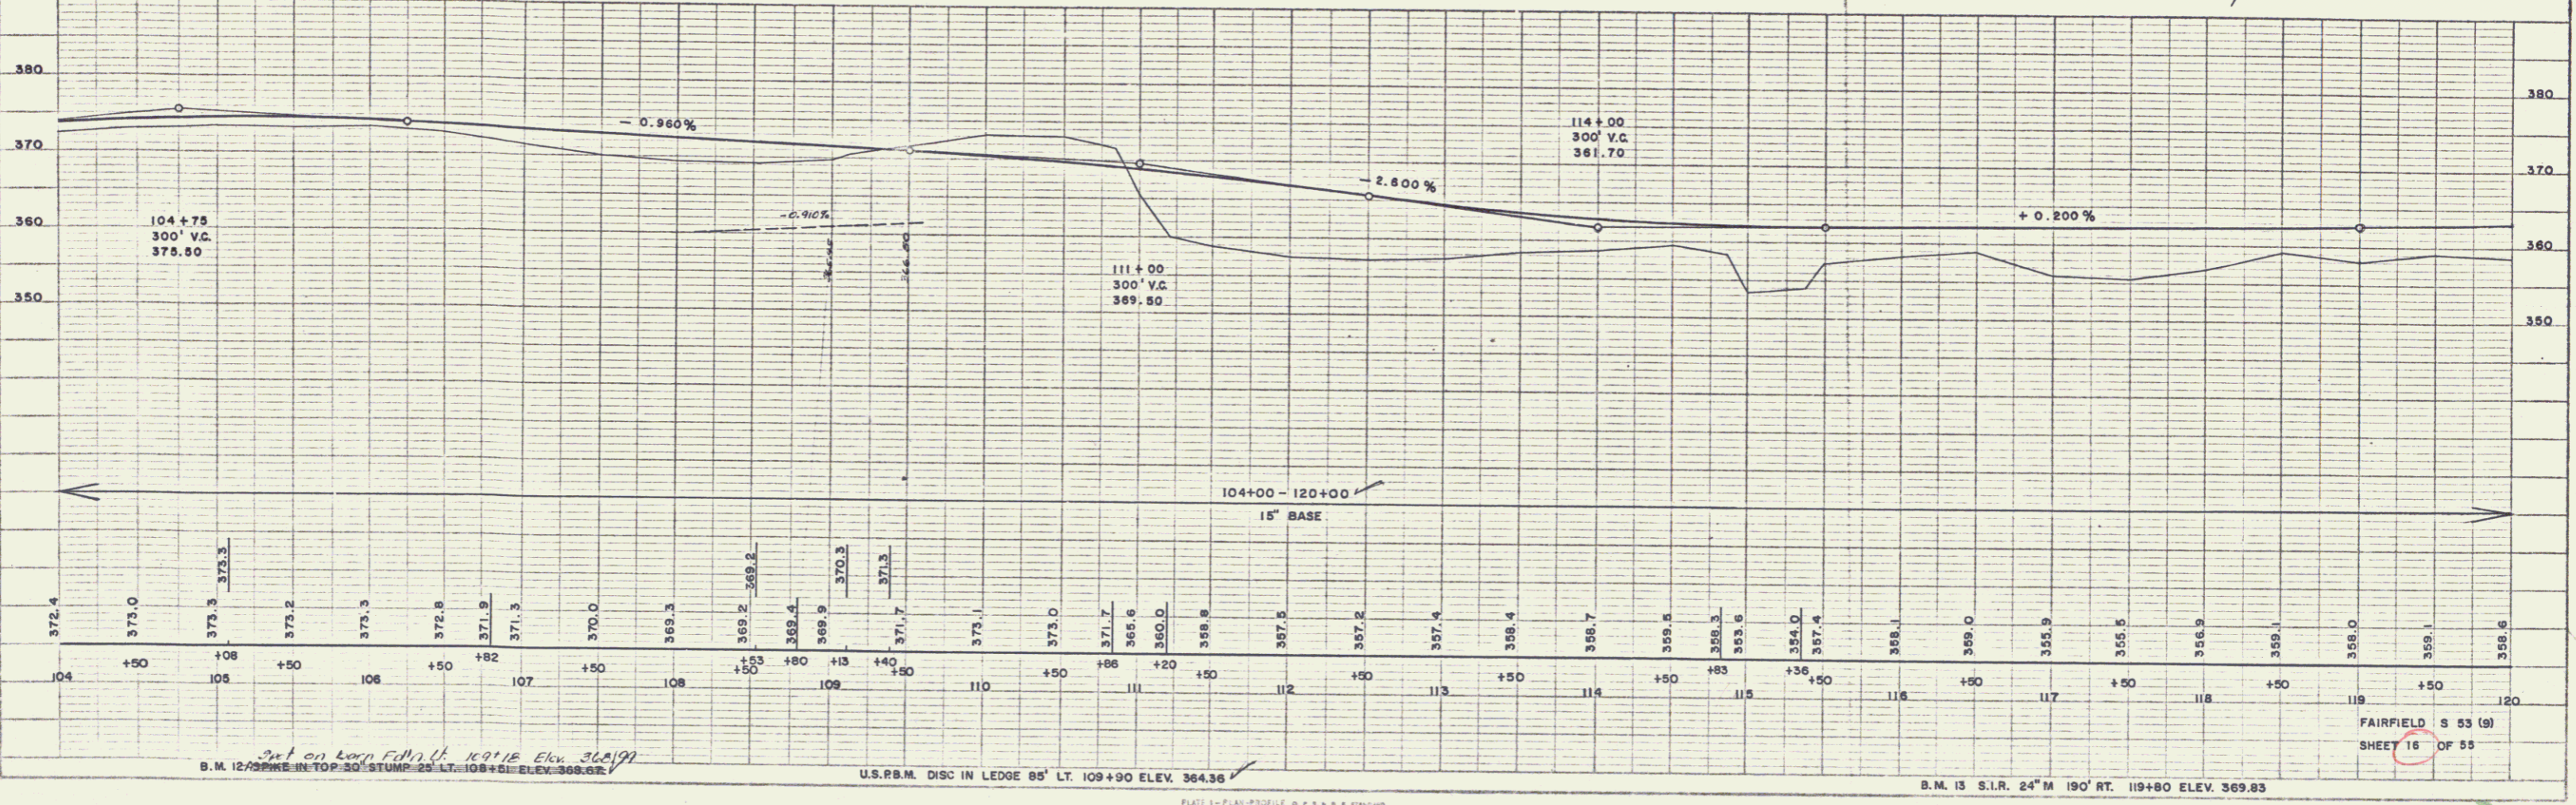
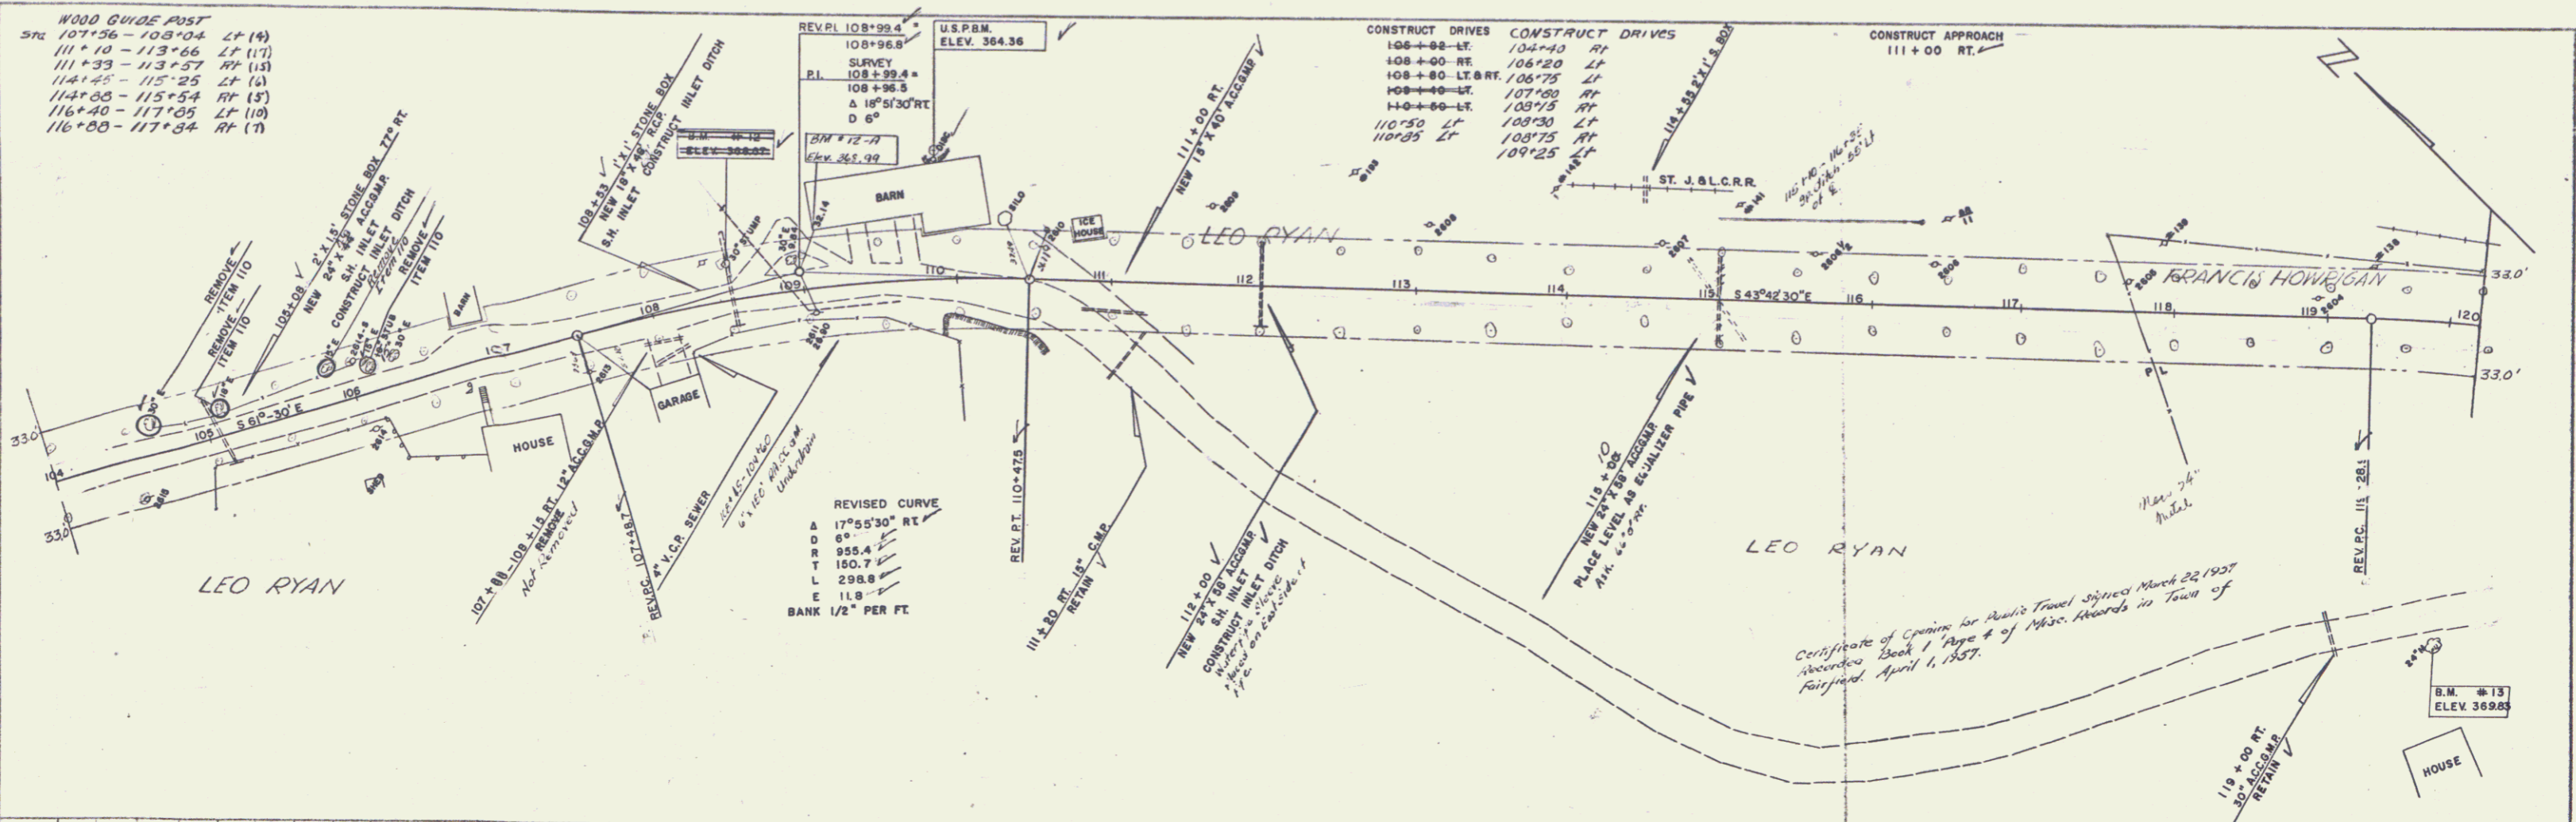


PLATE 1 - PLAN PROFILE OF P. A. & B. STAGES
 HOFFS, A. BISHOP CO., NEW YORK
 R & B CO. INC. 345 1/2
 NEW YORK, N. Y.