

SPALDING & WESTER-MARTIN INC. 8-54
 WESTER-MARTIN INC. 8-54
 PLIN
 NOTE BOOK
 DRAWING NO. 10-54
 DATE 10-1-54
 BY C. W. WESTER

SPALDING & WESTER-MARTIN INC. 8-54
 WESTER-MARTIN INC. 8-54
 PLIN
 NOTE BOOK
 DRAWING NO. 10-54
 DATE 10-1-54
 BY C. W. WESTER

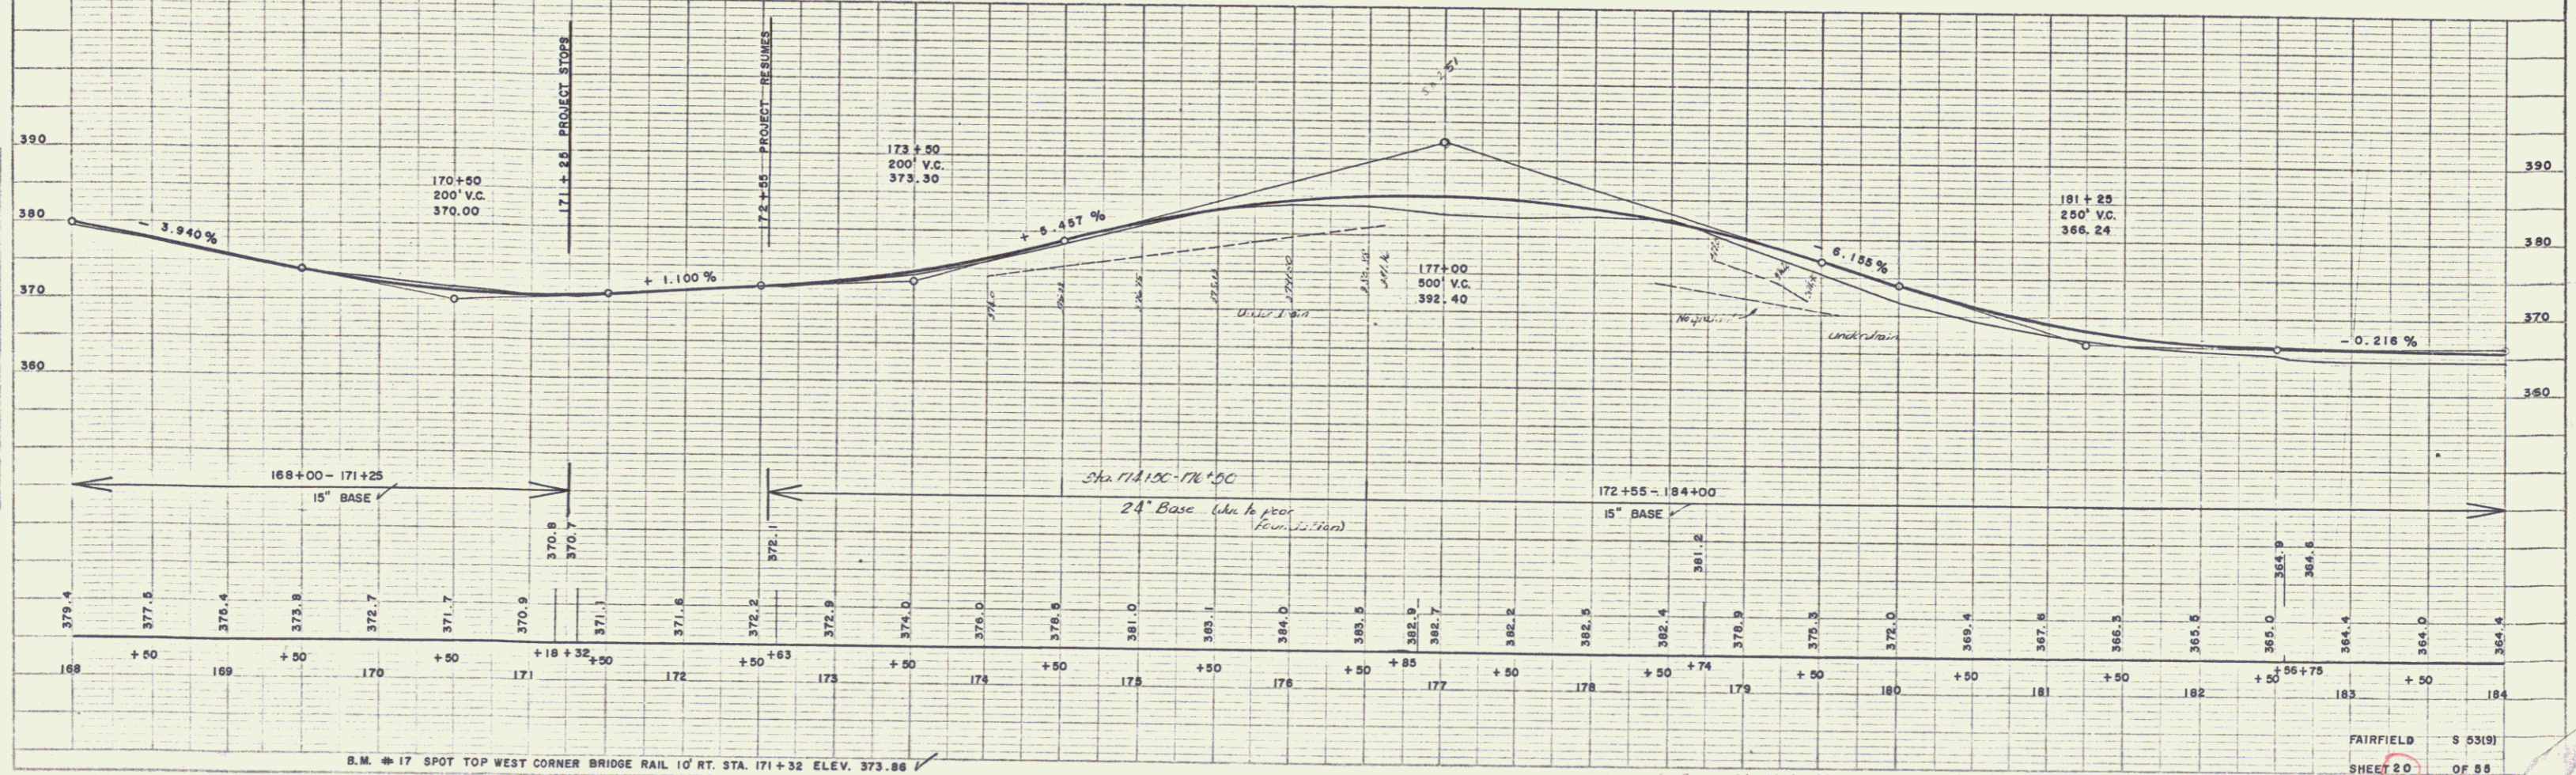
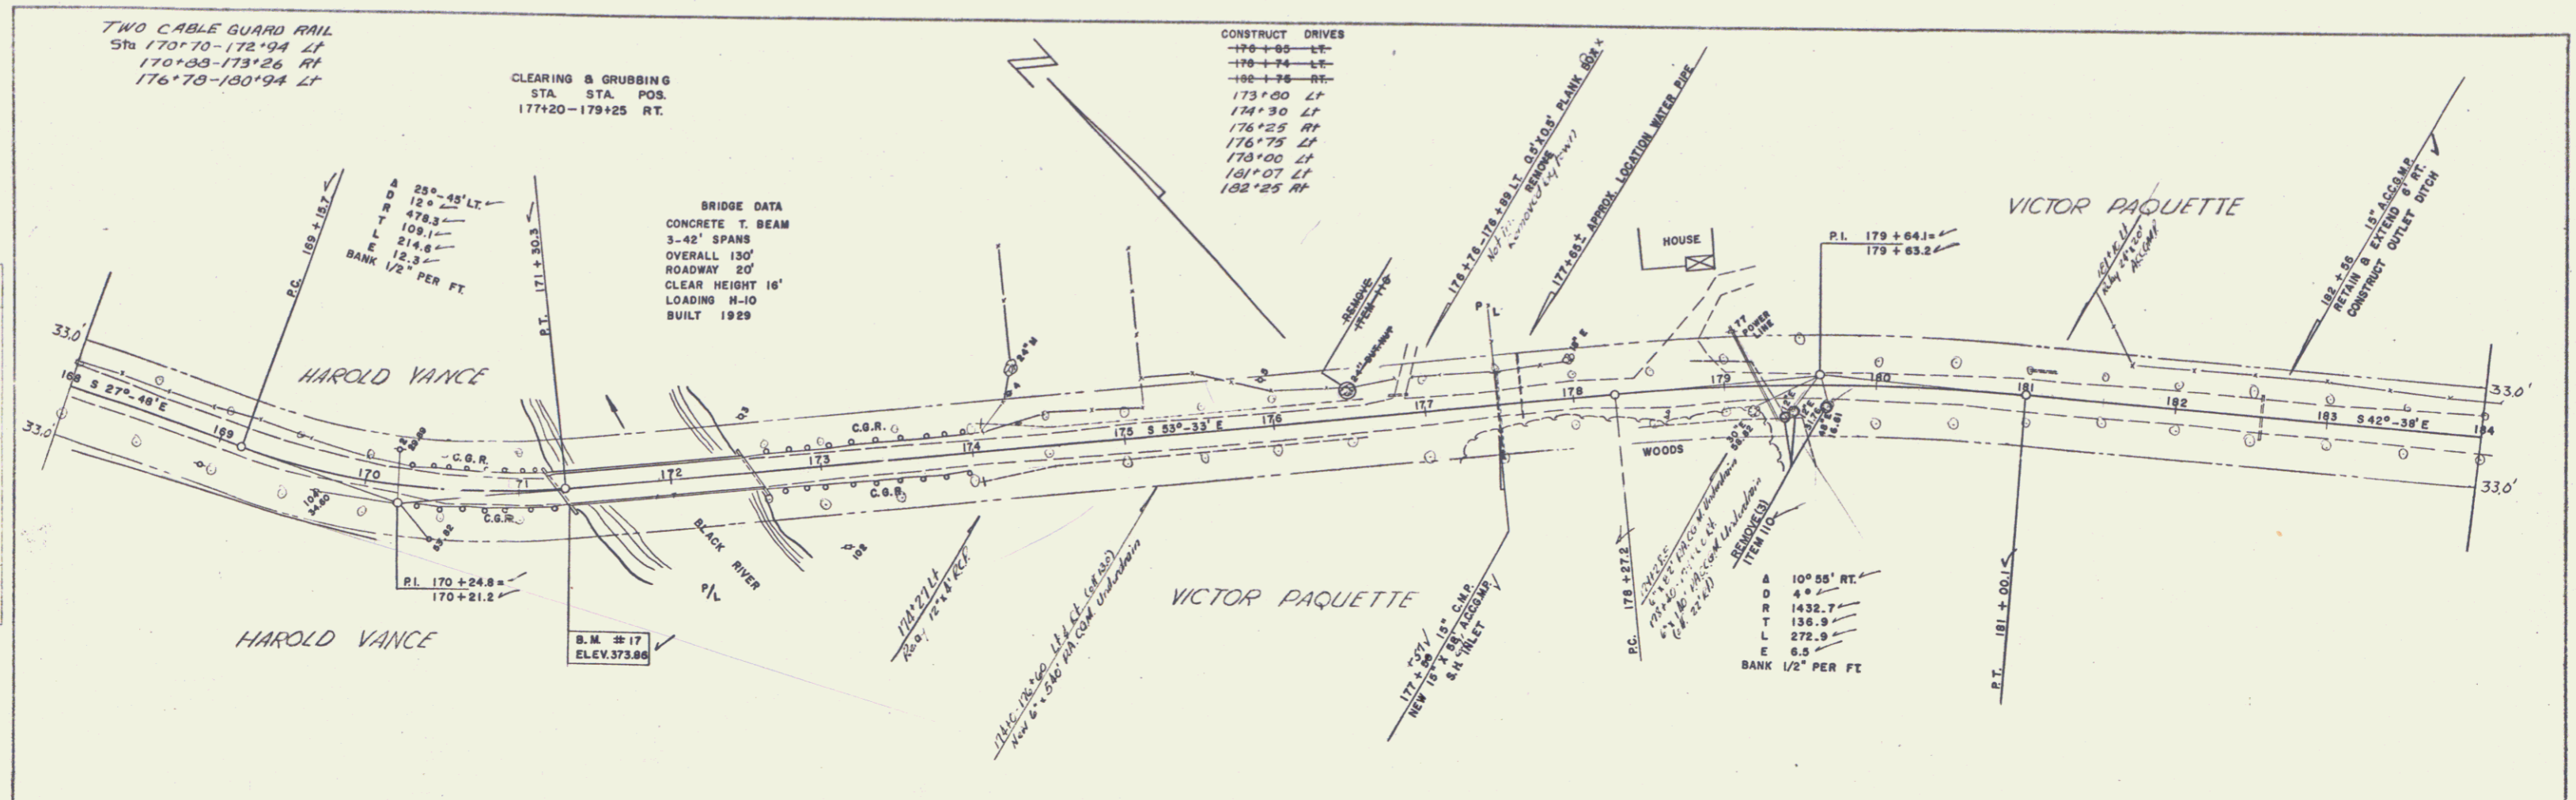


PLATE 1-1111-PROF. 8-54 & 8-55
 WESTER-MARTIN INC. 8-54
 DATE 10-1-54
 BY C. W. WESTER

FAIRFIELD S 53101
 SHEET 20 OF 55

12