
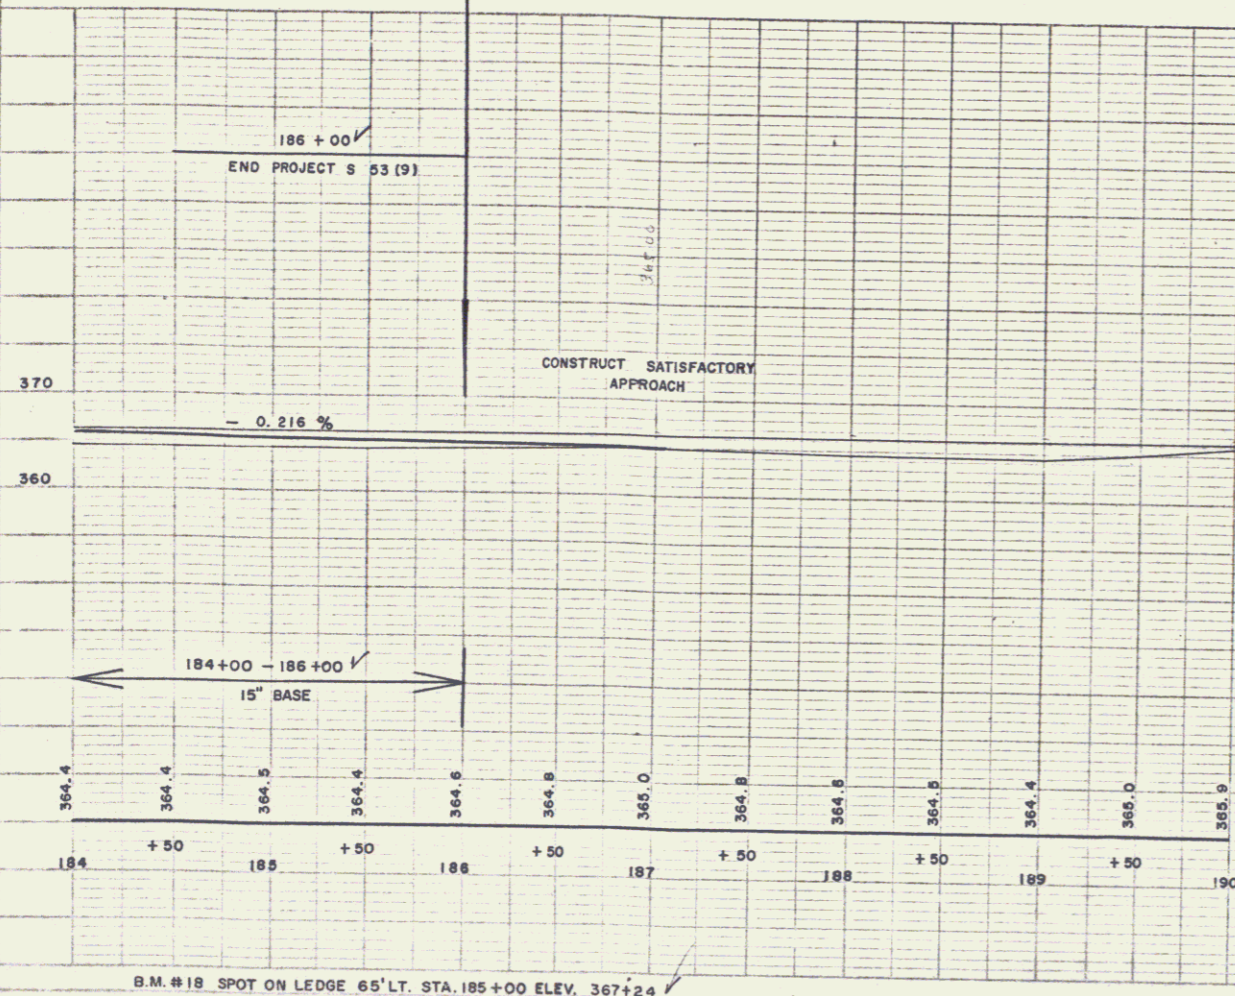


PLAN
 SPALDINE
 WESTON - MARTIN INC.
 12-34
 10-34
 NOTE BOOK
 PLANNING CHECKS
 10-34
 10-34

SPALDINE
 WESTON - MARTIN INC.
 12-34
 10-34
 NOTE BOOK
 PLANNING CHECKS
 10-34
 10-34

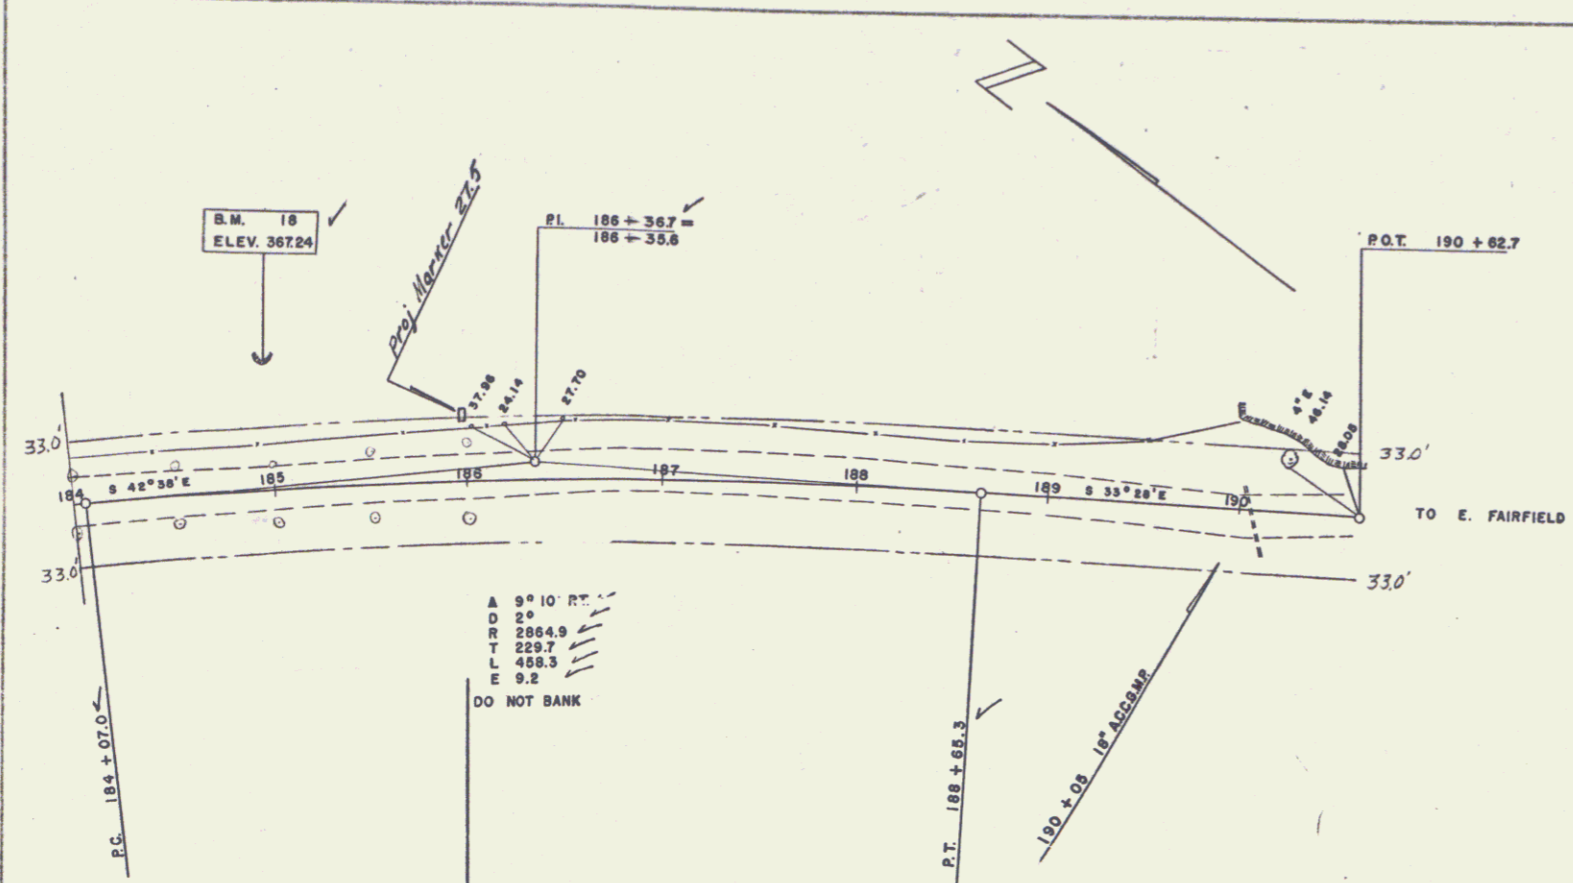

FAIRFIELD S 53 (9)
 SHEET 21 OF 55