



PLAN	3-00	5-00
DATE	11-1-53	
BY	JOC	
CHECKED		
DATE		
BY		
CHECKED		
DATE		
BY		
CHECKED		
DATE		

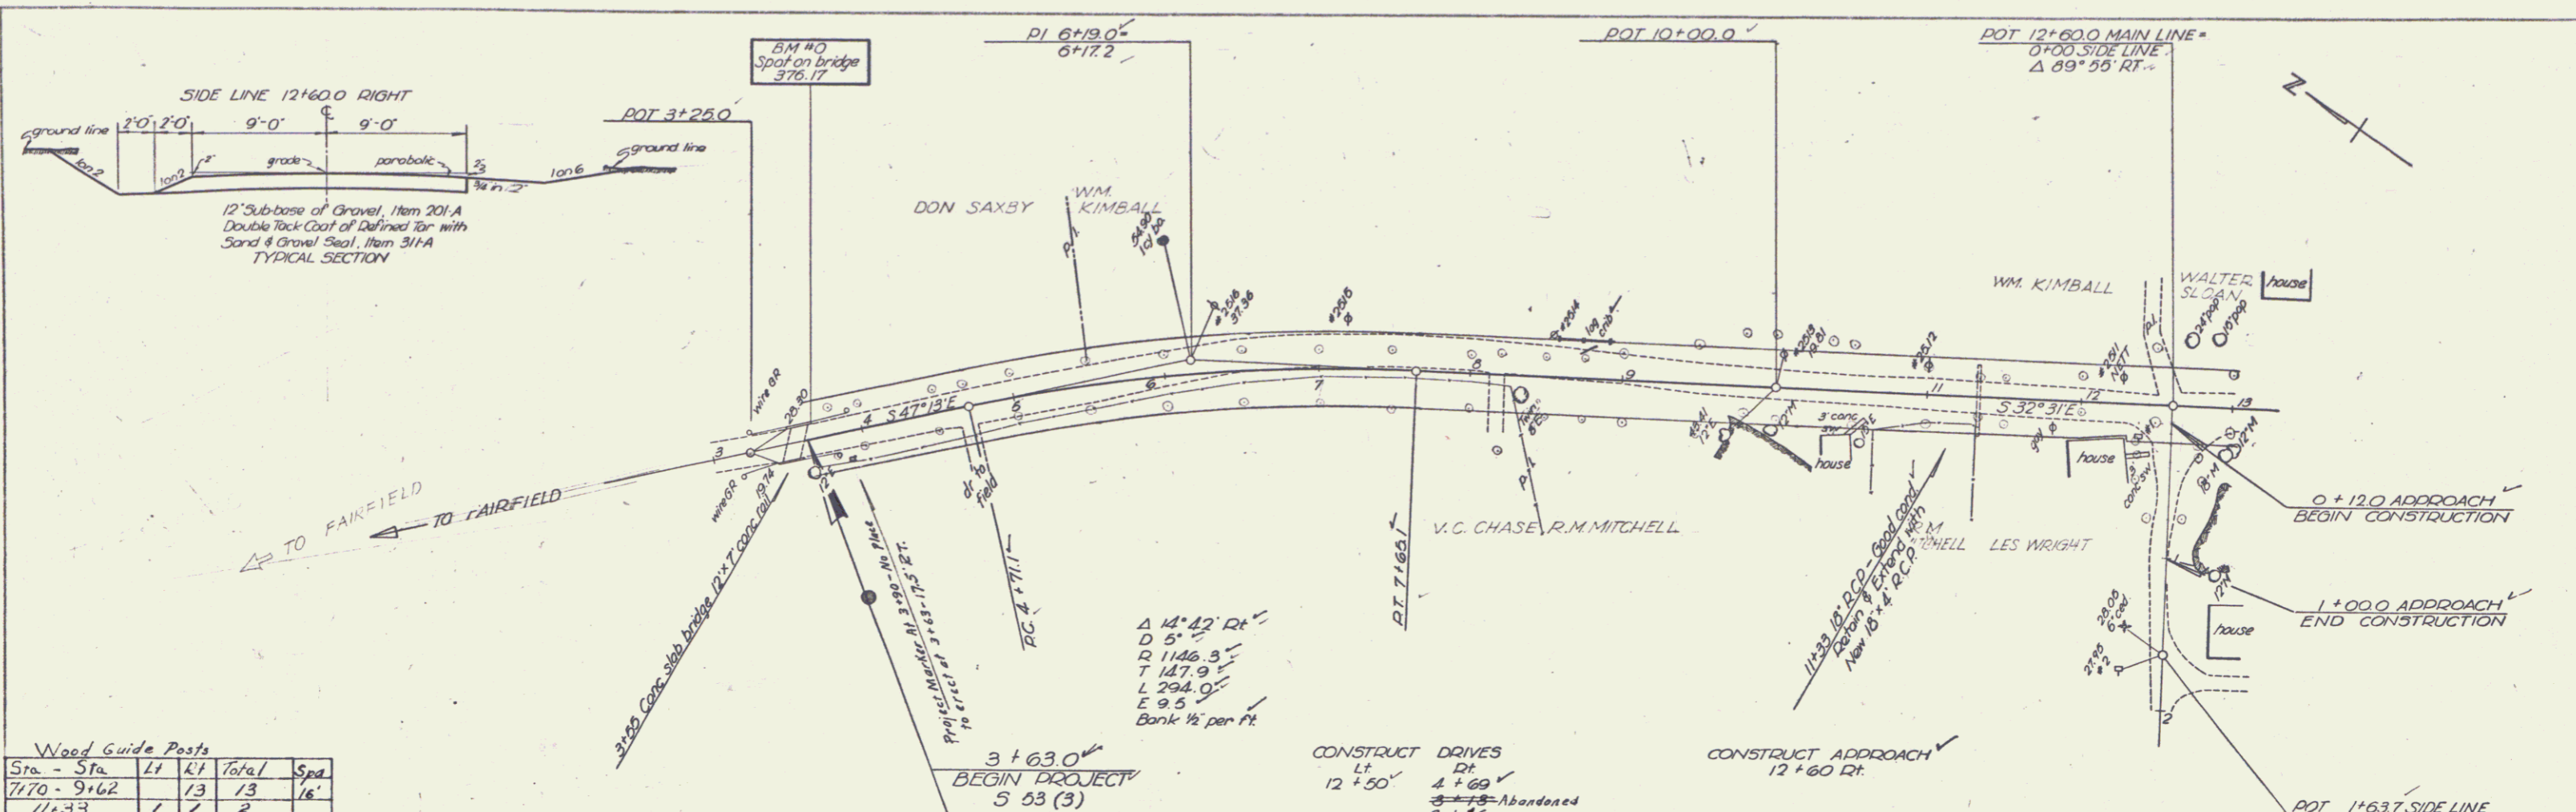

Wood Guide Posts

Sta. - Sta.	Lt	Lt	Total	Spd.
7+70 - 9+62	13	13	16'	
11+33	1	1	2	

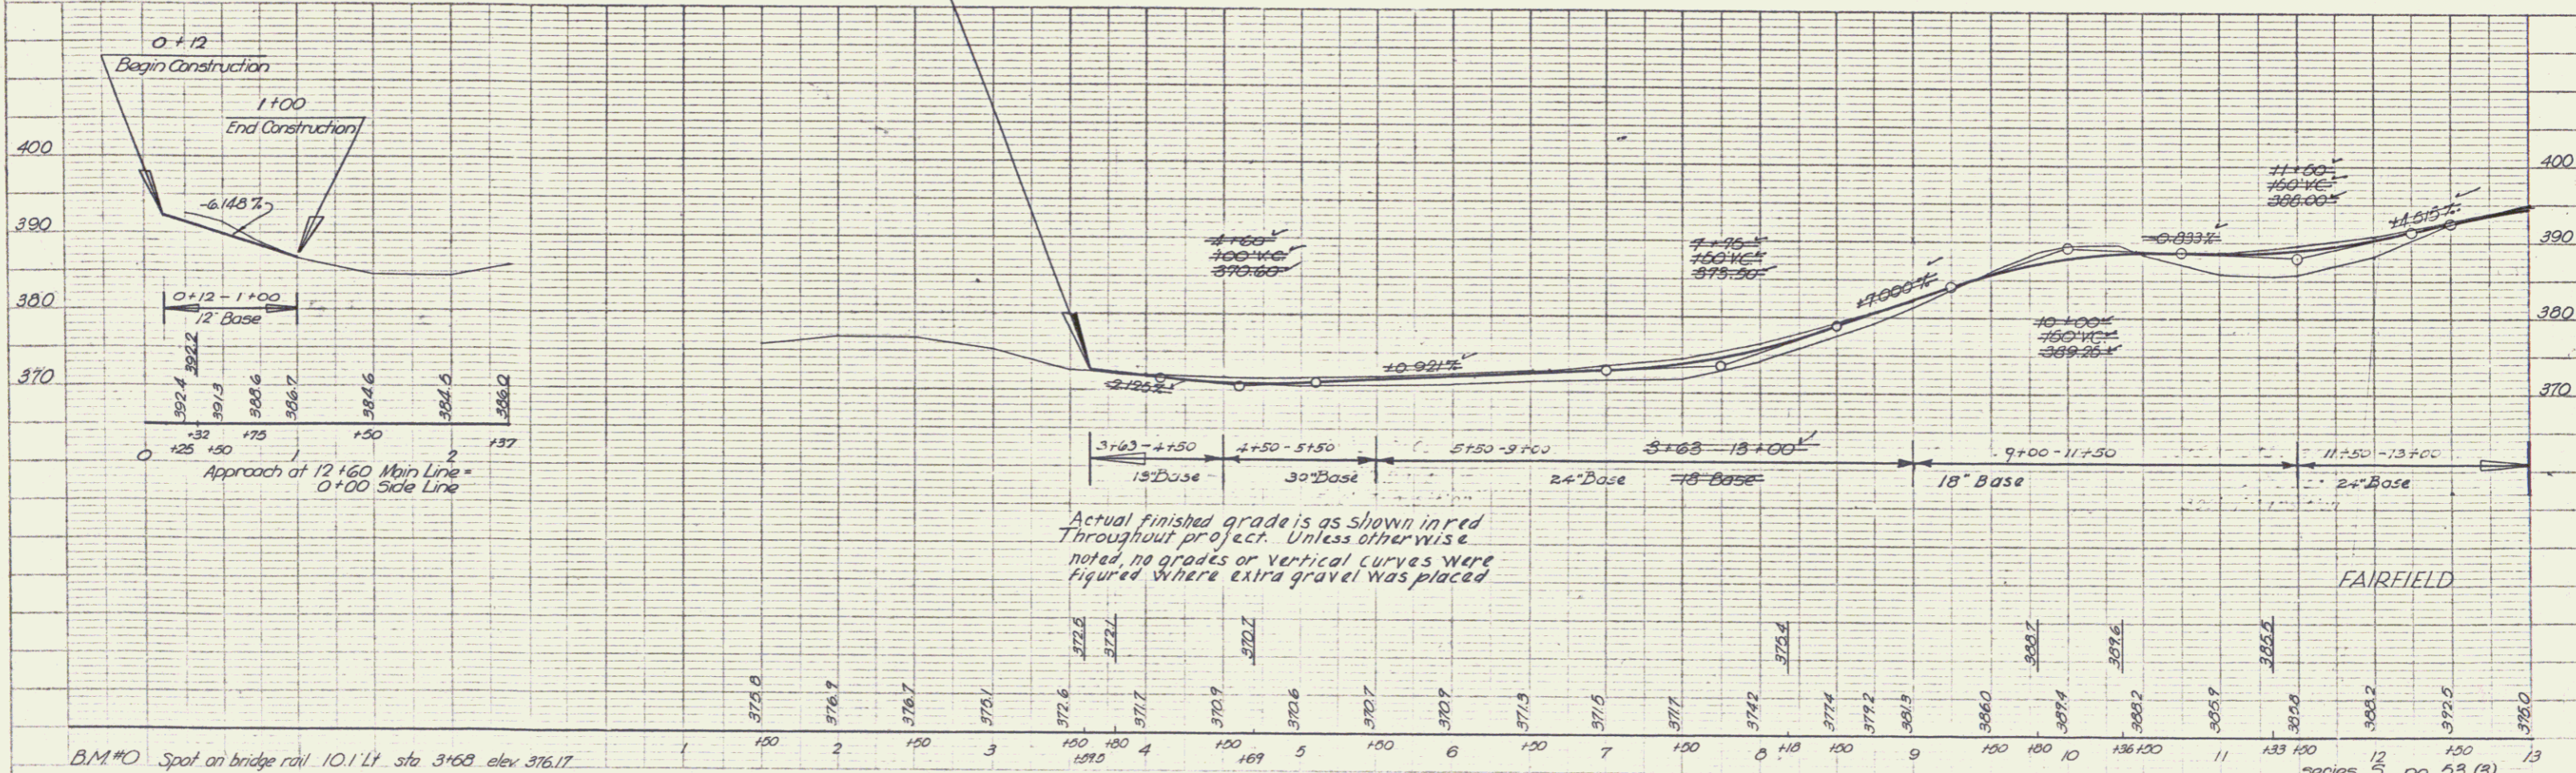

Profile	6-00	6-00
DATE	11-1-53	
BY	JOC	
CHECKED		
DATE		
BY		
CHECKED		
DATE		

B.M. #0 Spot on bridge rail 10.1' Lt sta 3+68 elev 376.17

Series 5 no 53 (3)
sheet 8 of 24 sheets