
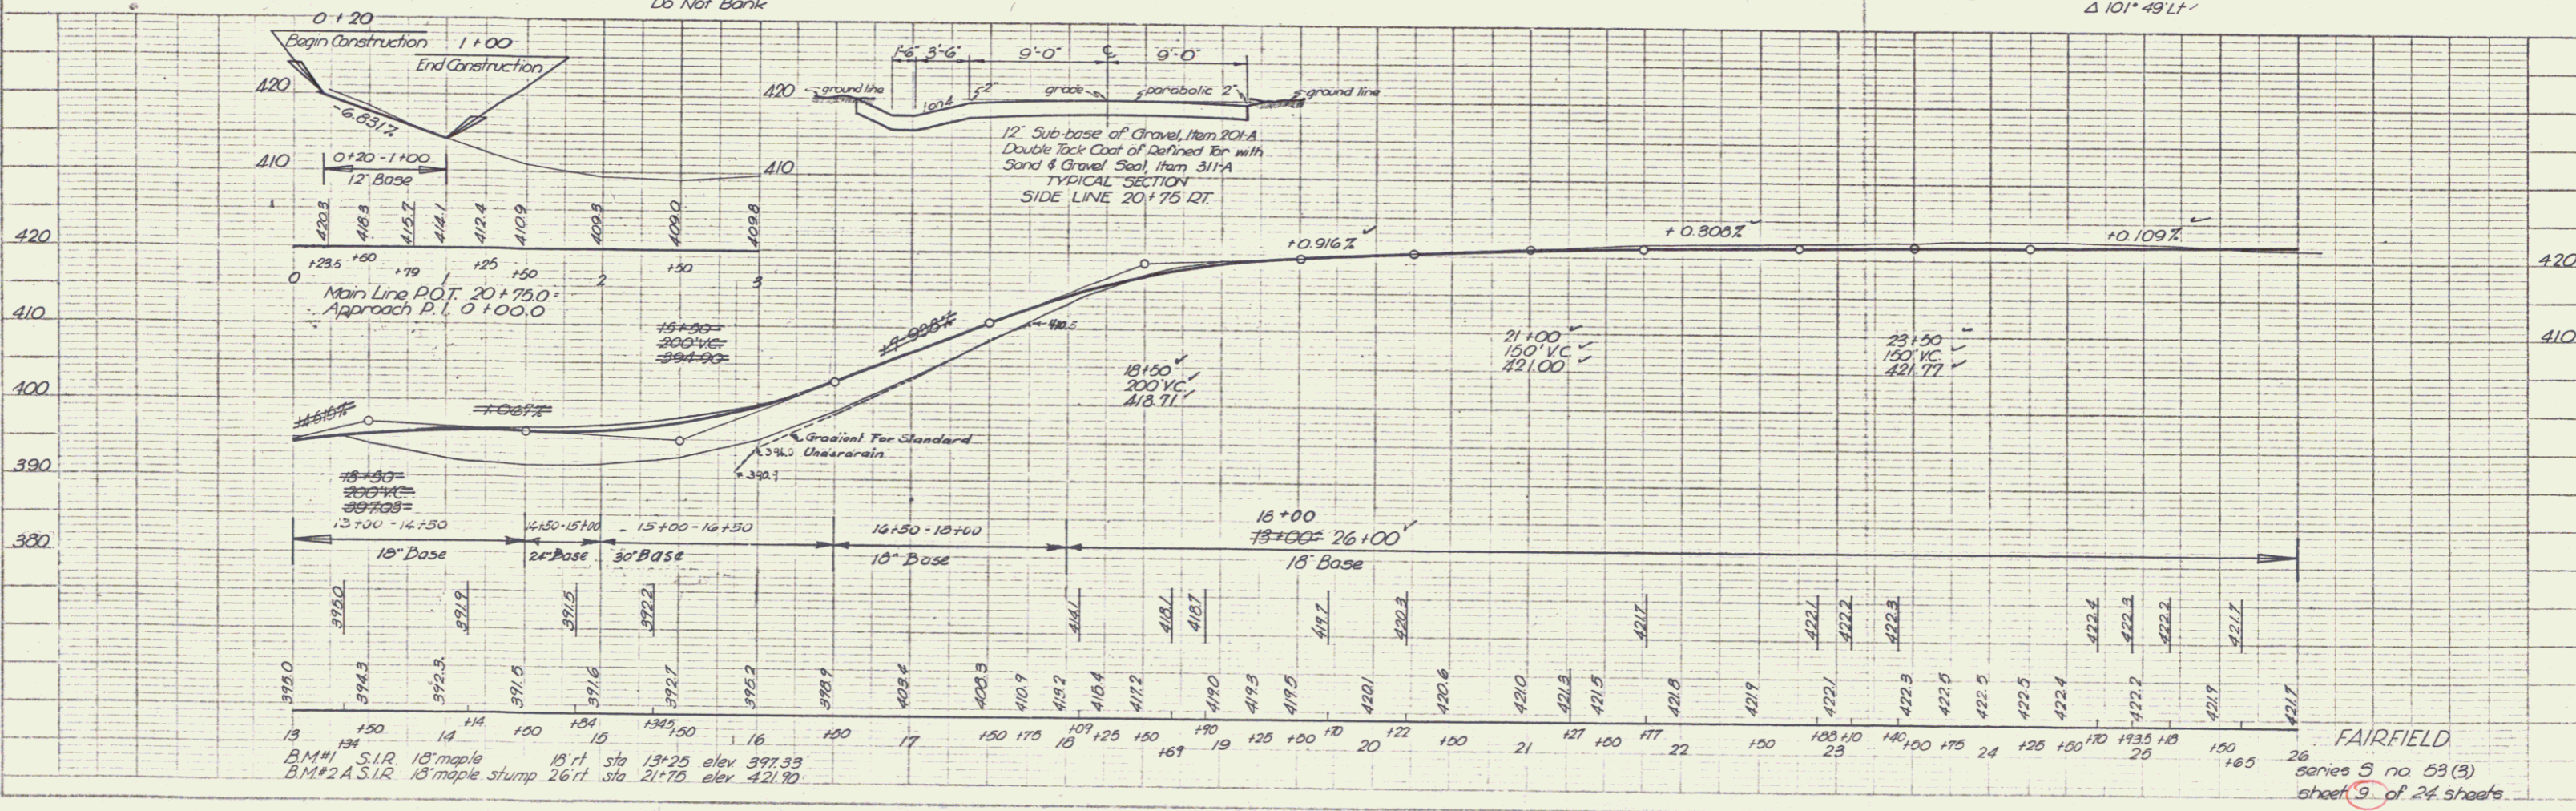


PLAN  
 DATE: 8-30  
 DRAWN BY: JCC  
 CHECKED BY: JCC  
 NO. OF SHEETS: 26  
 SHEET NO.: 9

PROFILE  
 DATE: 8-30  
 DRAWN BY: JCC  
 CHECKED BY: JCC  
 NO. OF SHEETS: 26  
 SHEET NO.: 9

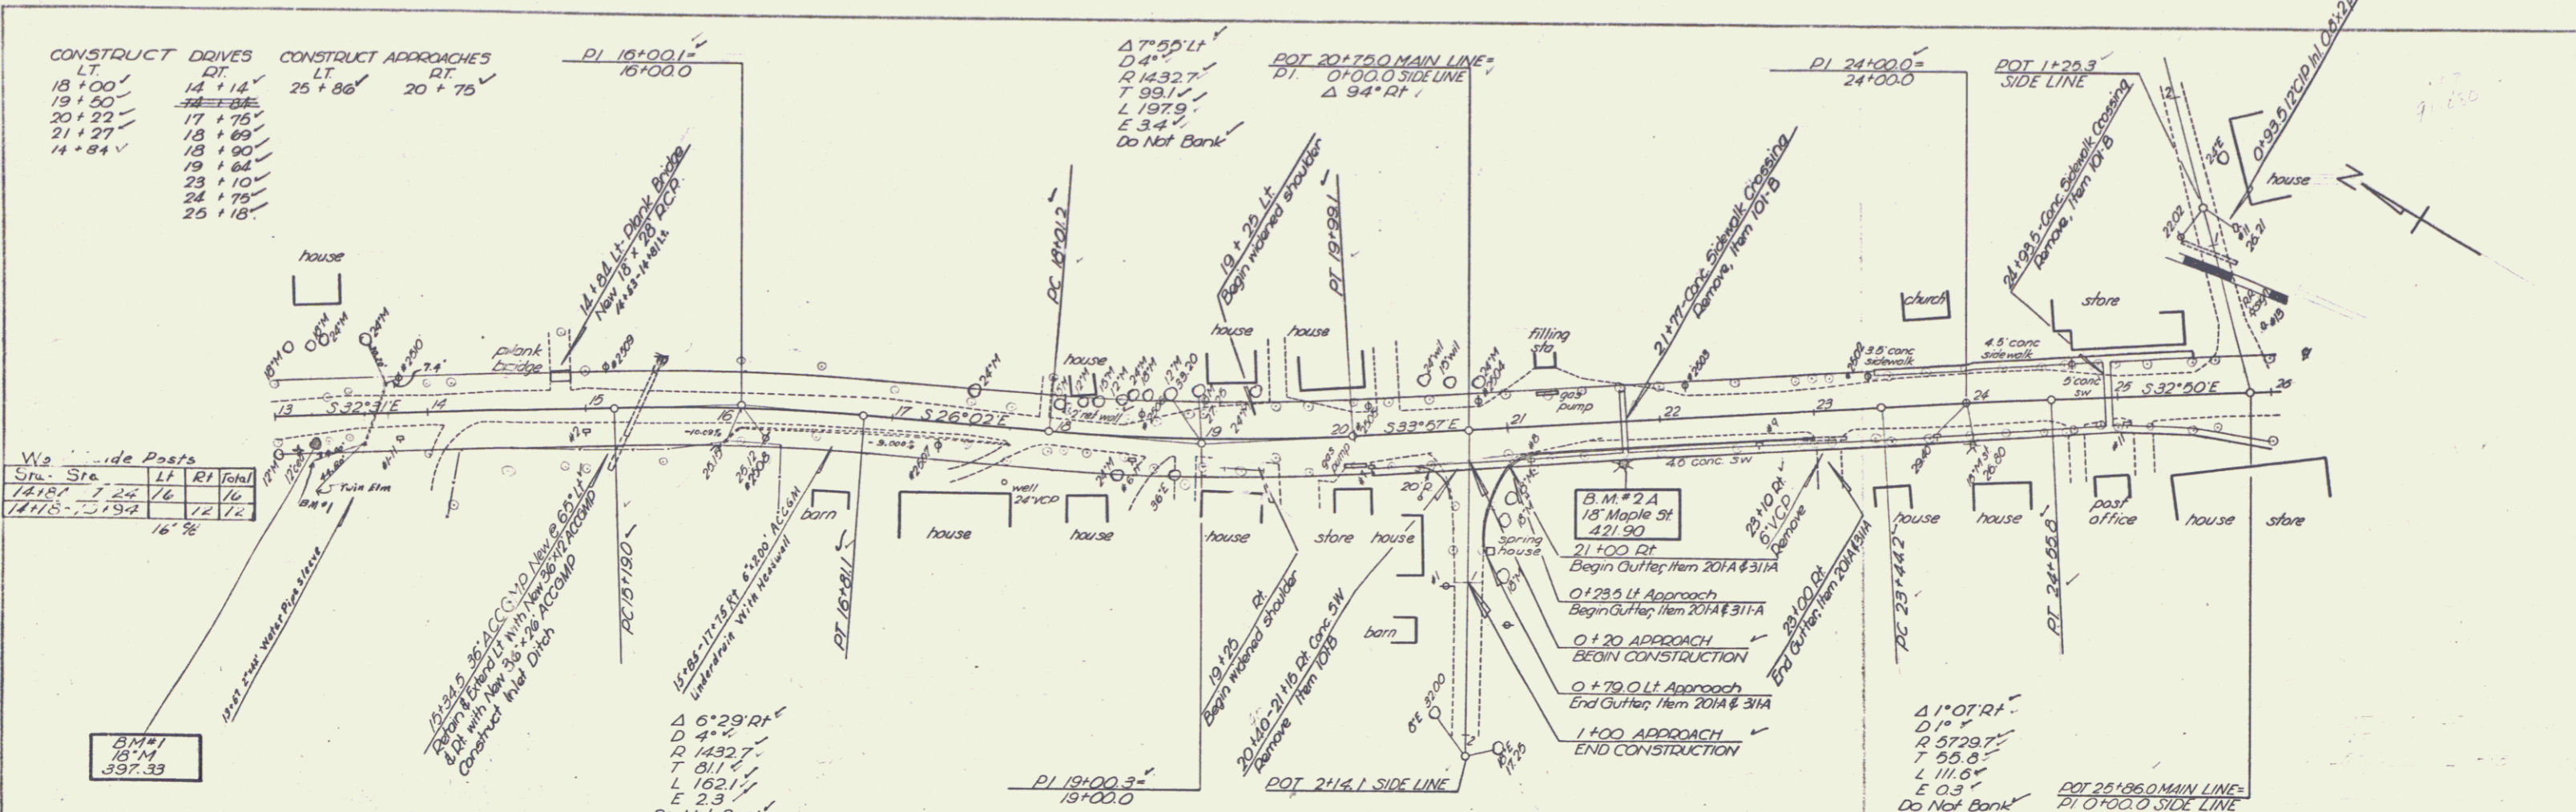

FAIRFIELD  
 series S no 59(3)  
 sheet 9 of 24 sheets