

PLAN	DATE	BY
4/24	CEH	
NO. 1	NO. 1	NO. 1
NO. 1	NO. 1	NO. 1
NO. 1	NO. 1	NO. 1
NO. 1	NO. 1	NO. 1

PROFILE	DATE	BY
4/24	CEH	
NO. 1	NO. 1	NO. 1
NO. 1	NO. 1	NO. 1
NO. 1	NO. 1	NO. 1
NO. 1	NO. 1	NO. 1

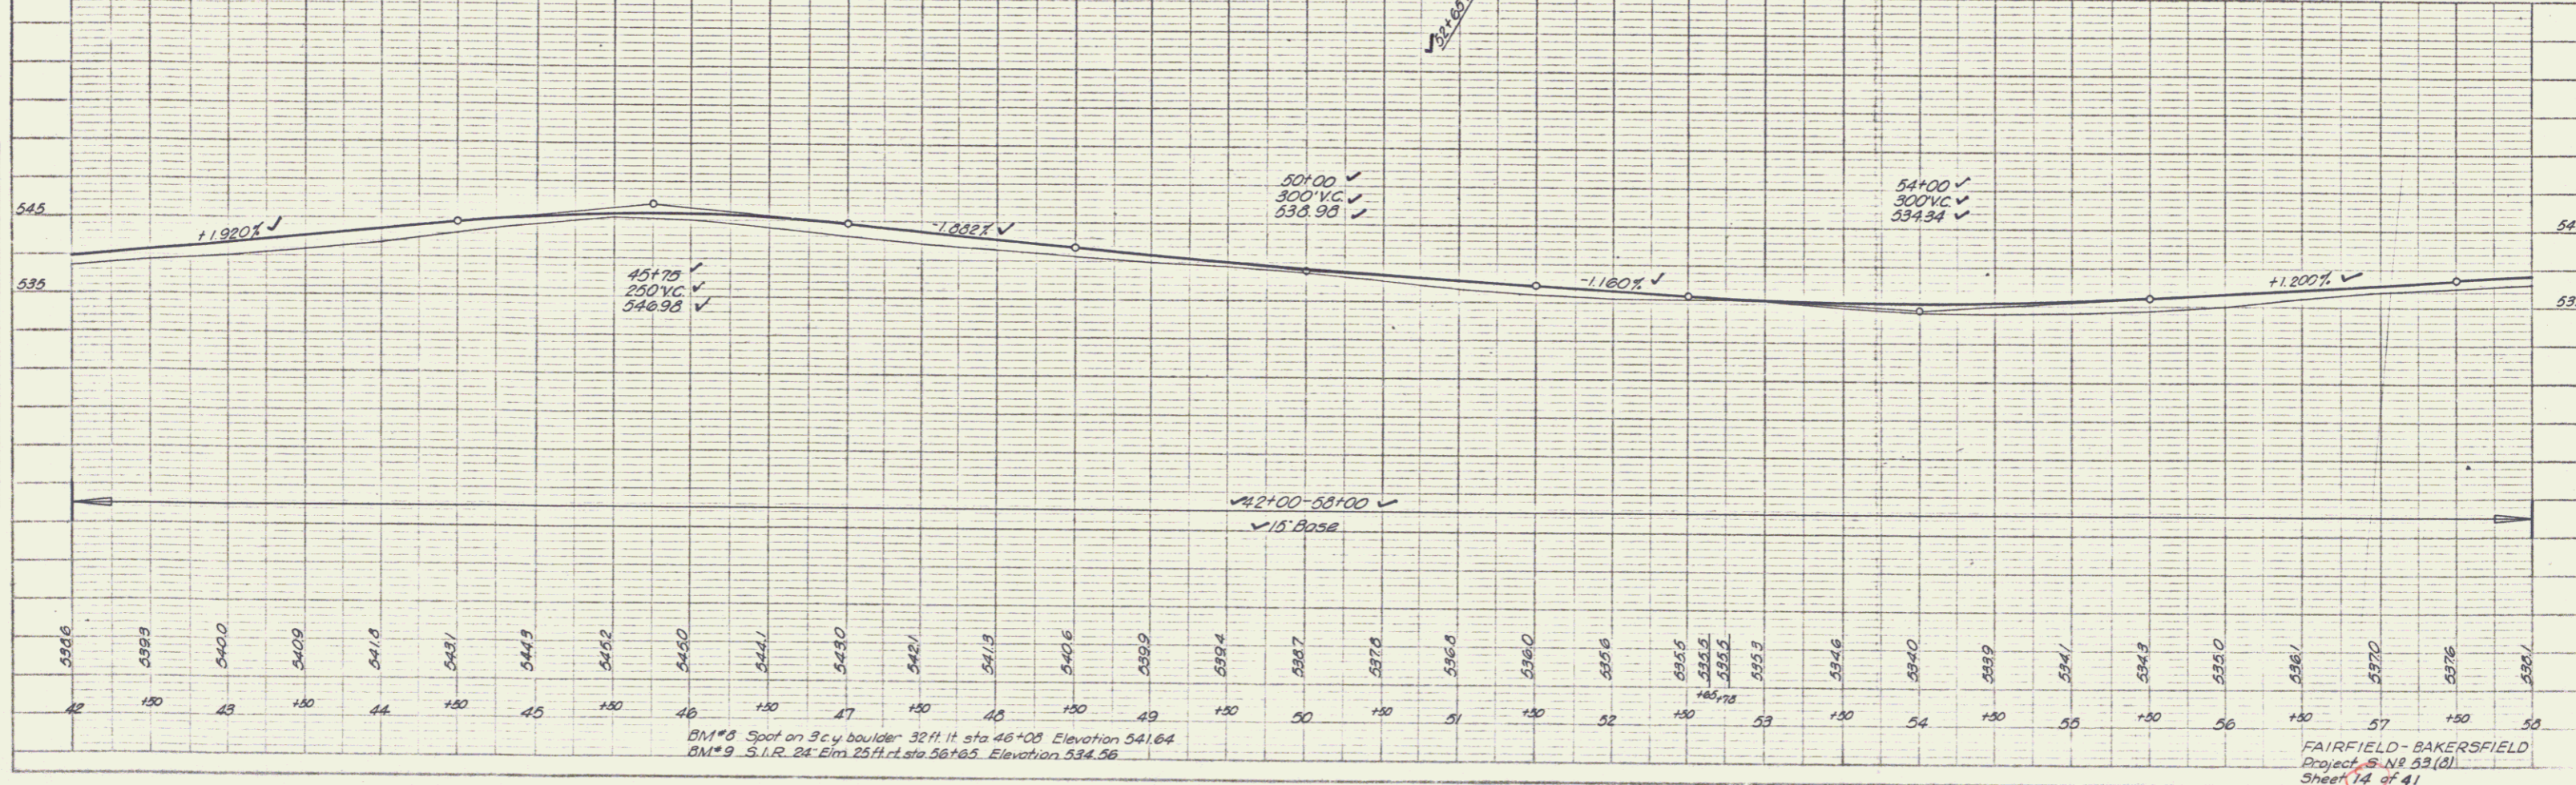
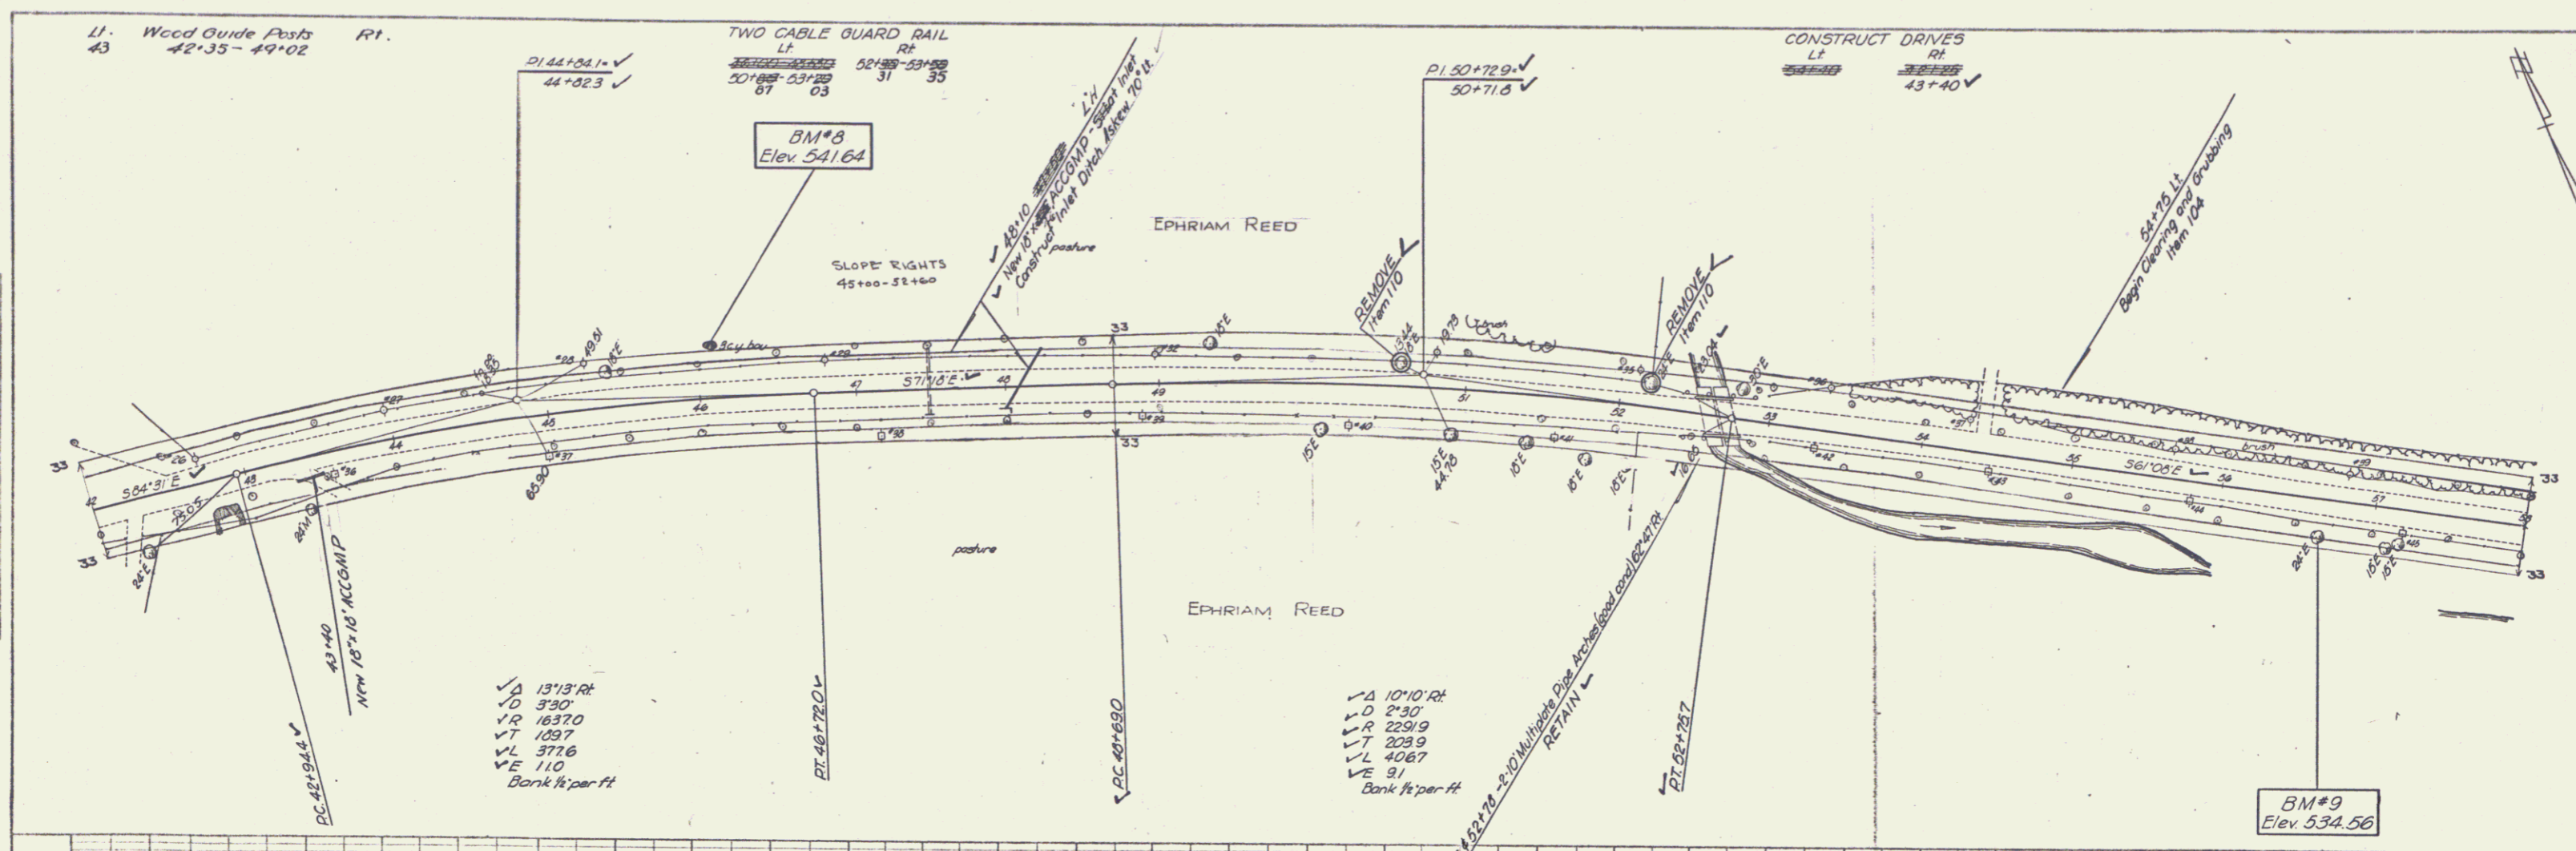


PLATE 1 - PLAN - PROFILE OF R.R. & R.E. STATION
 REF. TO SHEET 52, 53, 54, 99, 100

FAIRFIELD - BAKERSFIELD
 Project S-NR 53(3)
 Sheet 14 of 41