

BM#3 S.I.R. 36' Maple 43 ft sta 16+46 Elevation 422.09  
 BM#4 S.I.R. 36' Elm 66 ft sta 21+06 Elevation 433.29  
 BM#5 S.I.R. 36' Elm 61 ft sta 25+30 Elevation 503.24

FAIRFIELD - BAKERSFIELD  
 Project 5 N.E. 23(2)  
 Sheet 12 of 41








PLAN  
 DATE: 01/04  
 DRAWN BY: HAWK  
 CHECKED BY: C.E.H.  
 PROJECT: 553(C)  
 SHEET: 41

PROFILE  
 DATE: 01/04  
 DRAWN BY: BEH  
 CHECKED BY: C.E.H.  
 PROJECT: 553(C)  
 SHEET: 41

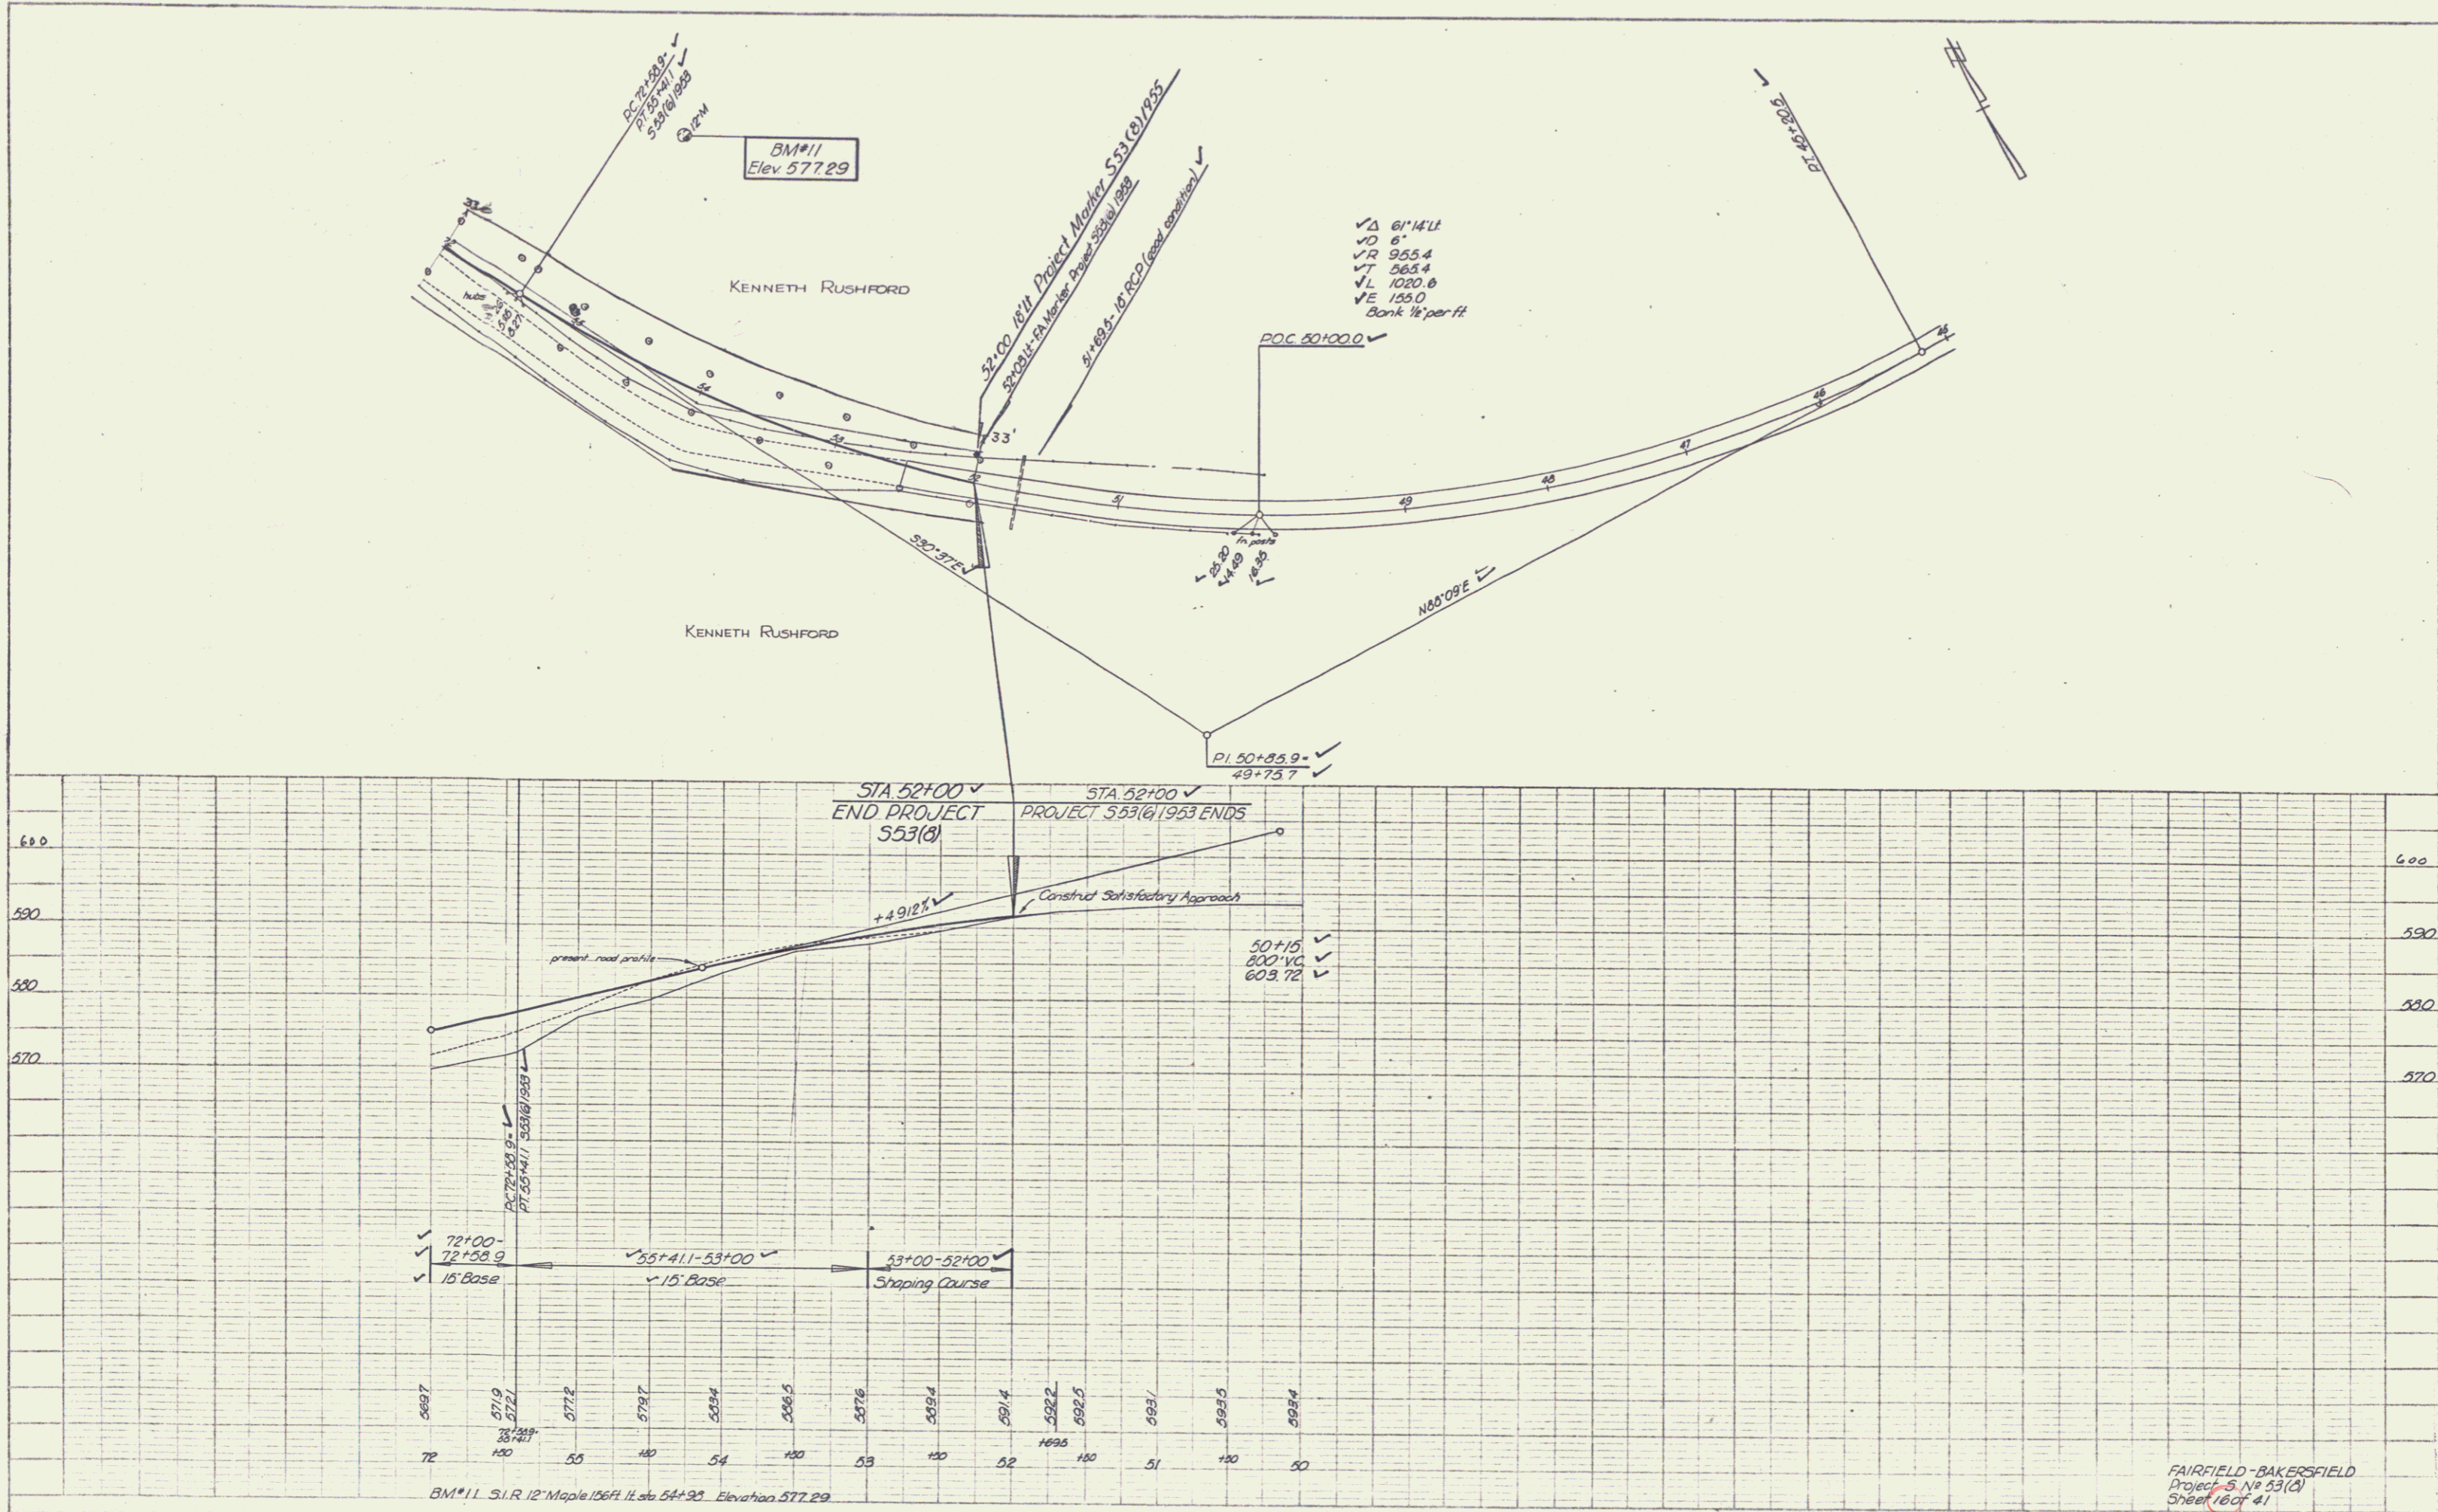

BM#11 51.R 12" Maple 126# 11 Sta 54+93 Elevation 577.29

PLATE 1 - PLAN & PROFILE OF PAVEMENT  
 SCALE: 1" = 40'

FAIRFIELD-BAKERSFIELD  
 Project S. No. 53(C)  
 Sheet 41 of 41

6