

INDEX OF SHEETS

SHEET NO. 1	TITLE PAGE
" 2	TYPICAL CROSS-SECTION OF IMPROVEMENT STABILIZED GRAVEL BASE COURSE OF CUTBACK ASPHALT WITH SAND SEAL ITEM 303-B
" 3	BANKING AND WIDENING TABLES
" 4	CONSTRUCTION DETAILS (CD) DRAINAGE AND MARKERS
" 5	CONSTRUCTION DETAILS (CD 1) DITCHES
" 6	QUANTITIES SHEET (ITEMS AND DRAINAGE)
7-8	EARTHWORK SHEETS
9	STANDARD STRUCTURE SHEET S-40 (BARRICADES, SIGNS AND LIGHTS)
10	DETAILS OF CORRUGALY MET. PLATE PIPE ARCH 93" X 64" STA. 22+98
11-14	PLAN AND PROFILE SHEETS
15-24	CROSS-SECTIONS

STANDARD STRUCTURE SHEET APPROVED BY THE CHIEF ENGINEER, VERMONT STATE DEPARTMENT OF HIGHWAYS
S-40 JULY 10, 1950

PROJECT NAME & NUMBER	TYPE	PAVEMENT AREA
BAKERSFIELD S 53 (6)	STAB. GR. BASE	9:52B S.Y.
RECORD PLANS		
MATERIALS		
SUB-BASE OF GRAVEL MOREY PIT, E. FAIRFIELD, VT.	FIBRE DR. PIPE BERINGO, BERLIN, N. H.	
ASPHALT STANDARD OIL CO., ALBANY, N.Y.	ACCGMP BENSER MET. PIPE CO., WESTMINSTER, ST. VT.	
ROP VE. CO. PIPE CO., WINDSOR, VT.		
CONTRACTOR MORRIS & SAMPLE	CONTRACT DATED DEC. 8, 1952	
RES. ENGINEER H. G. GARRETS	CONTRACT STARTED MAY 5, 1953	
INSPECTOR G. E. HOPKINS	CONTRACT COMPLETED AUG. 13, 1953	
RECORD PLANS G. E. HOPKINS	CONTRACT ACCEPTED AUG. 13, 1953	

STATE OF VERMONT
STATE HIGHWAY DEPARTMENT



PLAN AND PROFILE OF PROPOSED
STATE HIGHWAY

TOWN OF BAKERSFIELD
COUNTY OF FRANKLIN
STATE AID ROUTE 1
BAKERSFIELD-EAST FAIRFIELD ROAD

BEGINNING AT A POINT 0.8 MILE WEST OF THE INTERSECTION OF VERMONT ROUTE 109 AND STATE AID ROUTE 1 AND EXTENDING WESTERLY 4,175 FT.

LENGTH OF PROJECT 4,175 FT = 0.791 MILE

FED. ROAD DIV. NO.	STATE	FED. ROAD PROJ. NO.	FISCAL YEAR	SHEET NO.	TOTAL SHEETS
1	VT.	3 53(6)	POST MAR	1	24

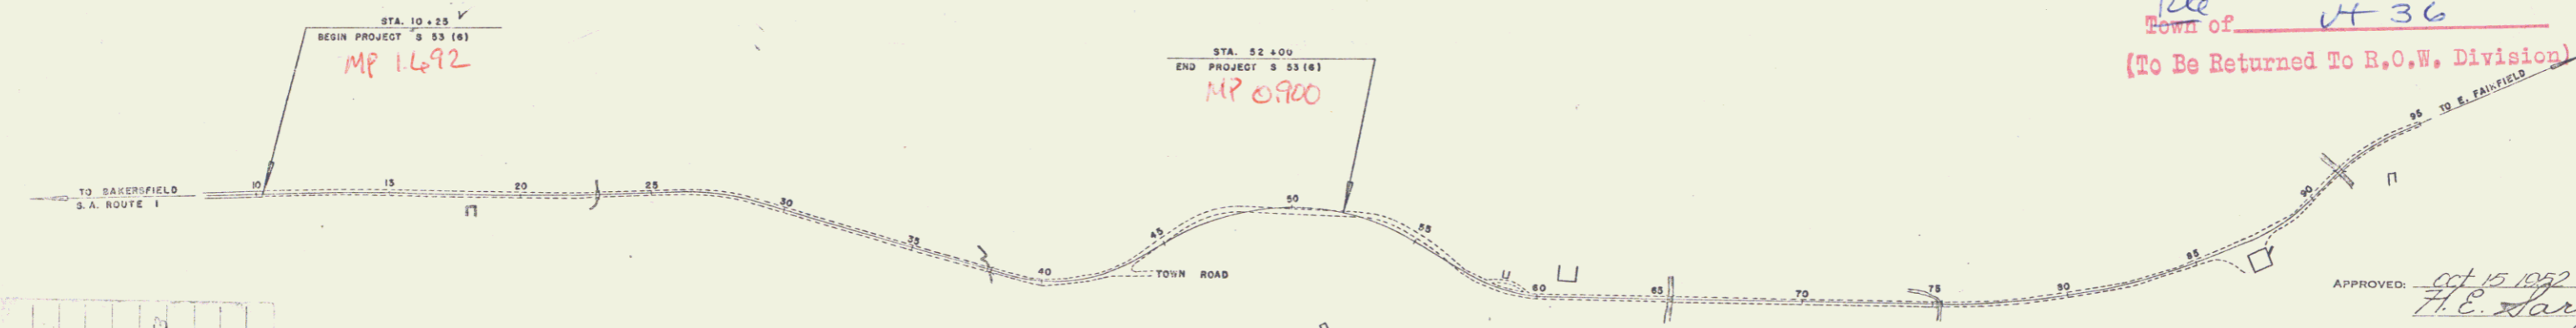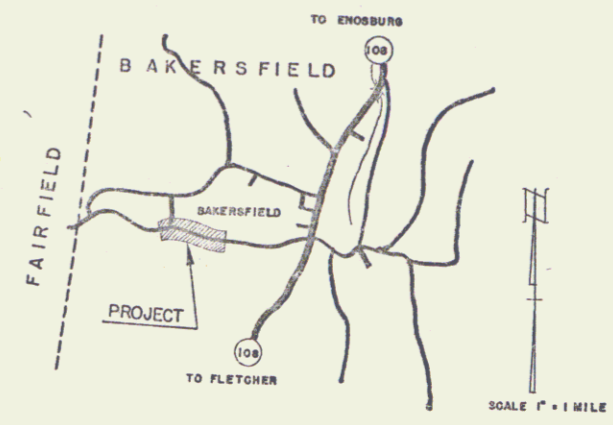

RIGHT-OF-WAY DIVISION
TOWN FILE
PERPETUAL
Rte Town of VT 36
(To Be Returned To R.O.W. Division)

APPROVED: *H.E. Targent*
CHIEF ENGINEER

SUBMITTED BY ORDER OF THE STATE HIGHWAY BOARD

BAKERSFIELD
S-53(6)
S. G. ROSE
CONTRACTOR MORRIS & SAMPLE
SEE TITLE PAGE

GROUND ELEVATION	DATUM	LINE
GRADE ELEVATION	DATUM	LINE

CURVE DATA

DEFLECTION ANGLE	Δ
DEGREE OF CURVE	D
RADIUS OF CURVE	R
TANGENT DISTANCE	T
LENGTH OF CURVE	L
EXTERNAL DISTANCE	E
POINT OF INTERSECTION	P. I.
POINT OF CURVE	P. C.
POINT OF TANGENT	P. T.
POINT ON TANGENT	P. O. T.

SCALES

TITLE	1" = 300'
TYPICAL	1" = 2'
PLAN	1" = 50'
PROFILE HORIZONTAL	1" = 100'
PROFILE VERTICAL	1" = 10'
CROSS SECTIONS	1" = 5'

THESE PLANS ARE SUBJECT TO SUCH REVISIONS AS MAY BE REQUIRED BY THE BUREAU OF PUBLIC ROADS OR THE COMMISSIONER OF HIGHWAYS.
CONSTRUCTION IS TO BE CARRIED ON IN ACCORDANCE WITH THE PLANS AND THE STANDARD ROAD AND BRIDGE SPECIFICATIONS OF 1948, AS APPROVED JULY 25 1949 BY THE BUREAU OF PUBLIC ROADS, INCLUDING ALL SUBSEQUENT APPROVED REVISIONS AND SUCH REVISED SPECIFICATIONS AND SPECIAL PROVISIONS AS ARE SUBMITTED WITH THE PLANS.

DEPARTMENT OF COMMERCE
BUREAU OF PUBLIC ROAD

RECOMMENDED FOR APPROVAL

DISTRICT ENGINEER DATE

APPROVED

DIVISION PROJECT DATE

APPROVED	APPROVED	APPROVED	APPROVED
CONSTRUCTION ENGINEER	SECONDARY ENGINEER	HIGHWAY ENGINEER	DISTRICT ENGINEER

STEARNS R. JENKINS
Rte 36