
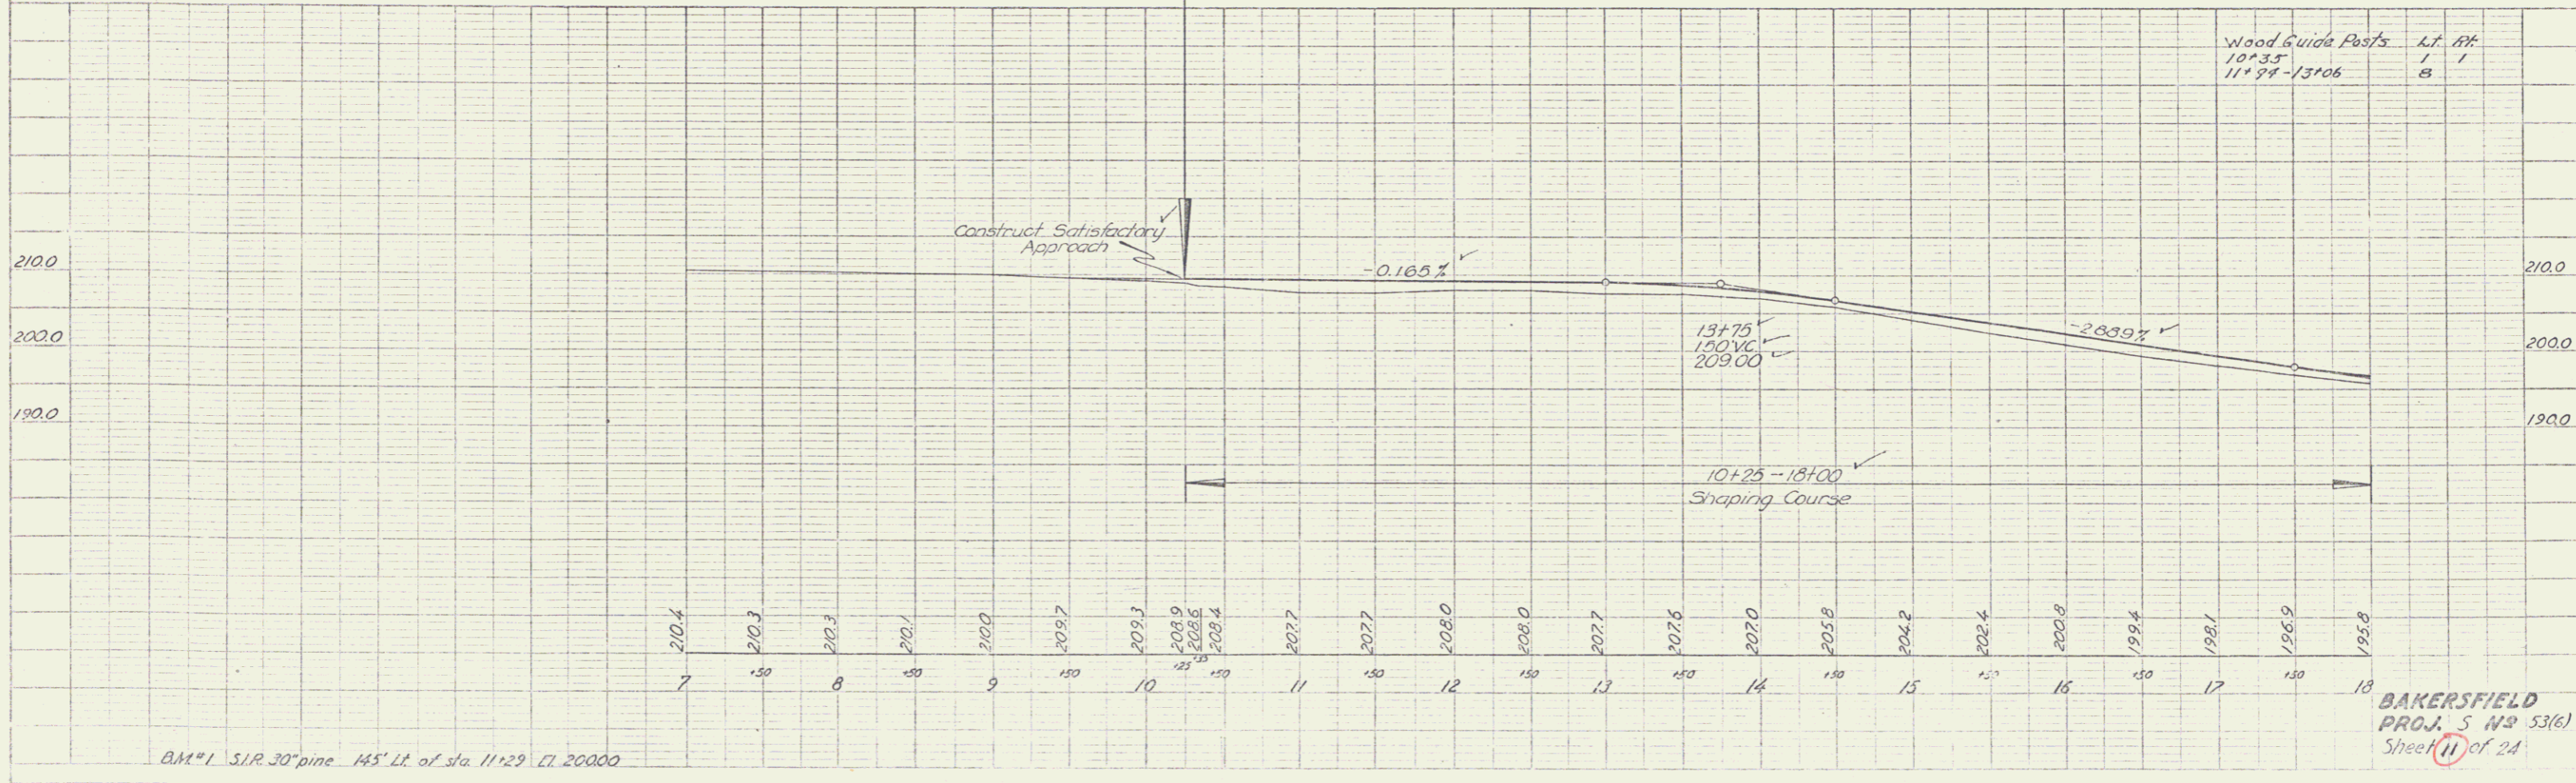


PLAN  
 SHEET NO. 53(6)  
 DATE AUG 21  
 DRAWN BY MILLER  
 CHECKED BY MILLER

PROJ. NO. 53(6)  
 SHEET NO. 53(6)  
 DATE AUG 21  
 DRAWN BY MILLER  
 CHECKED BY MILLER

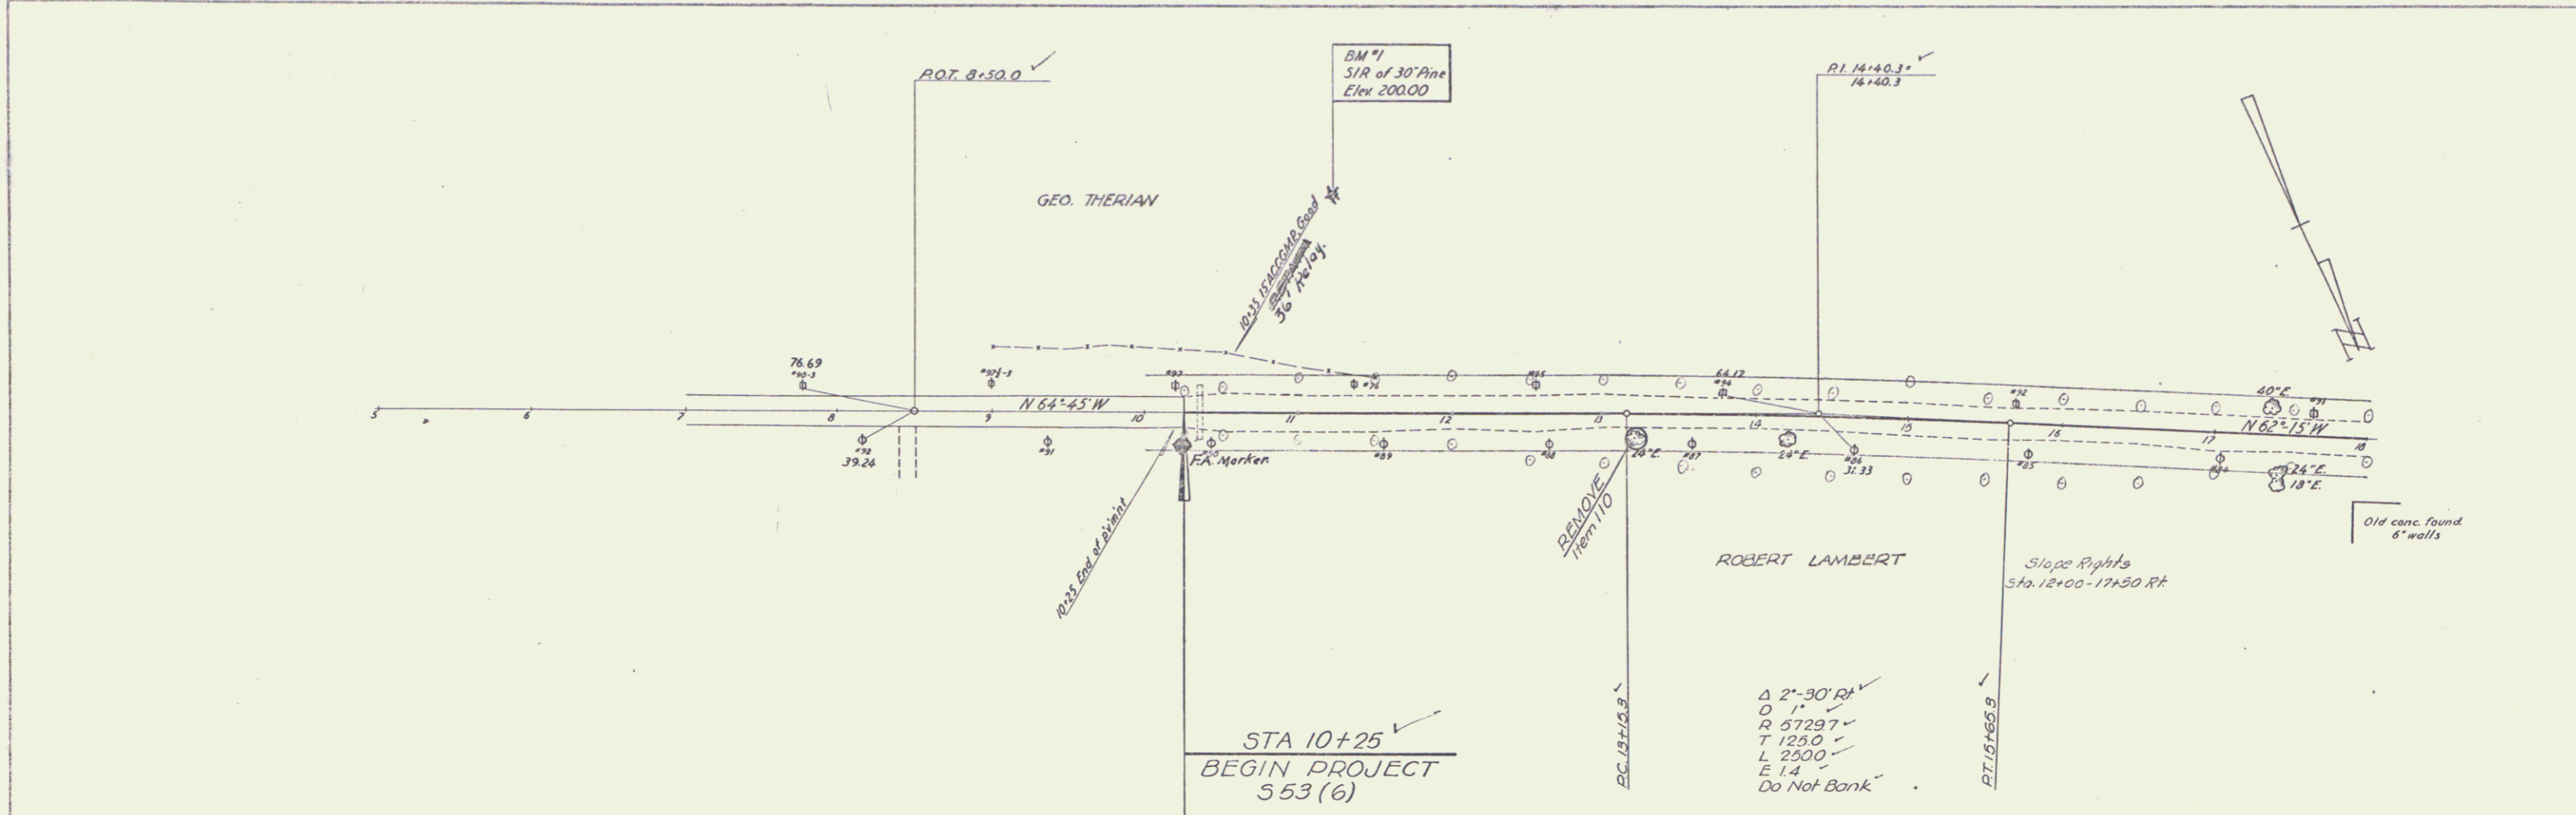

BAKERSFIELD  
 PROJ. 5 N 53(6)  
 Sheet 11 of 24