
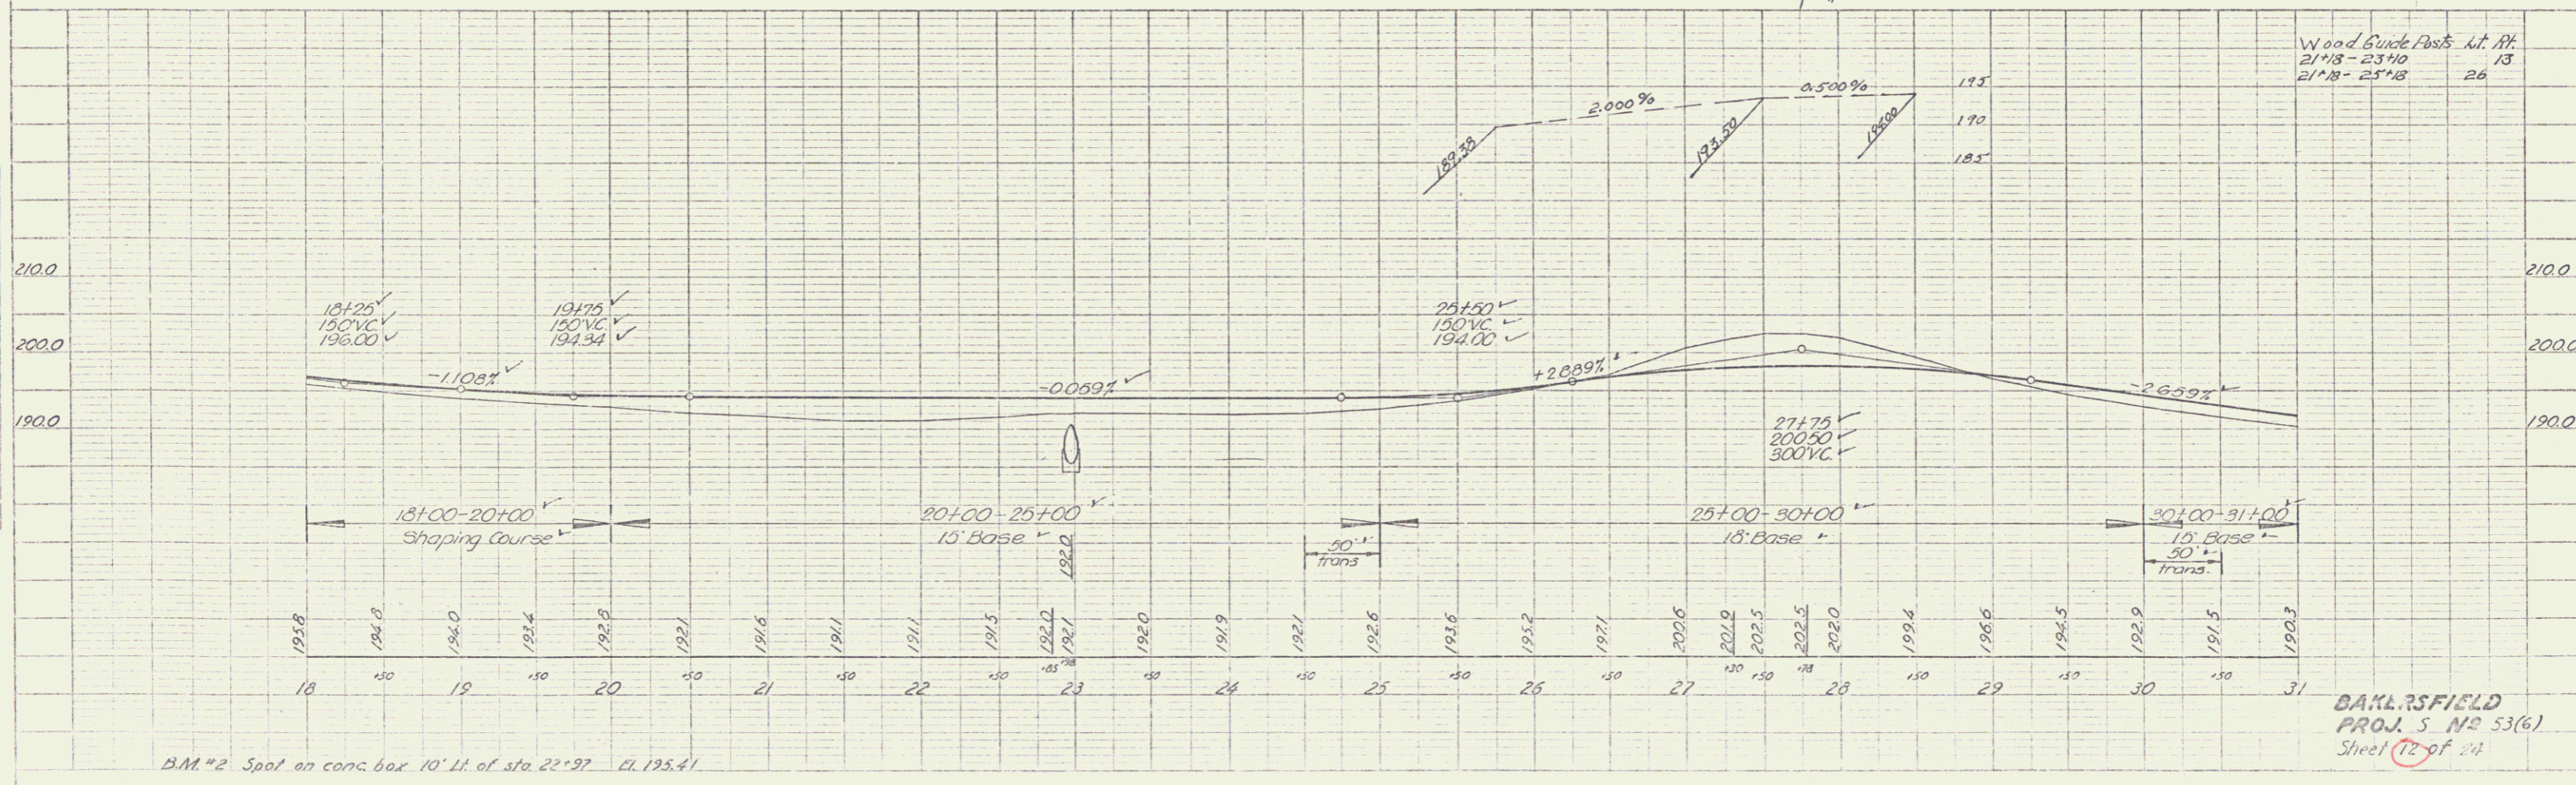


PLAN	DATE	BY
SPALLING	AUG 31	MILLER
DOCKLER	AUG 31	
NO.		

PROFILE	DATE	BY
SPALLING	AUG 31	MILLER
DOCKLER	AUG 31	
NO.		

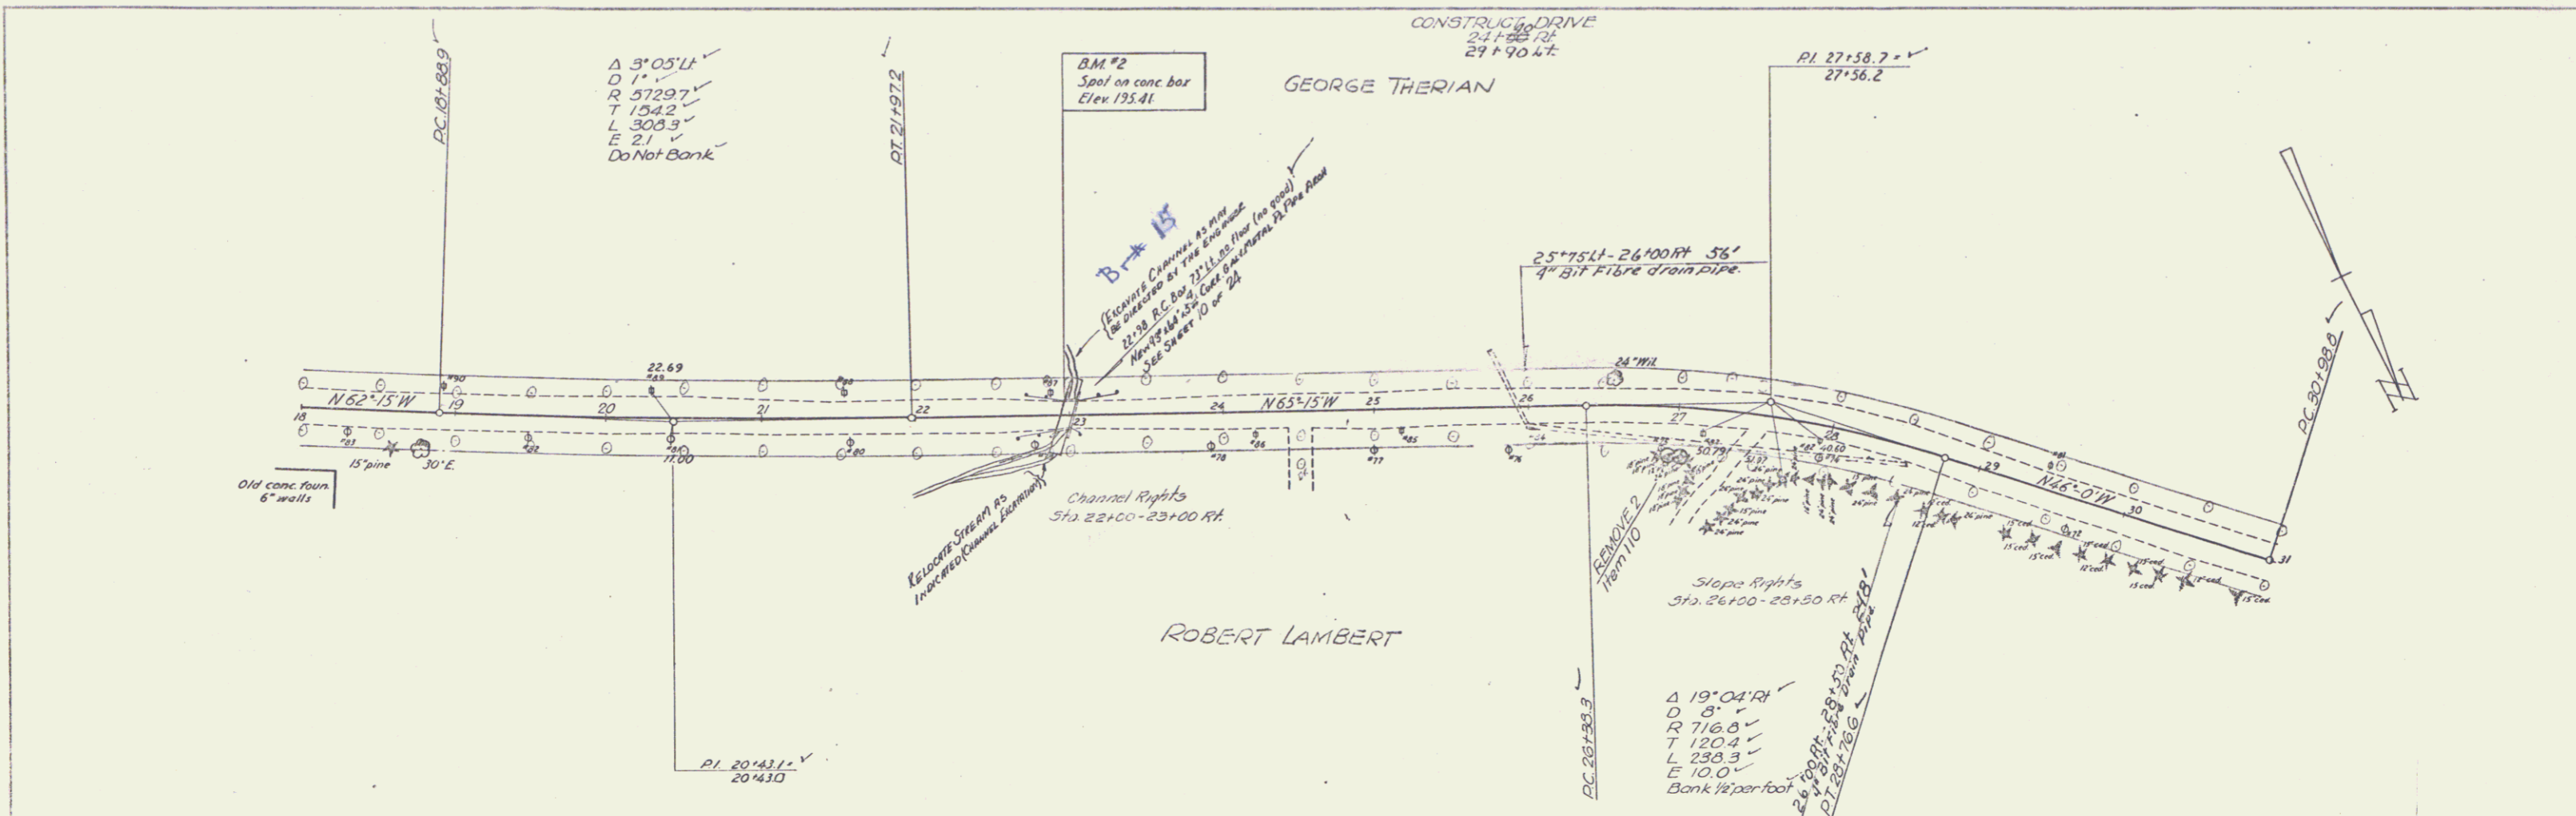

B.M. #2 Spot on conc. box 10' Lt. of sta. 22+97 El. 195.41

BAKERSFIELD  
PROJ. 5 NO. 53(6)  
Sheet 12 of 24