
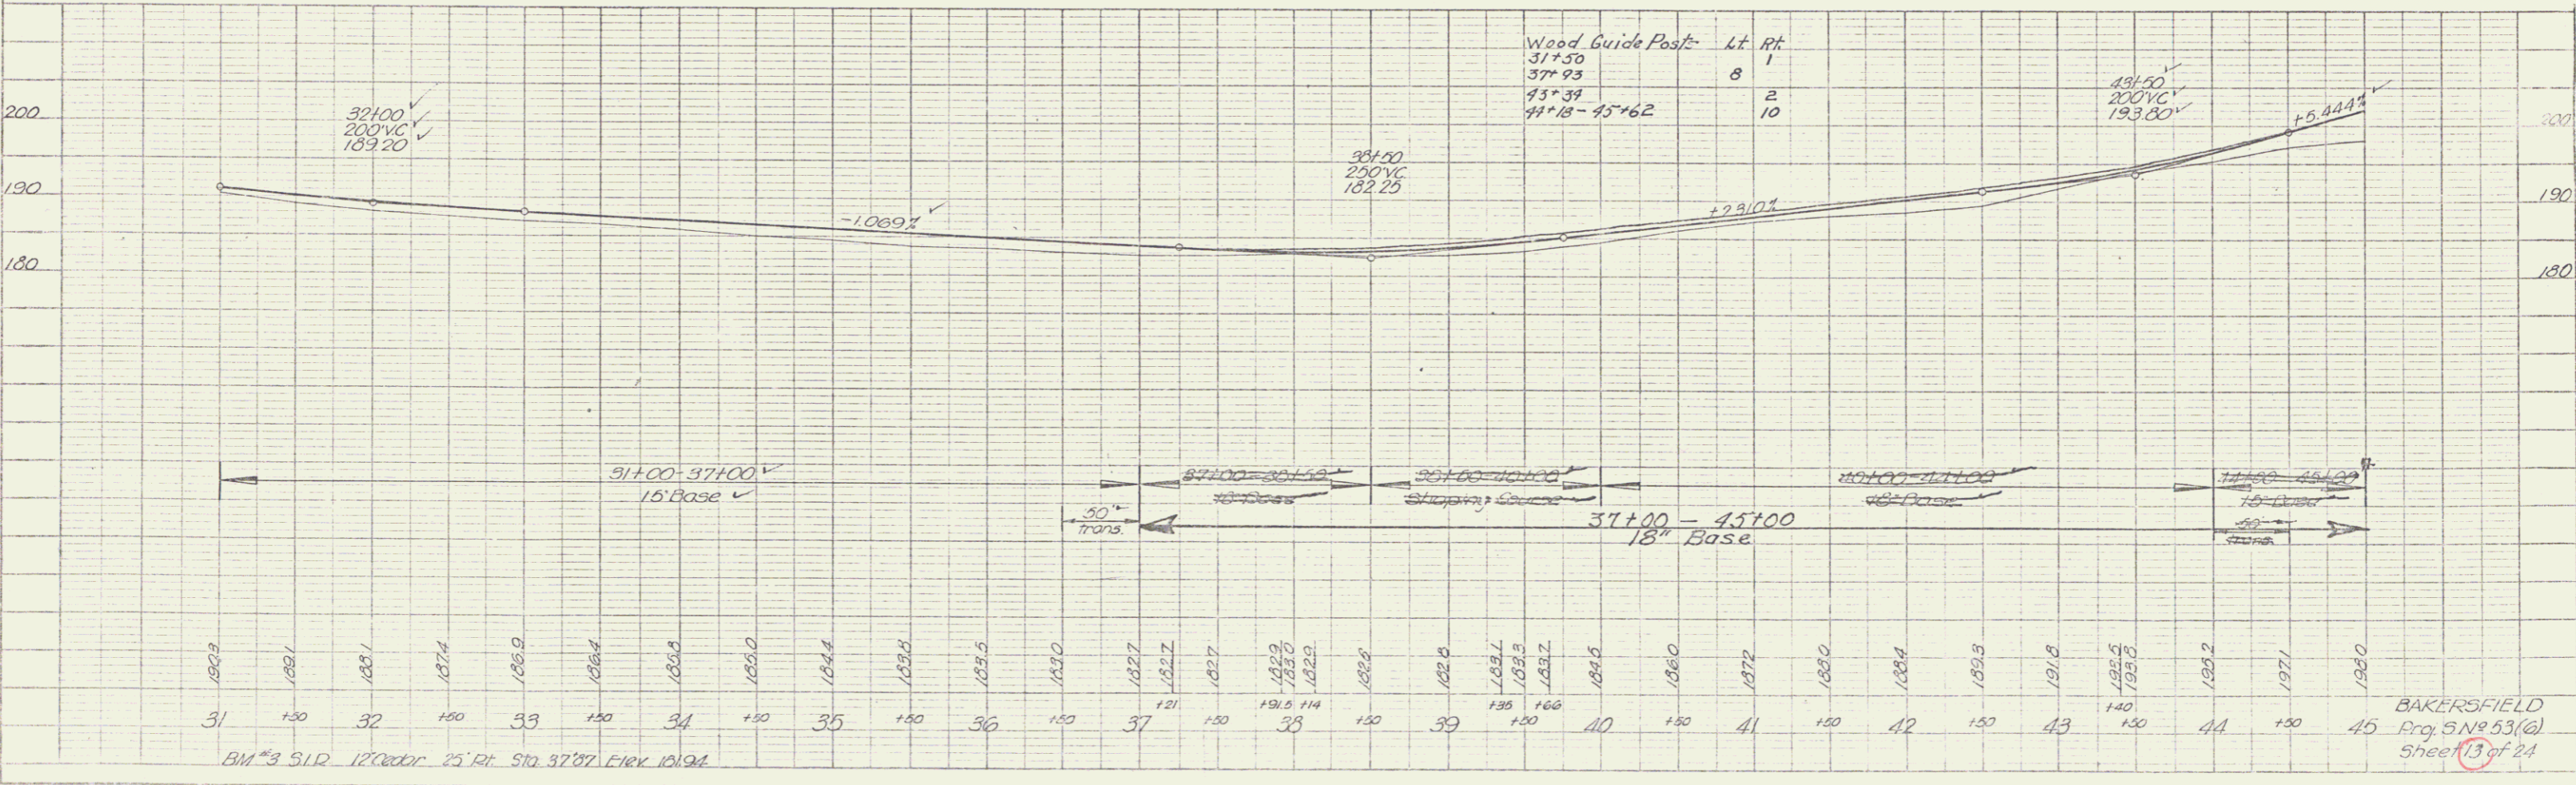


PLAN  
 DATE 9-22-32  
 DRAWN BY Spaulding  
 CHECKED BY Hurley  
 NOTE: SHOW GRADATIONS CHECKED.  
 1/2" = 100' HORIZ.  
 1/4" = 10' VERT.

PROFILE  
 DATE 9-22-32  
 DRAWN BY Spaulding  
 CHECKED BY Hurley  
 NOTE: SHOW GRADATIONS CHECKED.  
 1/2" = 100' HORIZ.  
 1/4" = 10' VERT.

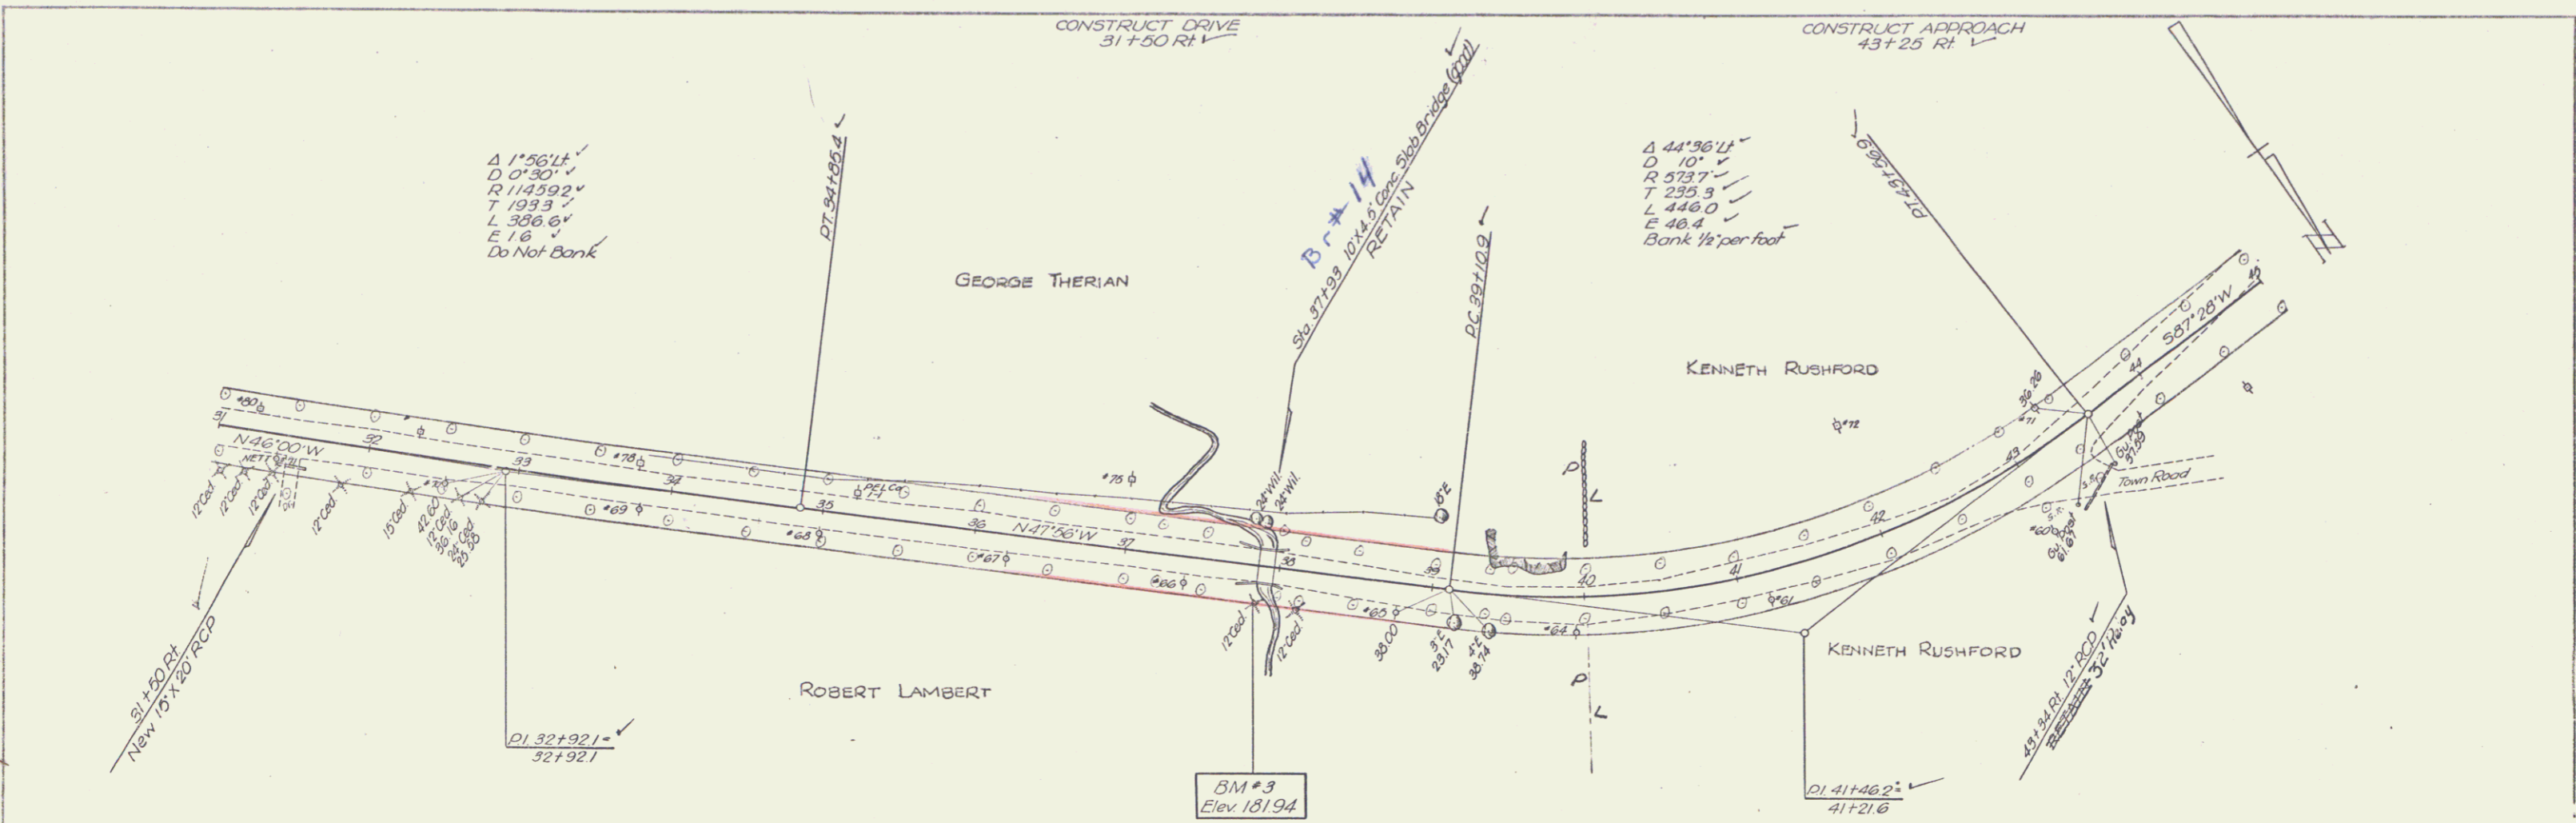

BM #3 312 12' Cedar 25' Rt. Sta. 37.87 Elev. 181.94

BAKERSFIELD  
 Proj. 5 No. 53(a)  
 Sheet 13 of 24

PLATE 1 - PLAN - PROFILE - P. & R. E. STANBRO  
 1817 - 1818 - 1819 - 1899 - 1900