


PLAN
 DATE: 8/27/2013
 DRAWN BY: [Signature]
 CHECKED BY: [Signature]
 PROJECT: [Signature]

PROFILE
 DATE: 8/27/2013
 DRAWN BY: [Signature]
 CHECKED BY: [Signature]
 PROJECT: [Signature]

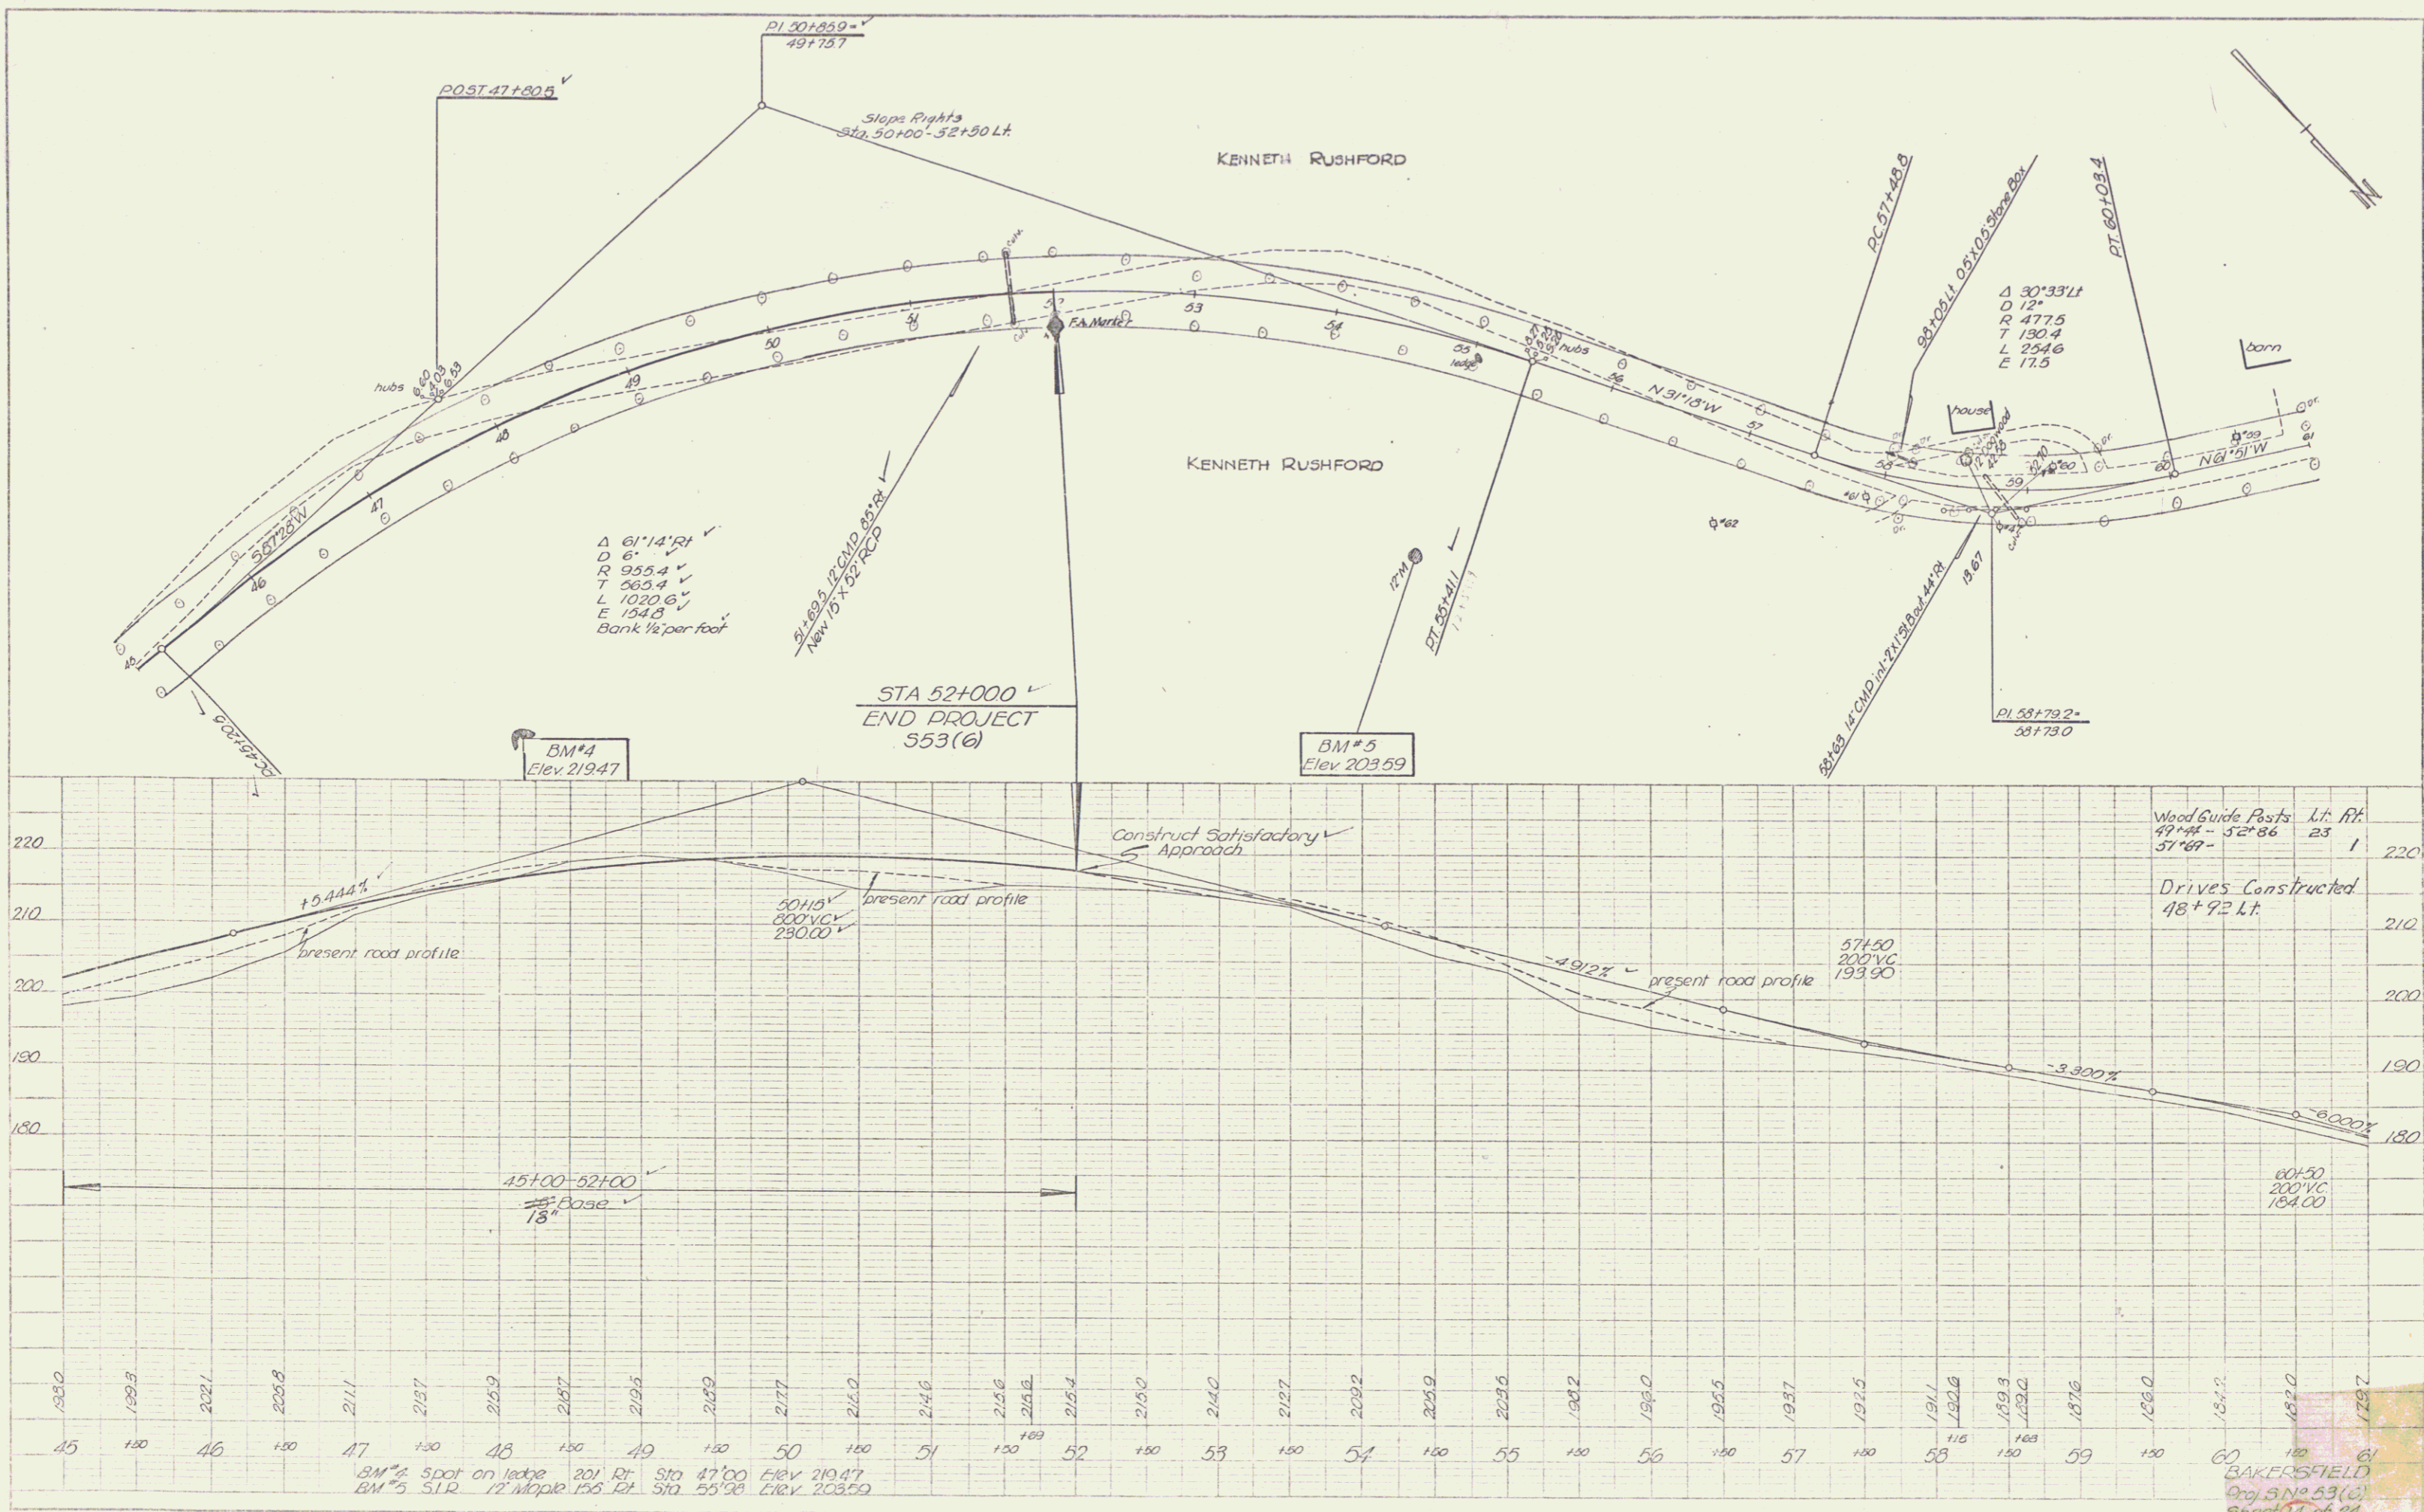

DATE: 8/27/2013
 DRAWN BY: [Signature]
 CHECKED BY: [Signature]
 PROJECT: [Signature]

BAKERSFIELD
 Proj. No. 53(6)
 Sheet 14 of 24