
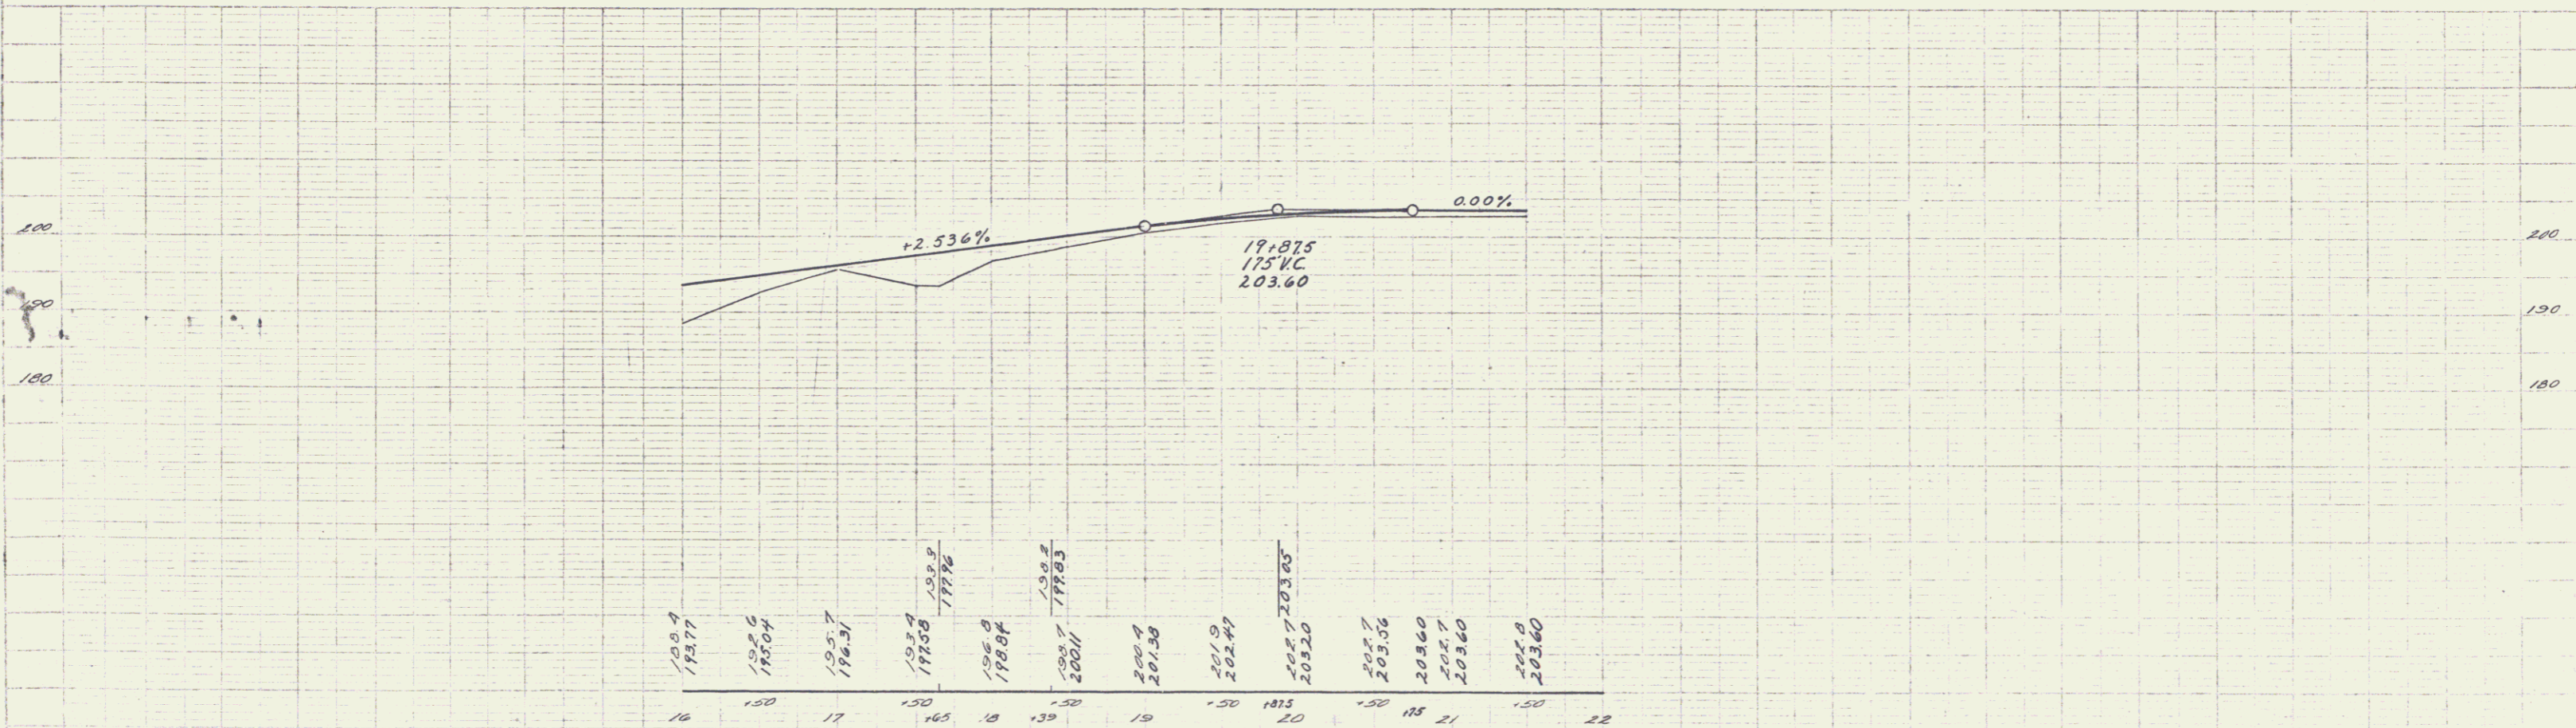


R/L Survey
 R/L Burey
 Projected
 R/L Burey

Δ 4-30LT
 D 1
 R 5720.6
 T 231.0
 L 463.3
 E 4.7

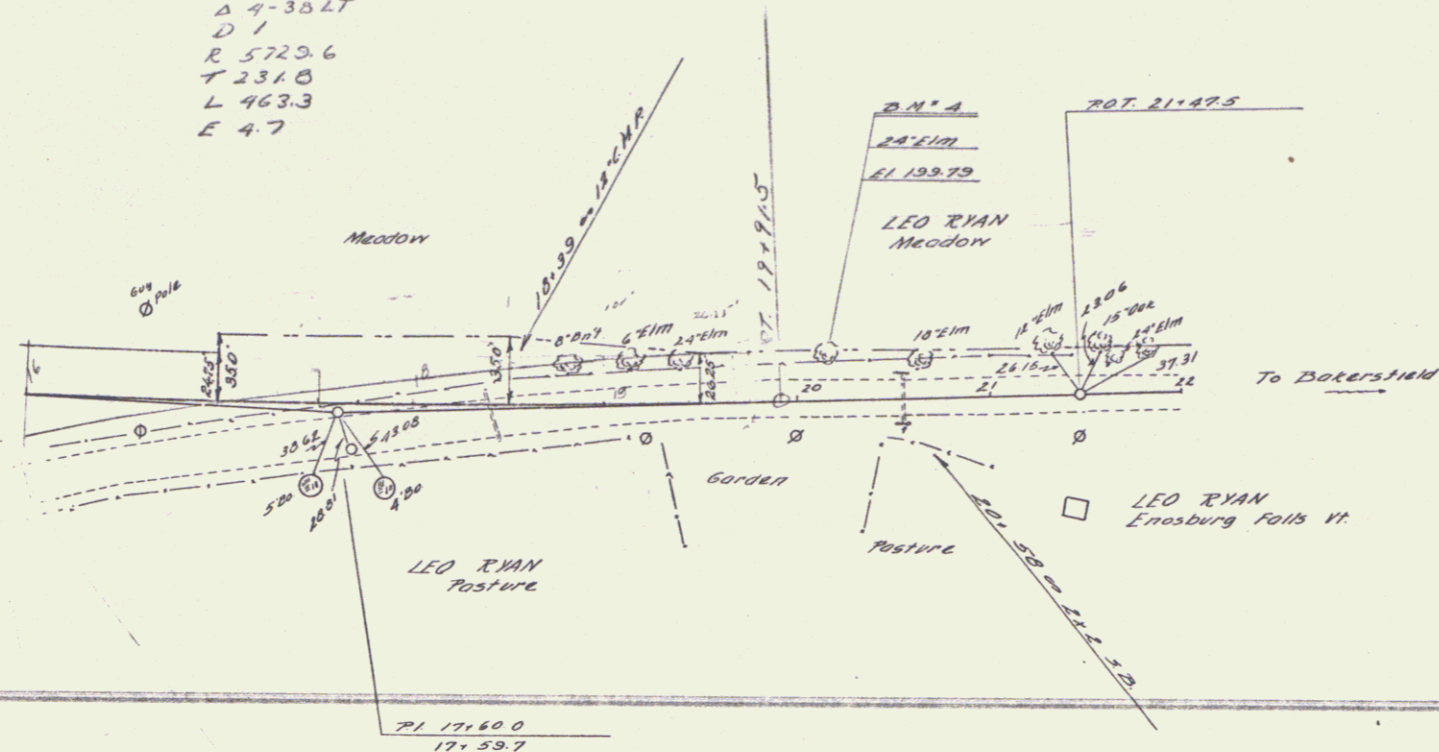

D.M.'s SPIKE IN ROOT OF 24' ELM 19' LT STA 18+14 ELEV 199.79

SERIES NO
 SHEET 2 OF 8
 Fairfield Fiddlers Elbow
 2