

VT 38
3-ROAD ROW

TOWN OF ST. ALBANS


Project MA 3017

Pin # 99R975


Route VT38

Date 8/13/1990

MP 0.00-3.345

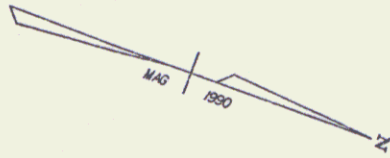

CURVE #1
 $\Delta = 0^{\circ} 44' 58''$ LT
D = $2^{\circ} 00' 00''$
R = 2864.79'
T = 18.74'
L = 37.47'
E = 0.06'

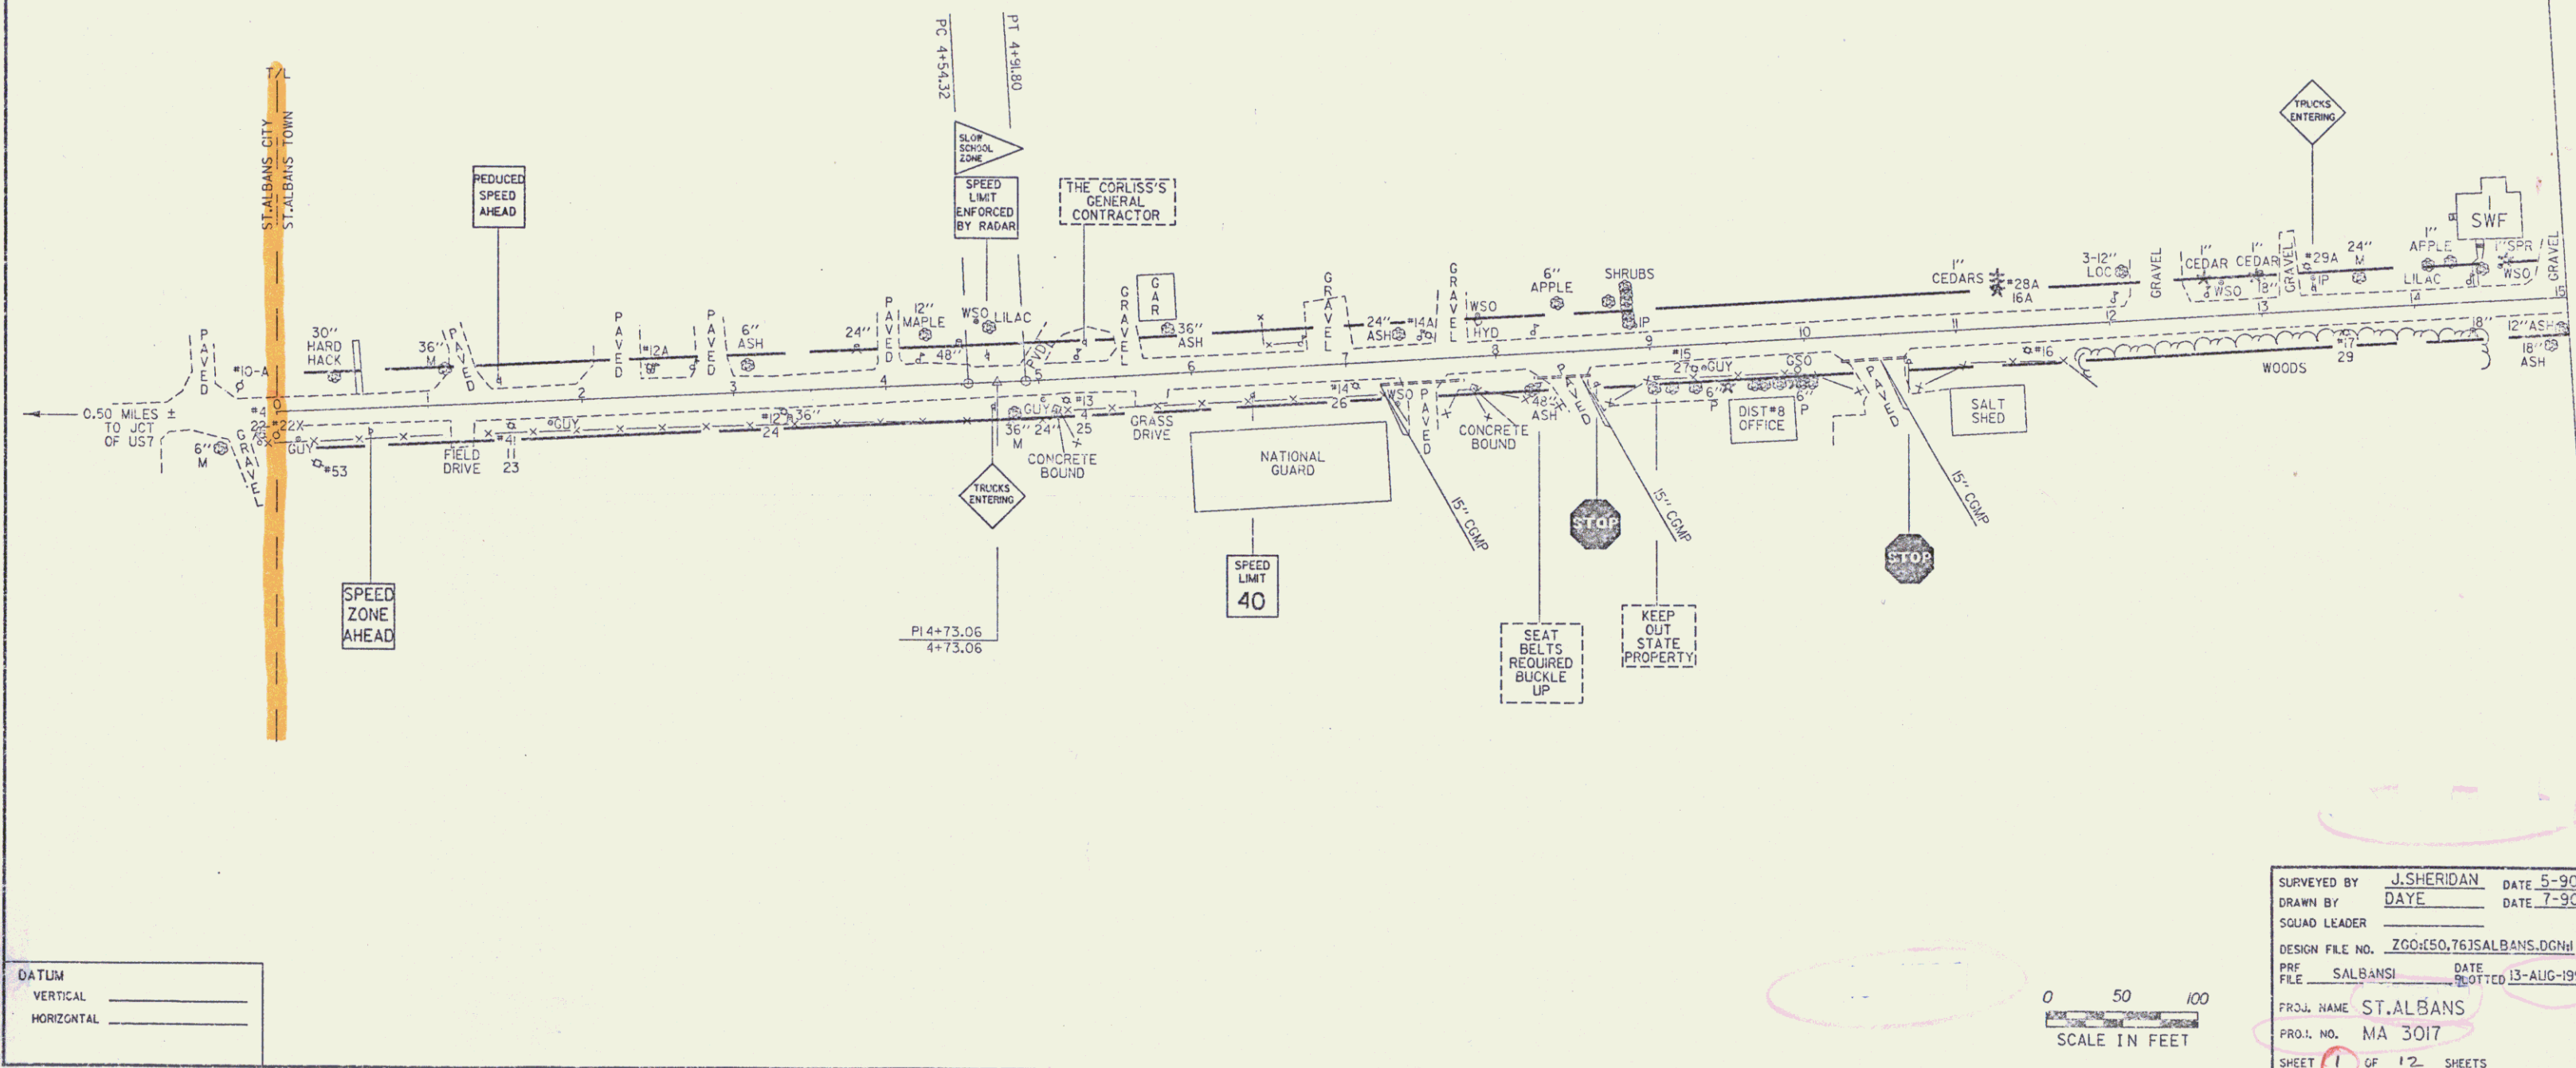

DATUM
VERTICAL _____
HORIZONTAL _____

0 50 100
SCALE IN FEET

SURVEYED BY	J. SHERIDAN	DATE	5-90
DRAWN BY	DAYE	DATE	7-90
SQUAD LEADER			
DESIGN FILE NO.	ZG0150.76JSALBANS.DGNH		
PRJ FILE	SALBANSI	DATE PLOTTED	13-AUG-1990
PRJL NAME	ST. ALBANS		
PRJL NO.	MA 3017		
SHEET	1	OF	12 SHEETS

Checked 3/22/00 ML