
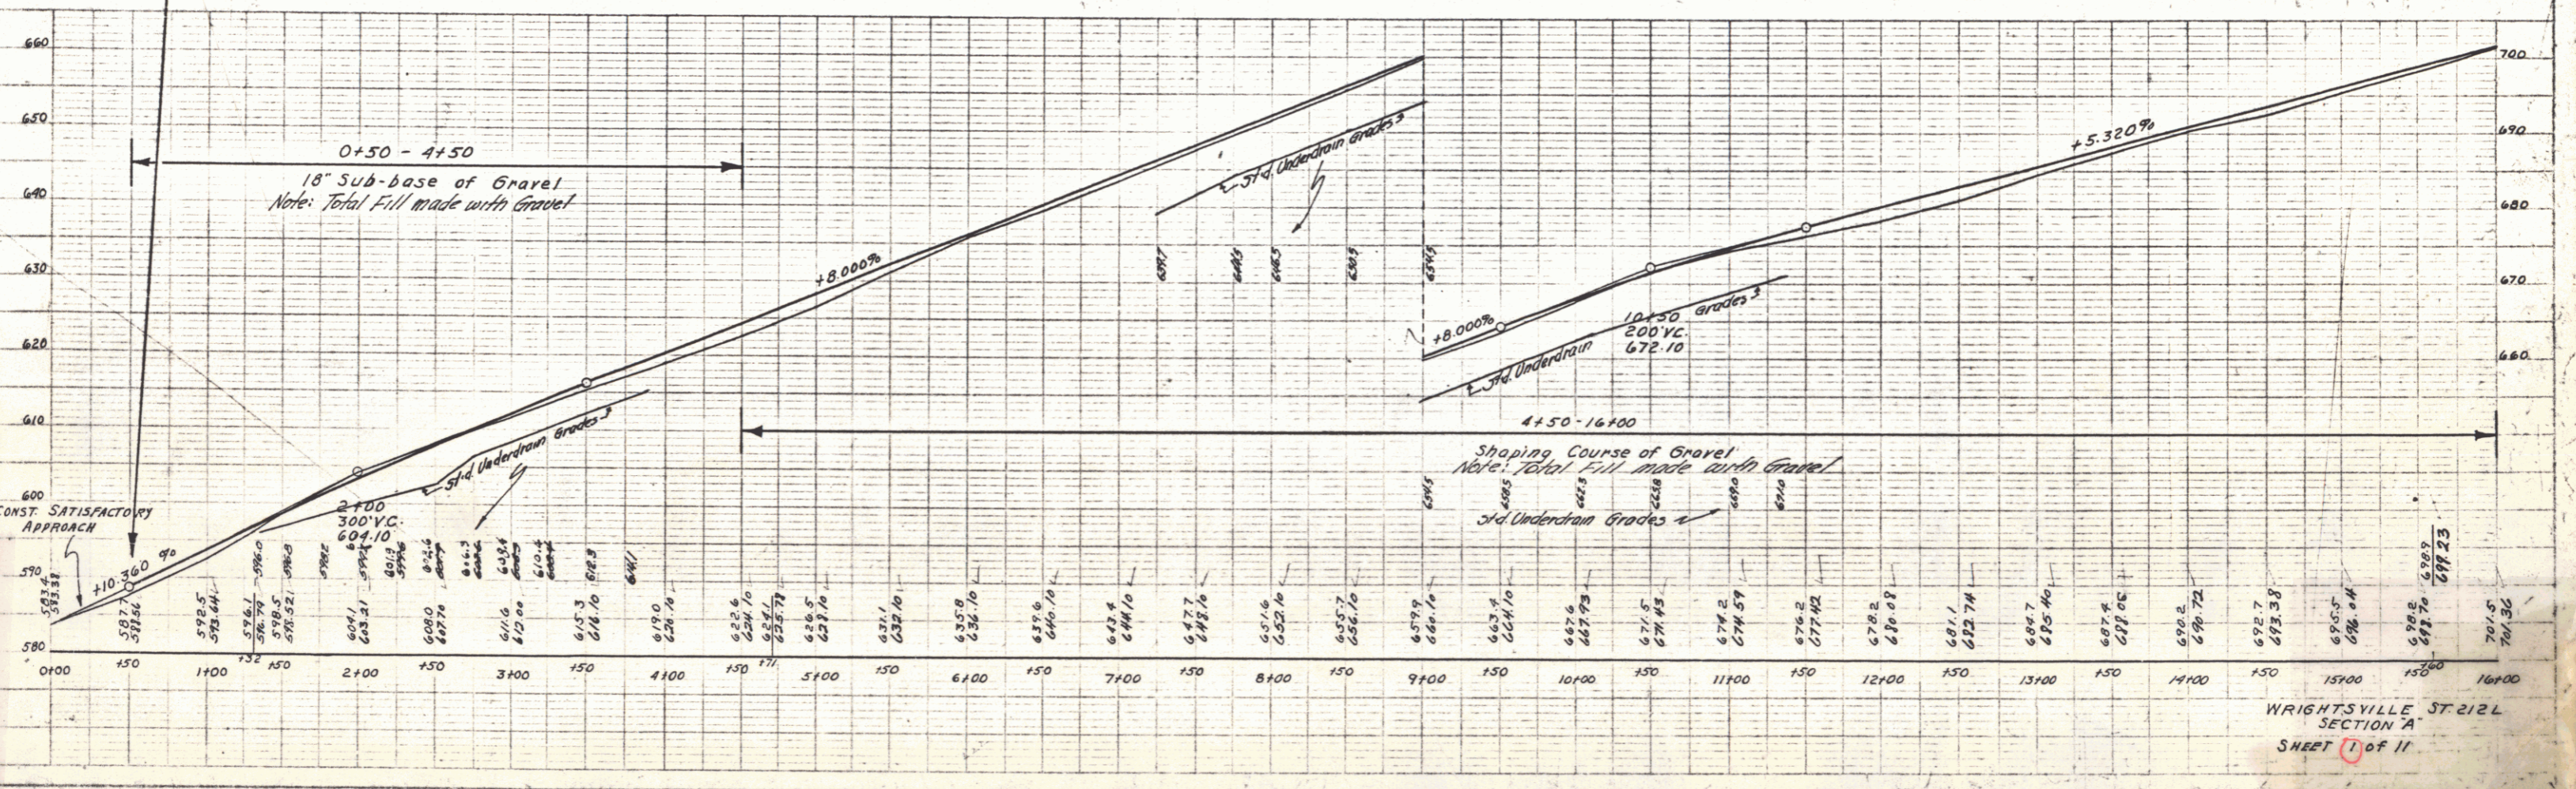


PLAN  
 1" = 100'  
 1/4" = 10'

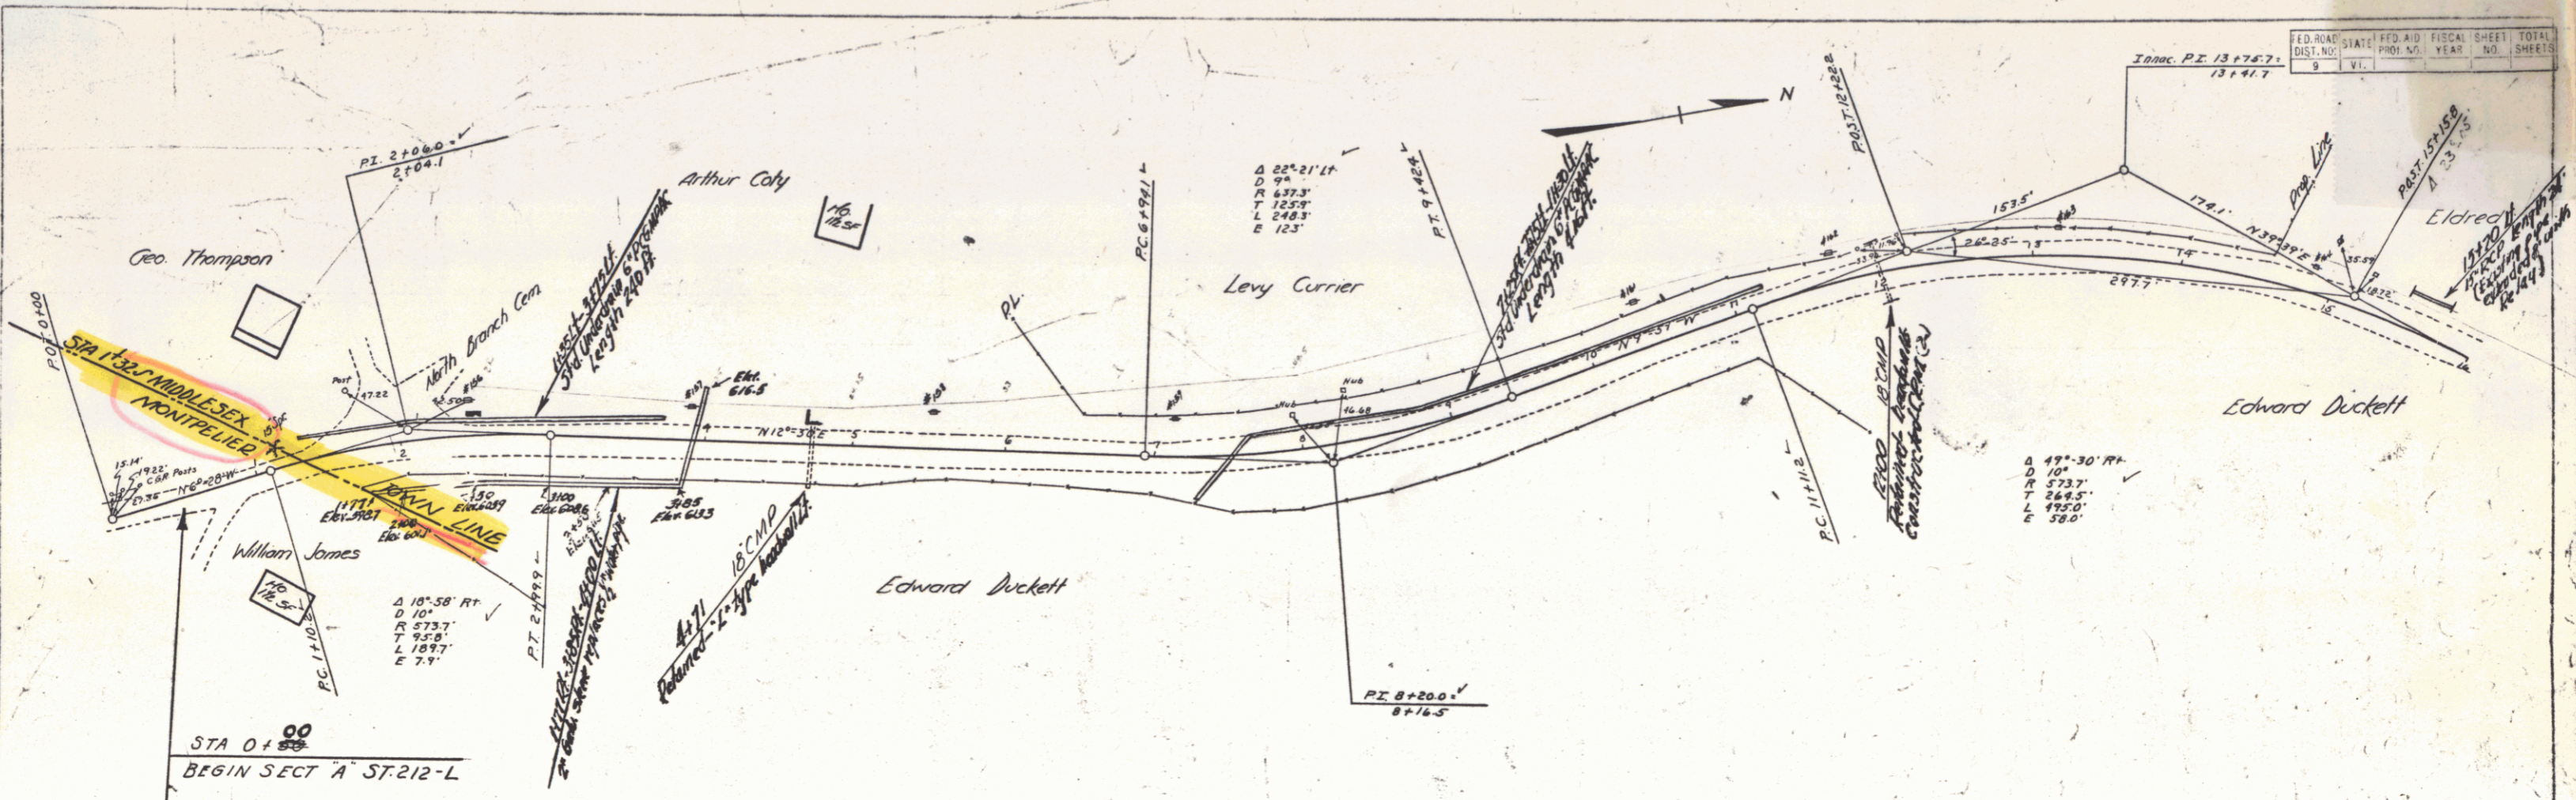

WRIGHTSVILLE ST. 212-L  
 SECTION A  
 SHEET 1 of 11