
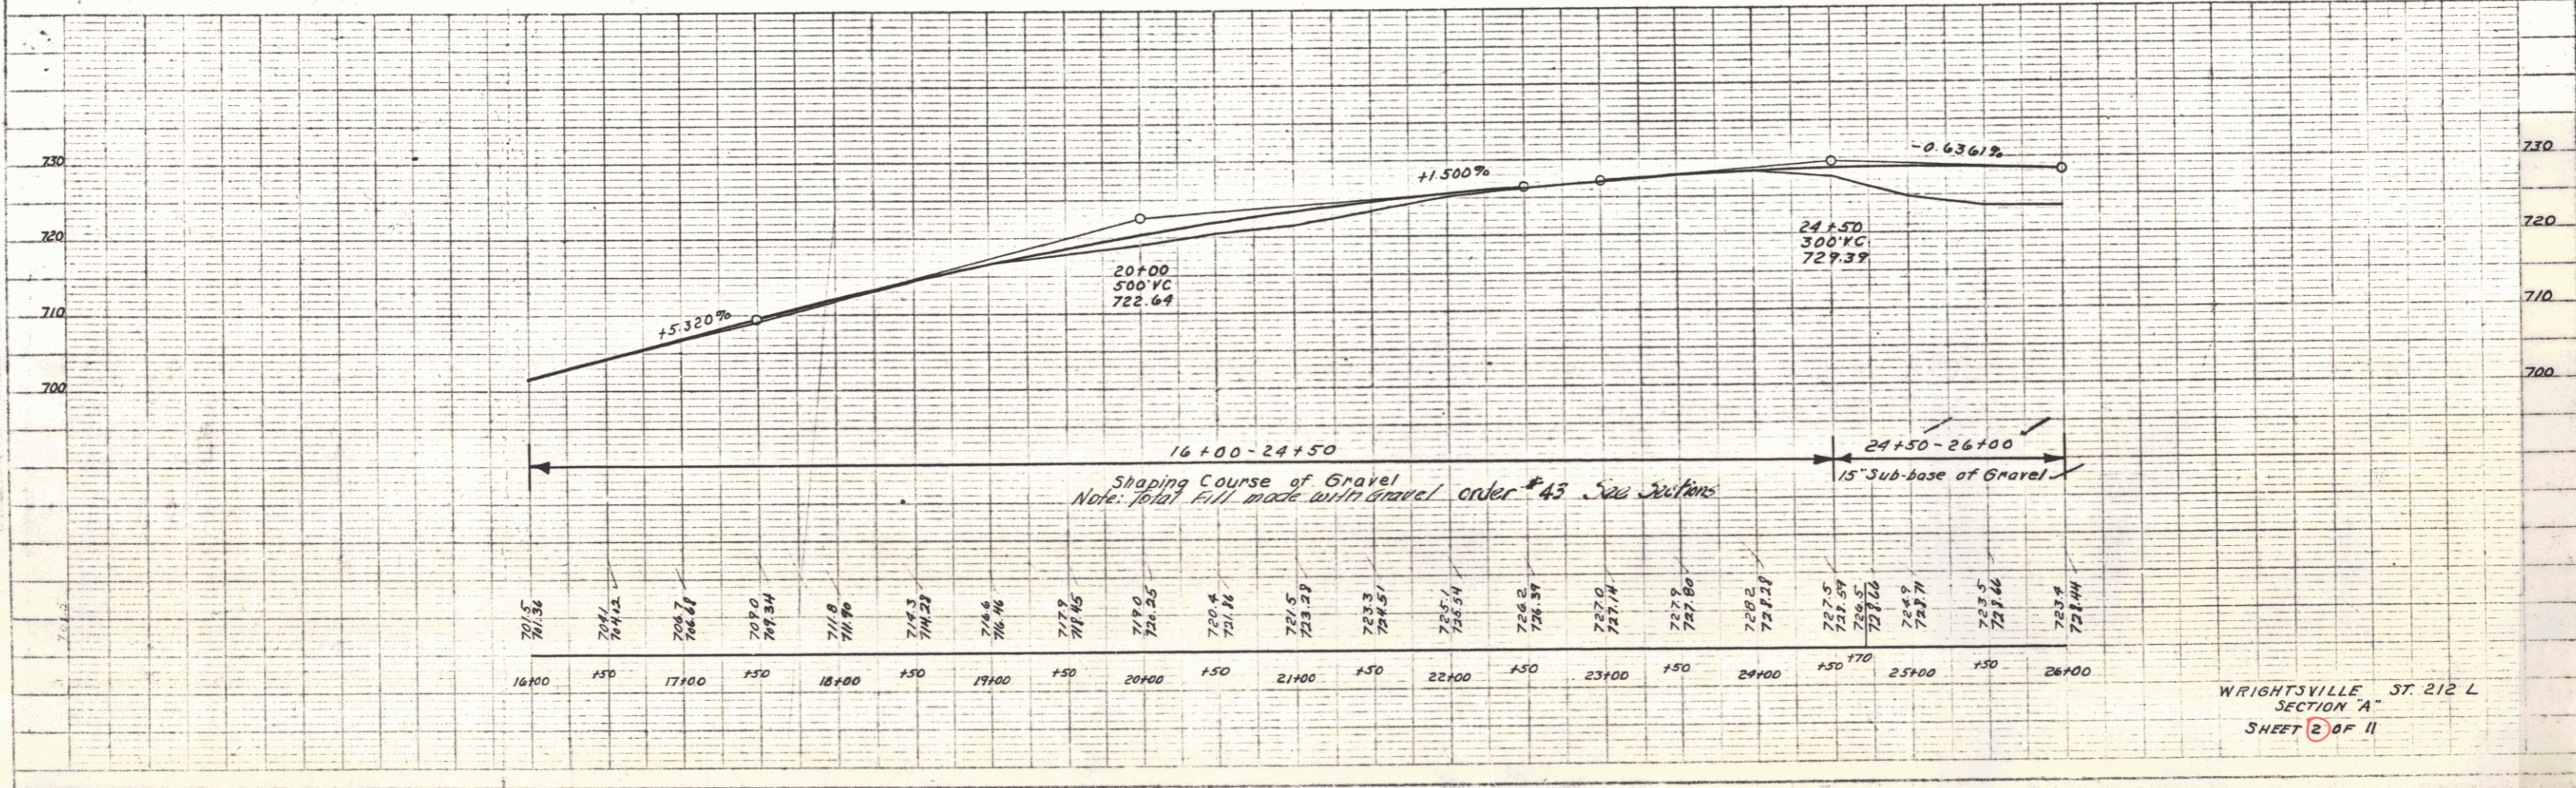


PLAN
 PROJECT: ...
 DRAWN BY: ...
 CHECKED BY: ...

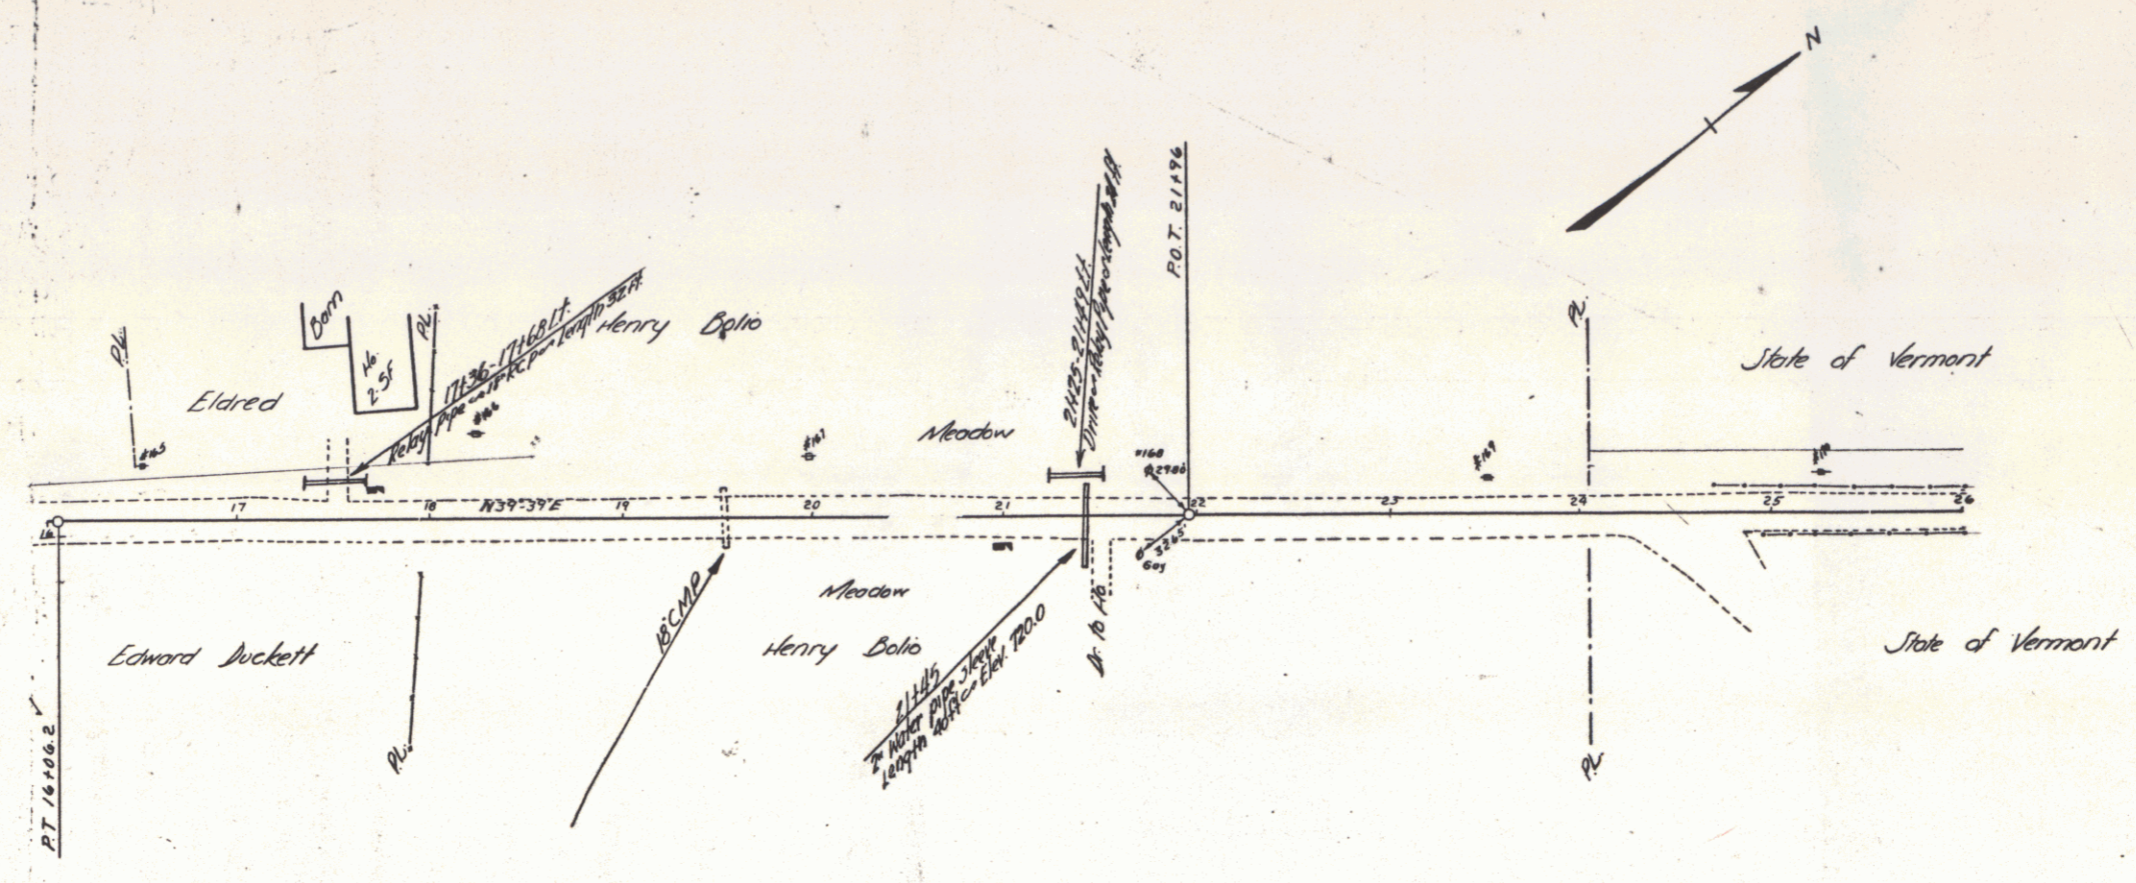

WRIGHTSVILLE ST. 212 L
 SECTION "A"
 SHEET 2 OF 11