



Johns
Birras
Palmer
Prest

Palmer
Reynolds

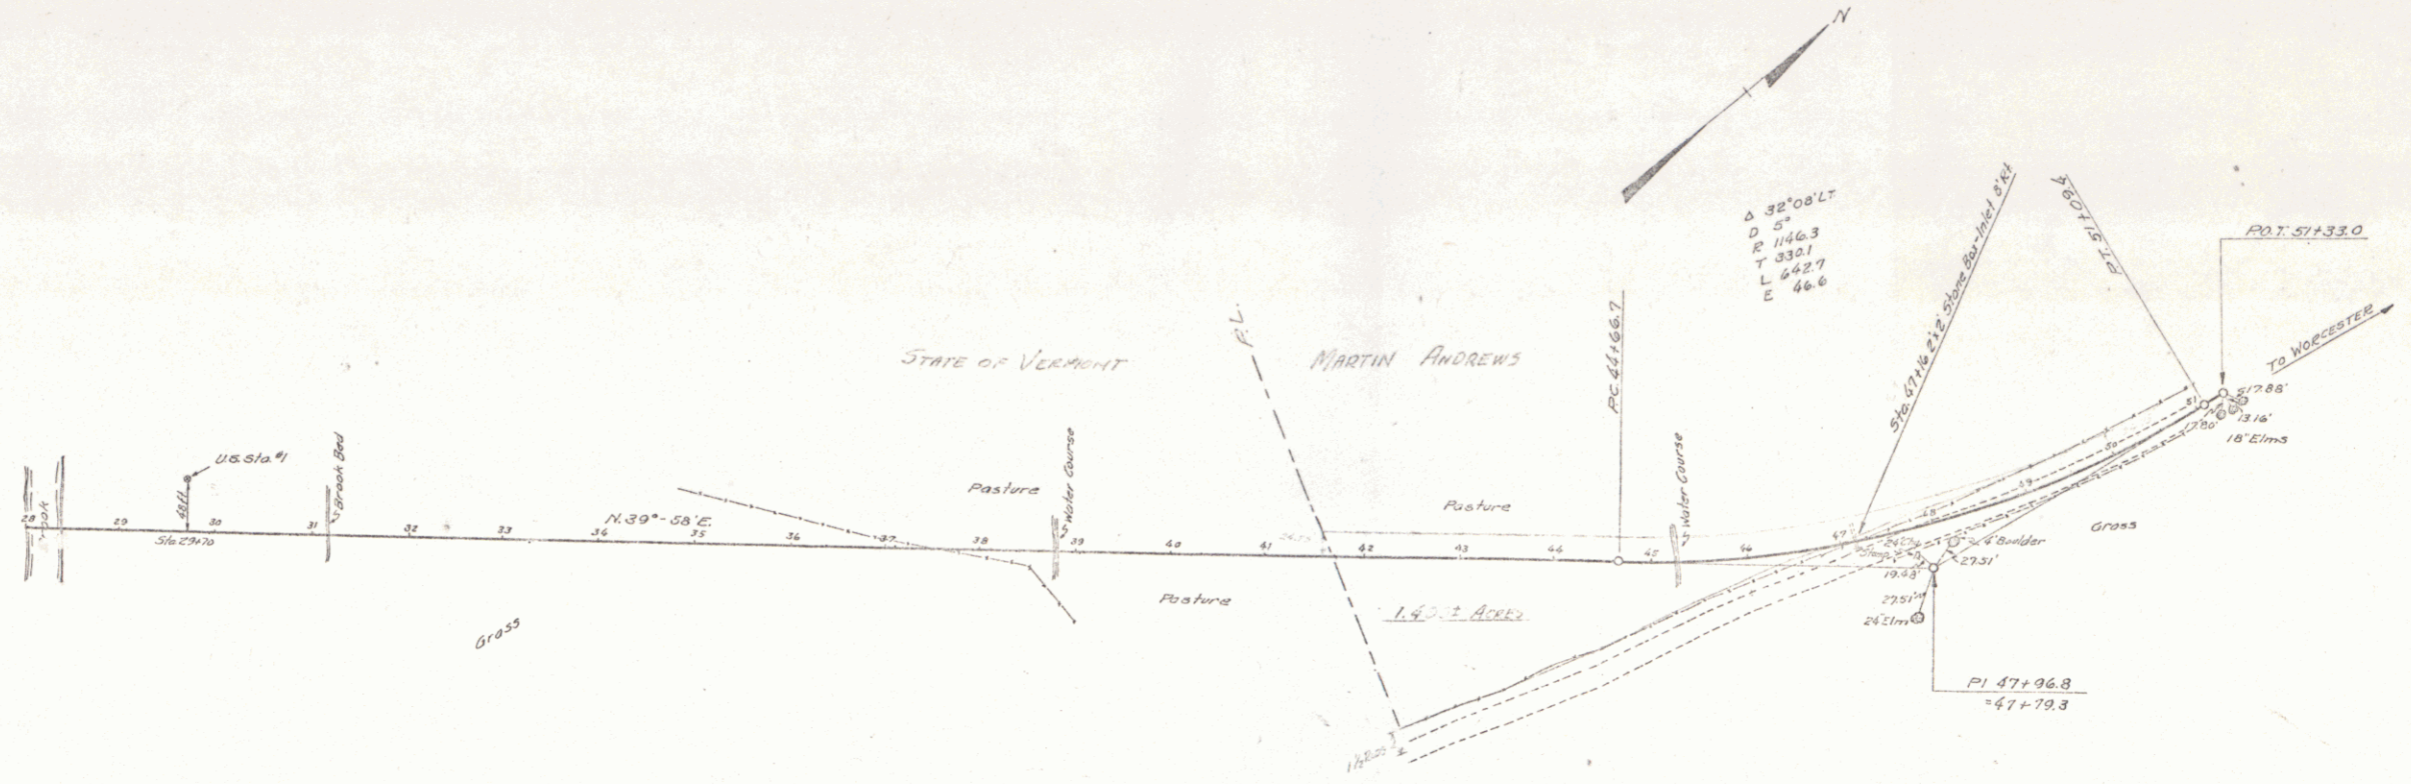

SCALE = 1 INCH = 100 FEET

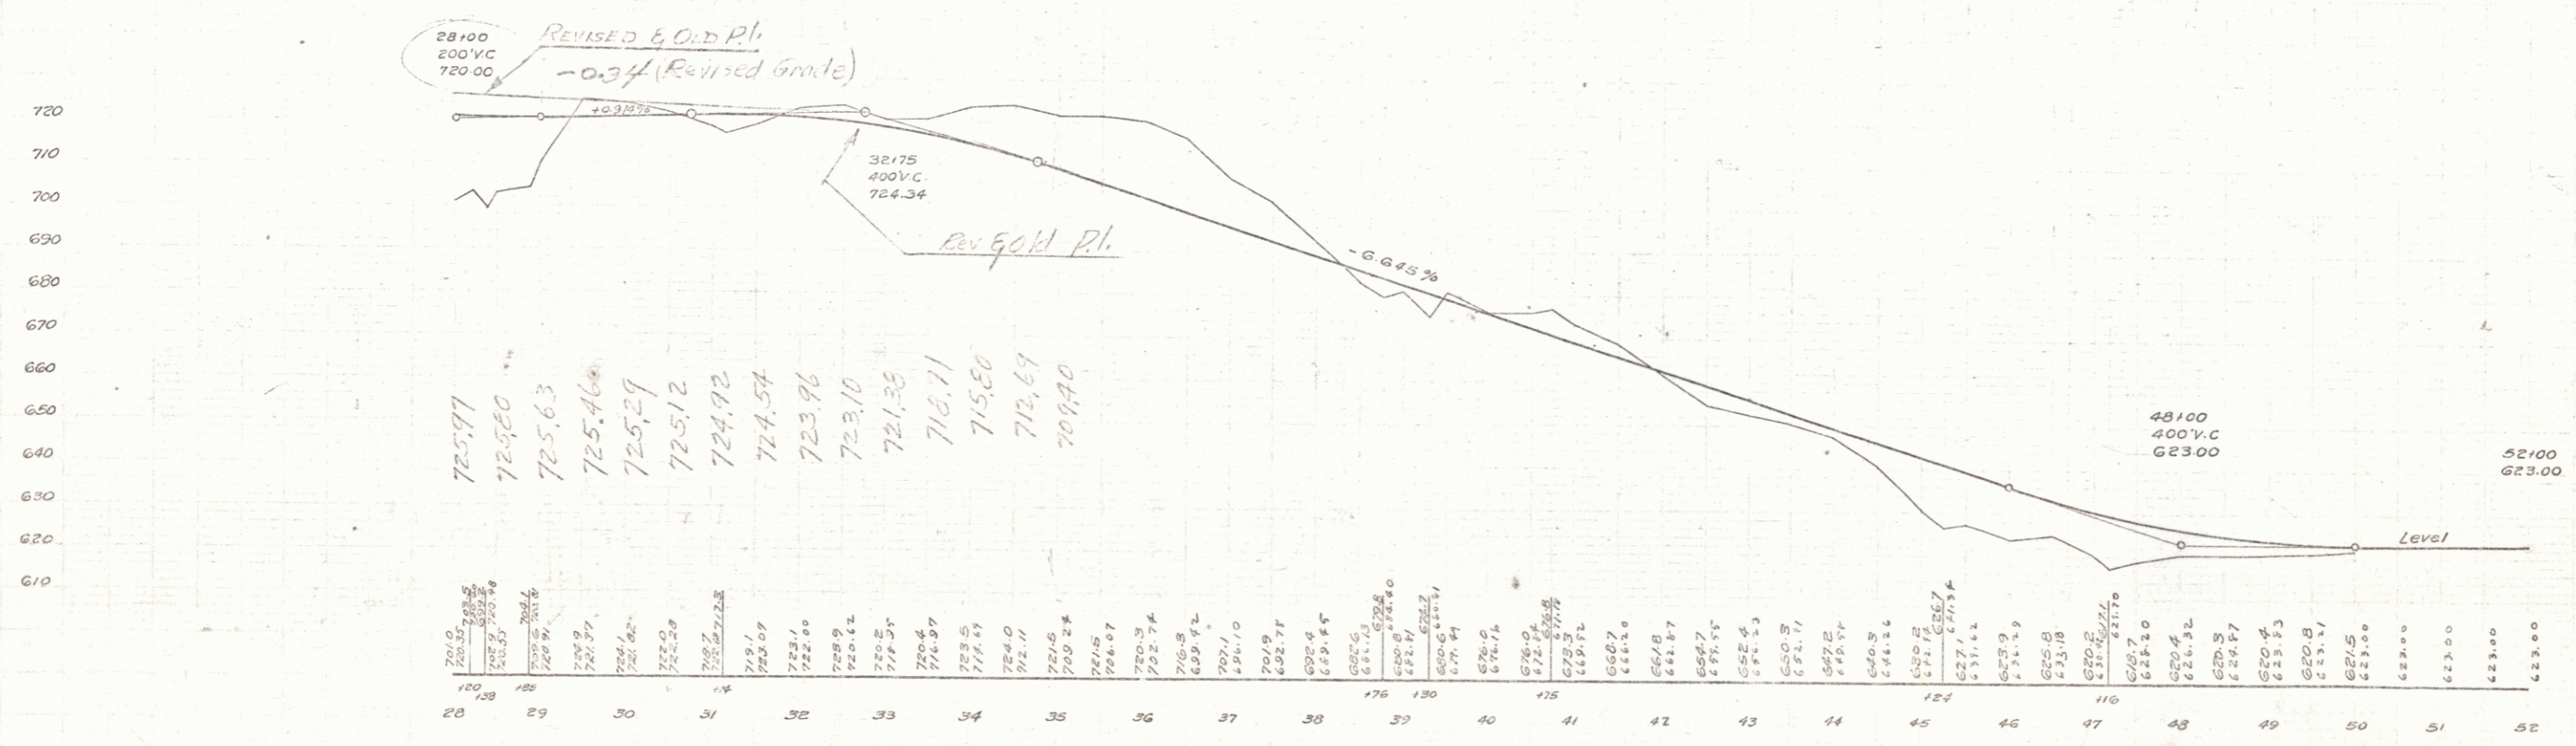

MONTPELIER-MIDDLESEX
Wrightsville Relocation
Sheet 85 of 85