



PLAN
 DATE MAY 1954
 DRAWN BY L. L. L. L.
 CHECKED BY L. L. L. L.
 PROJECT
 SHEET NO. 10 OF 10

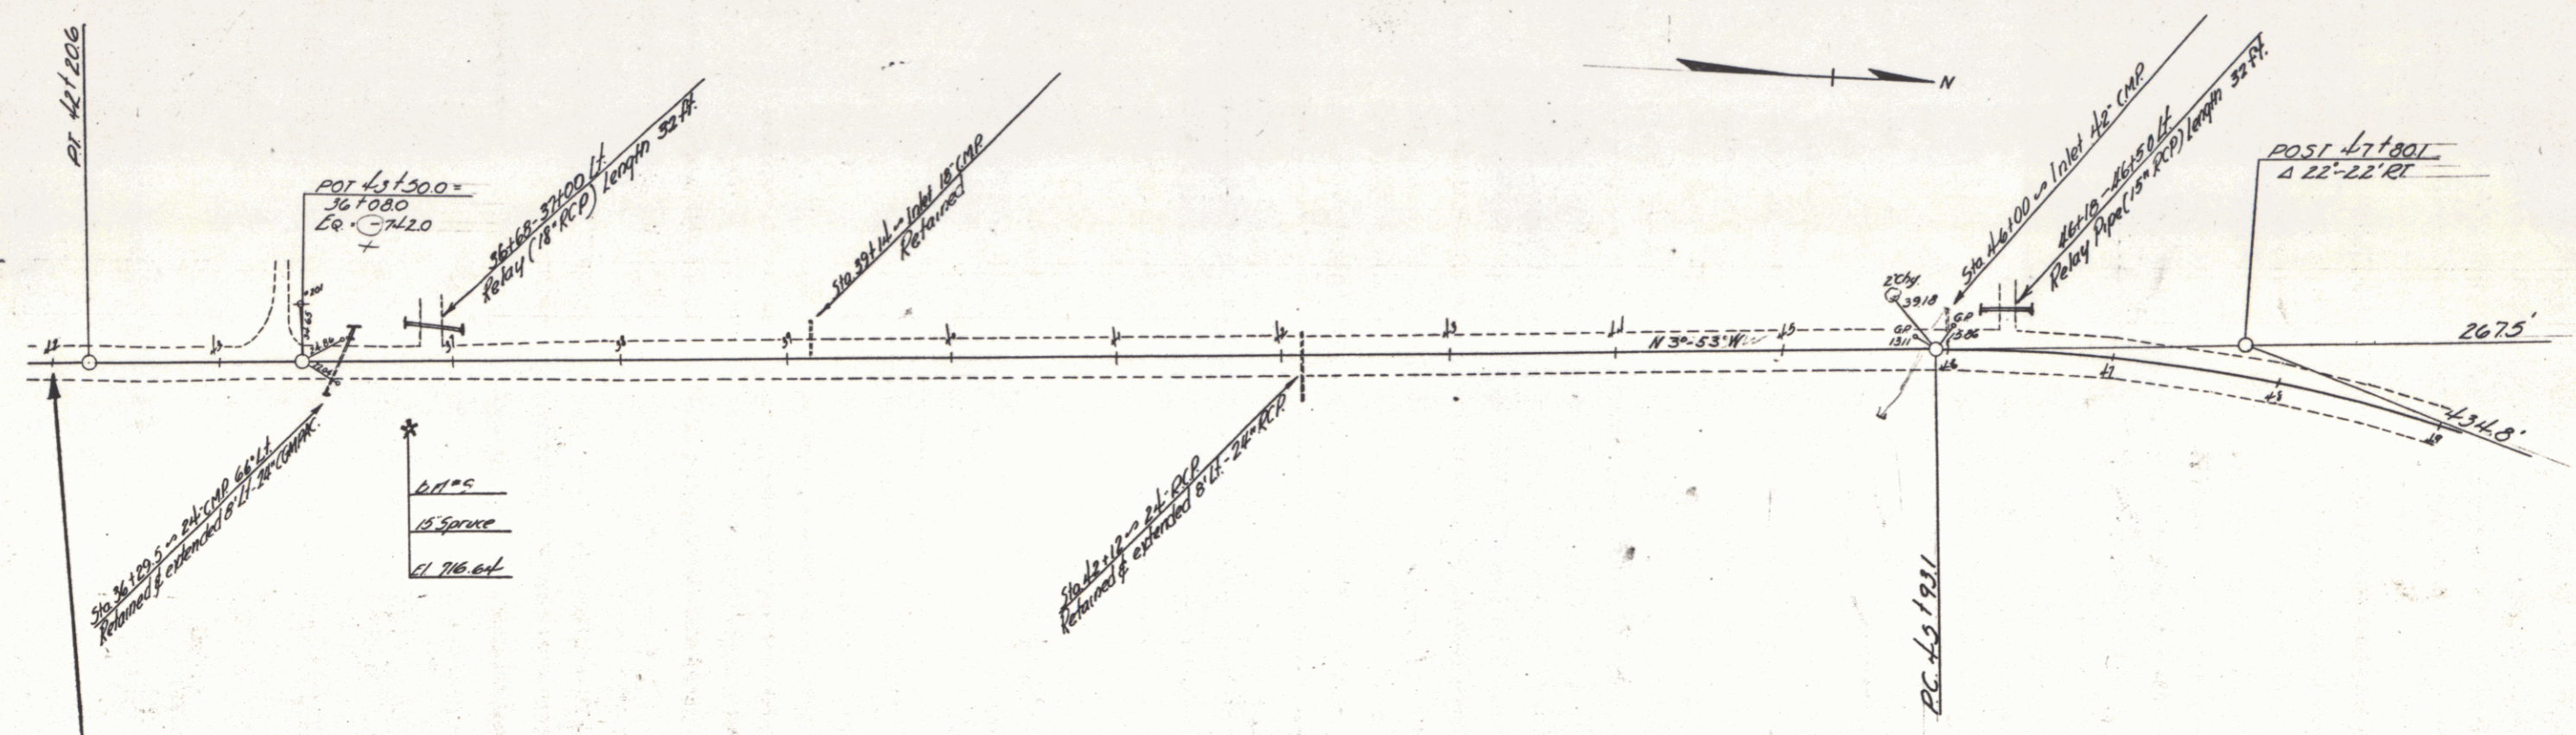

STA 42+00 STA 42+00
 END SECT "A" ST 212-L BEGIN SECT "B" ST 212-L

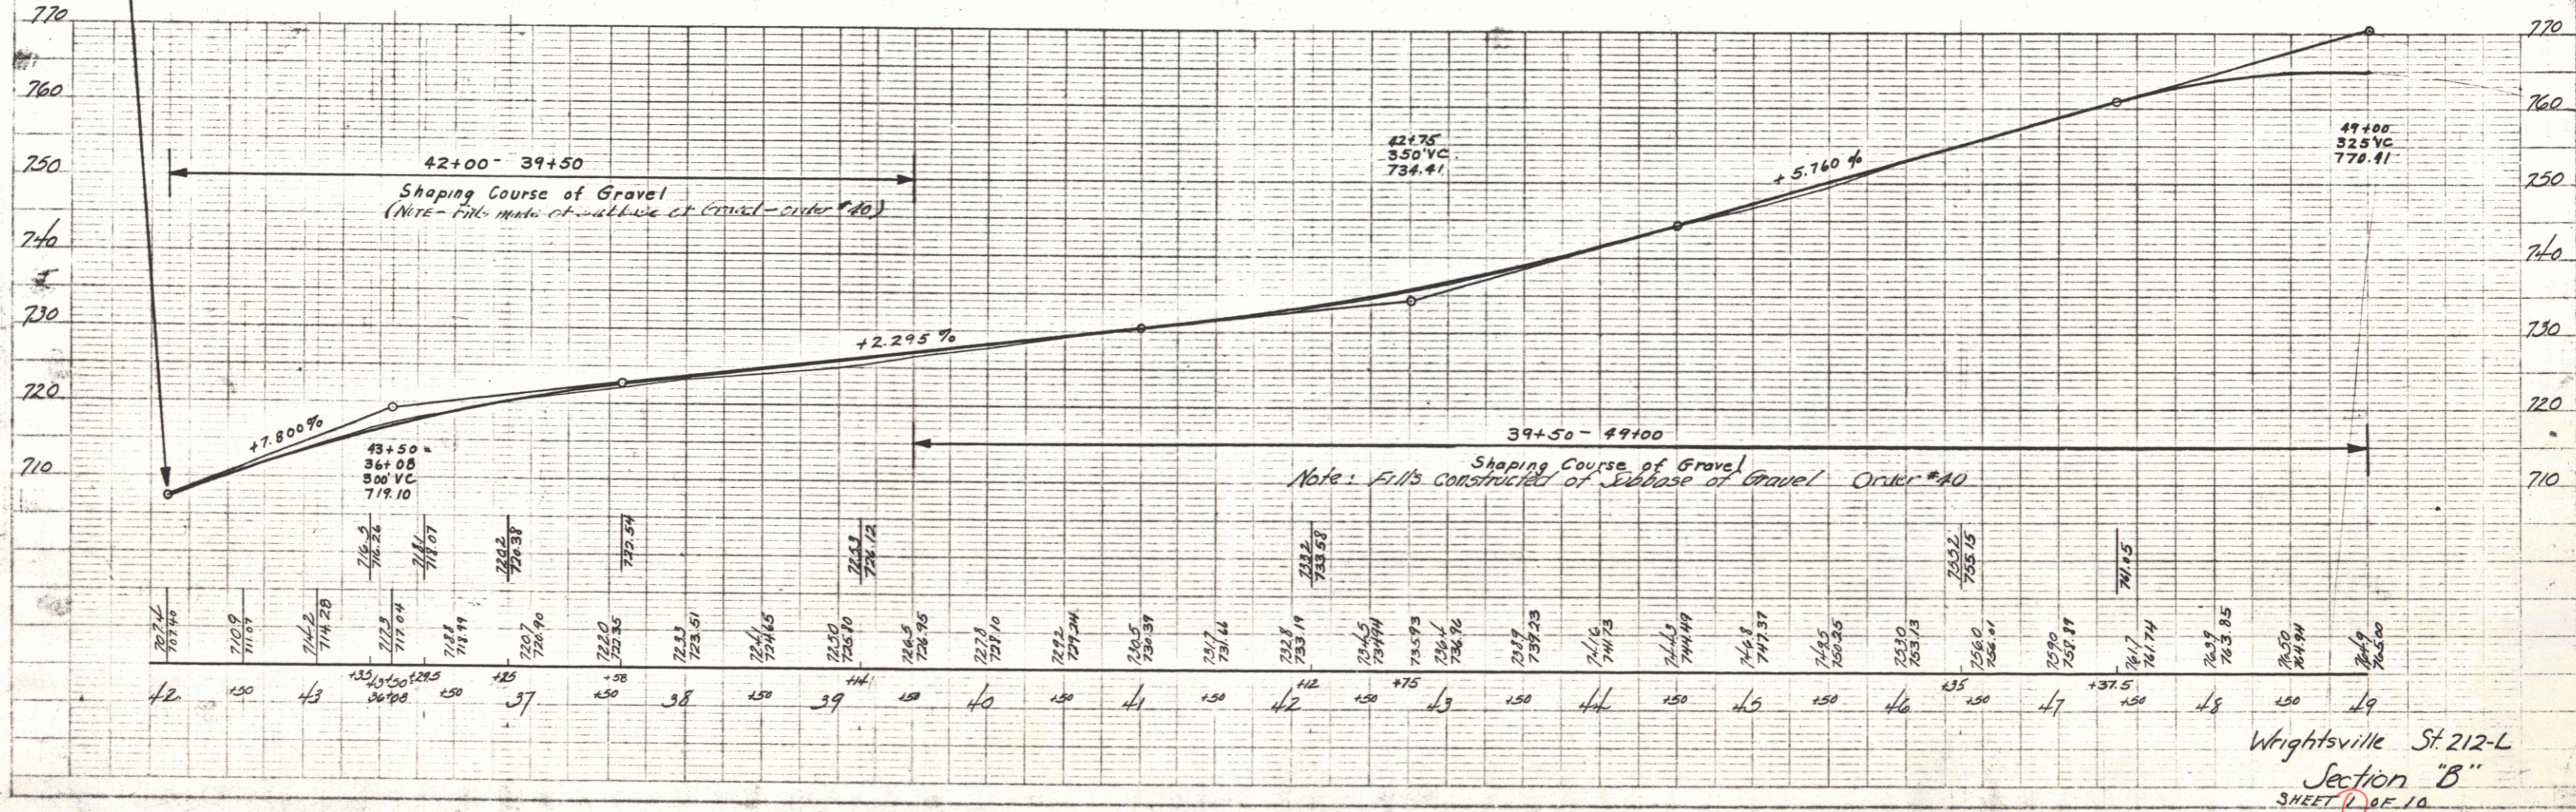

Wrightsville St. 212-L
 Section "B"
 SHEET 10 OF 10

PLATE 1 - PLAN - PROFILE - 1" = 40' - 1" = 10' - 1" = 10'