
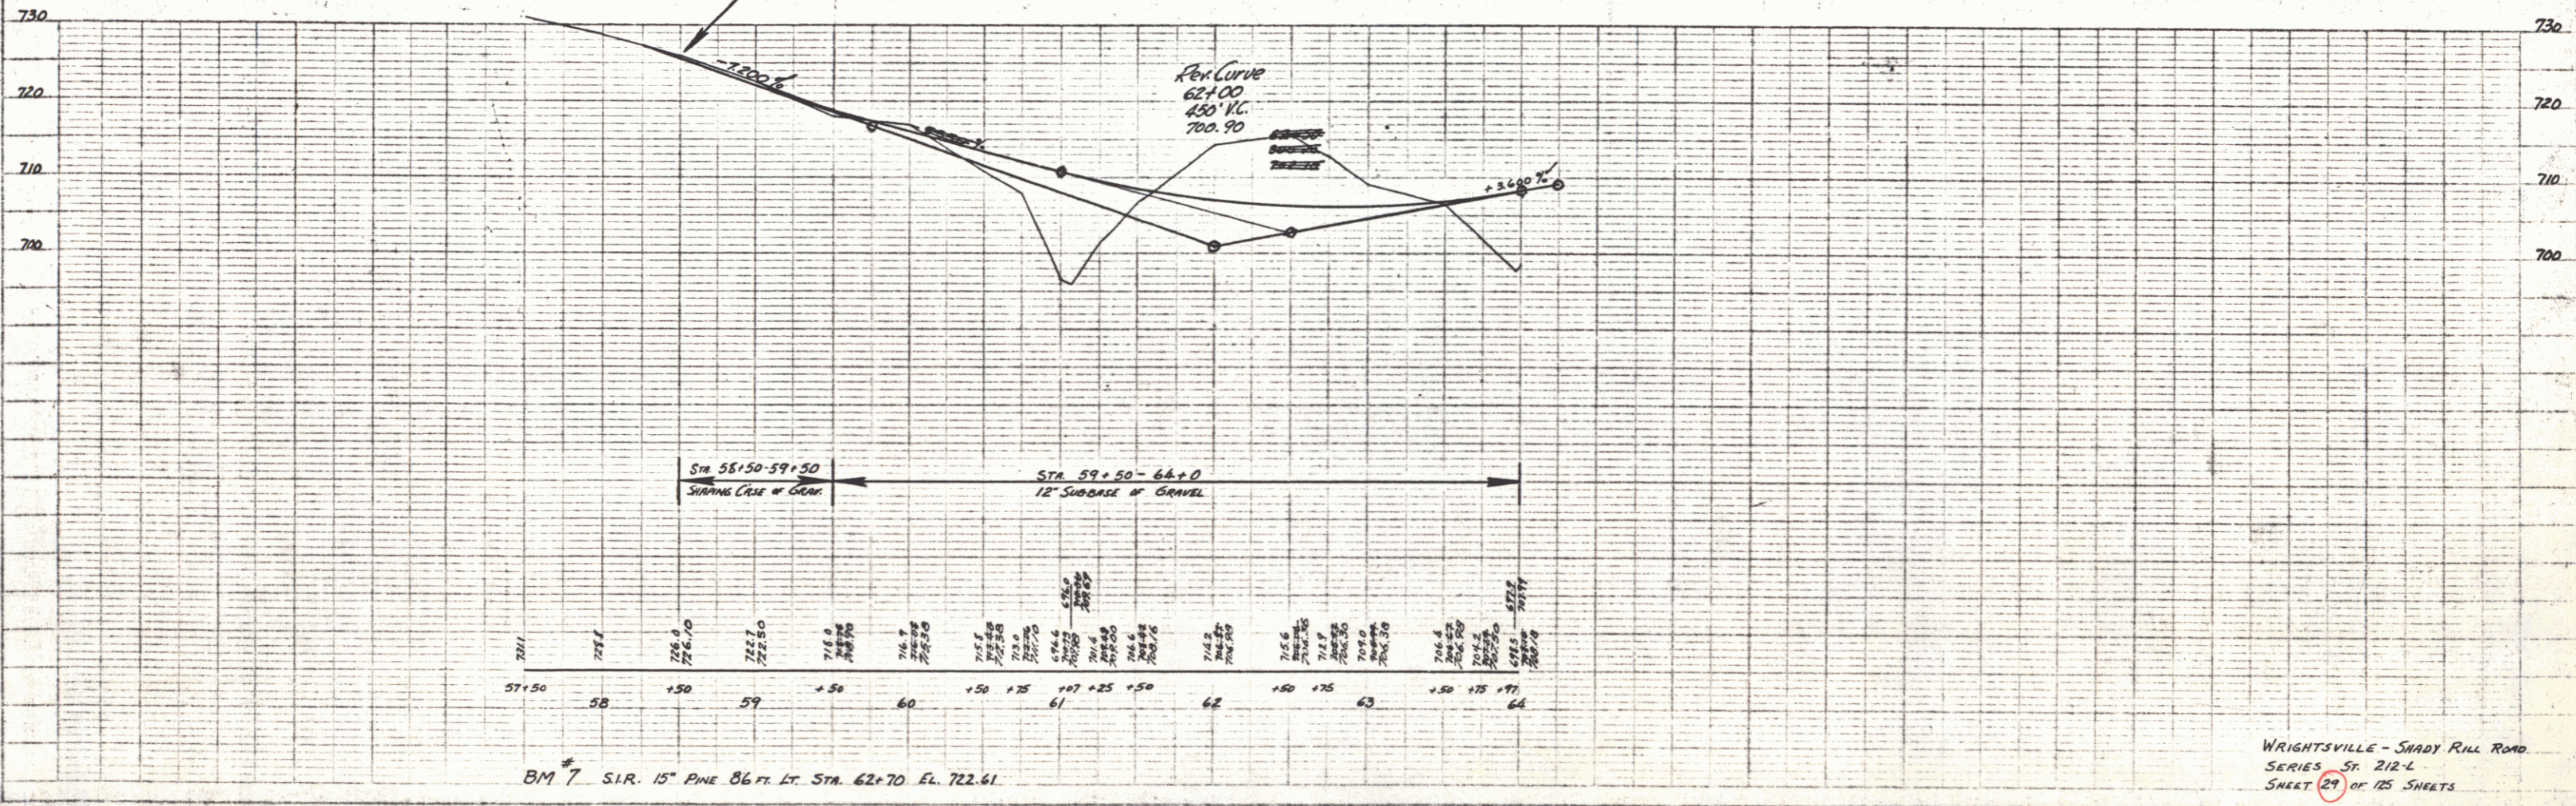


State 212-L 1940 29 125

PLAN
 REVISIONS
 DATE
 BY
 CHECKED
 DATE
 BY

PROFILE
 DATE
 BY
 CHECKED
 DATE
 BY

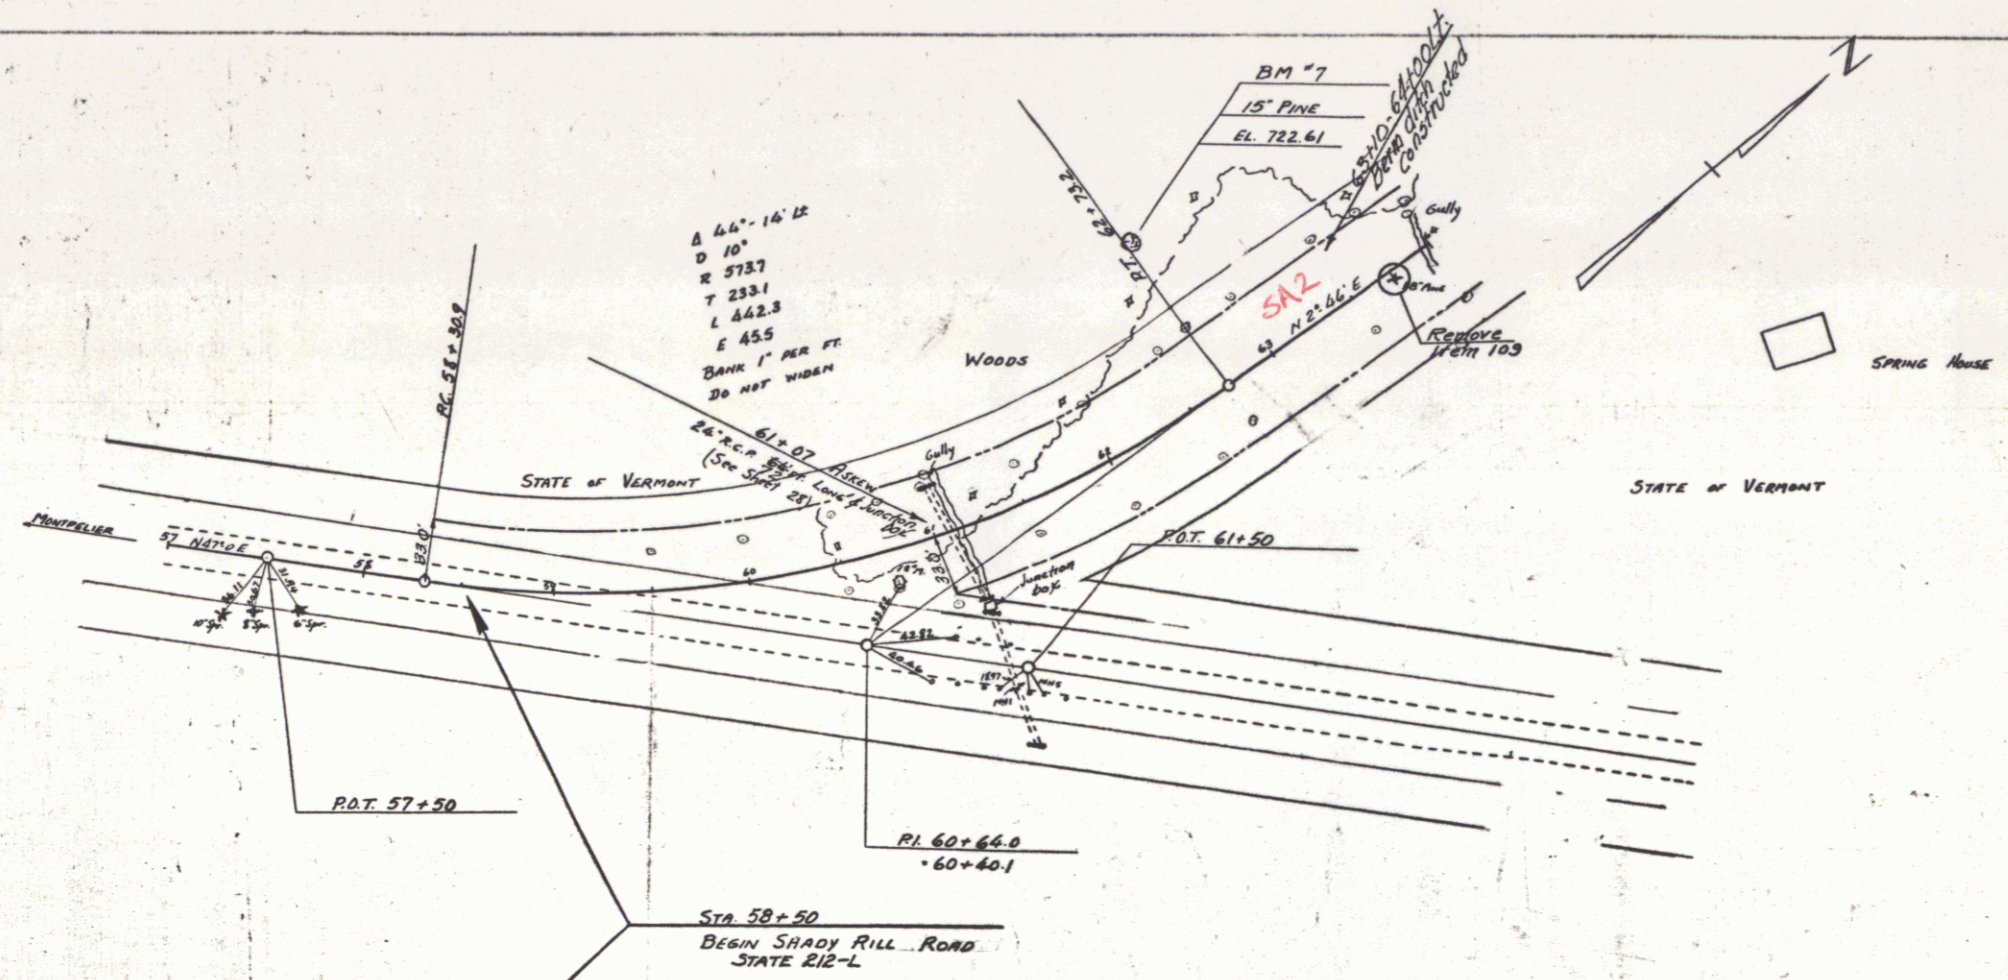

WRIGHTSVILLE - SHADY RILL ROAD
 SERIES ST 212-L
 SHEET 29 OF 125 SHEETS