
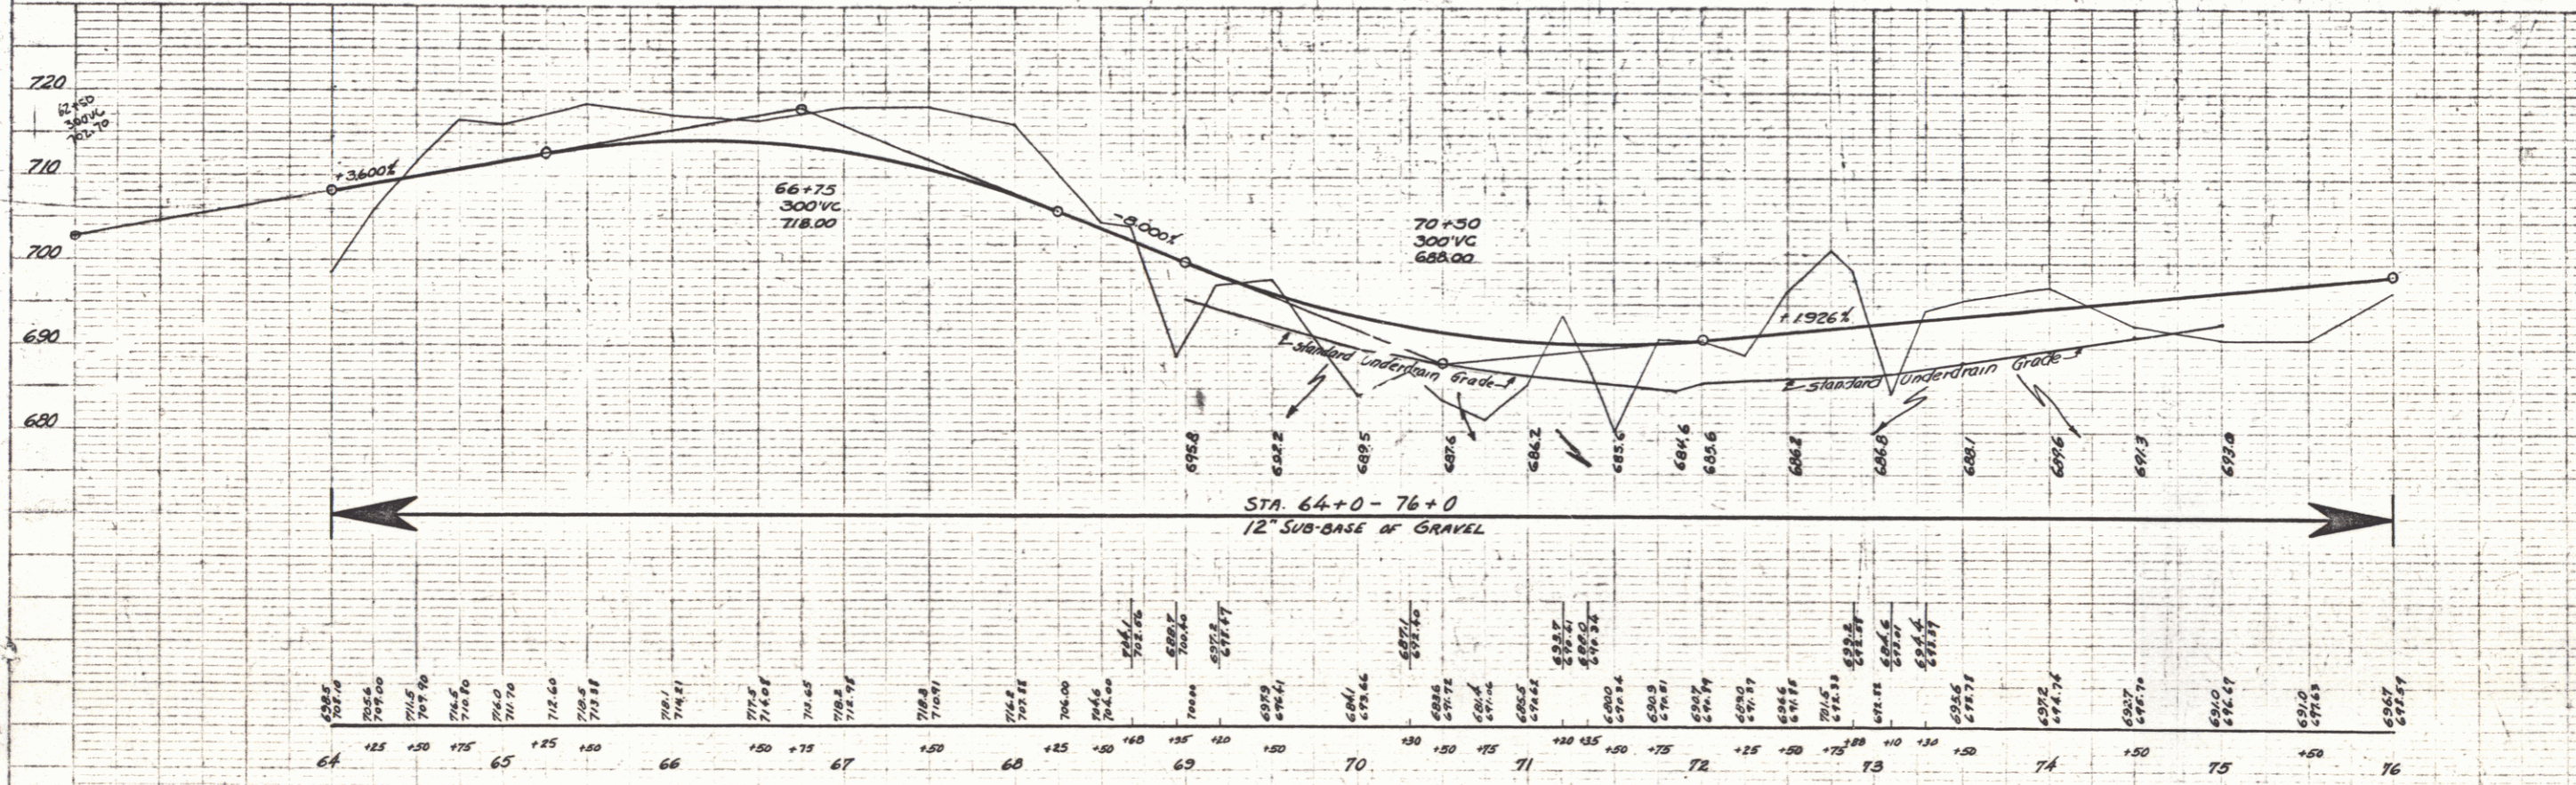


PLAN  
 LANE  
 ENGINEER  
 DATE BOOK  
 ALGAMANT CHECKED  
 BY  
 NO. OF P.W. CHECKED

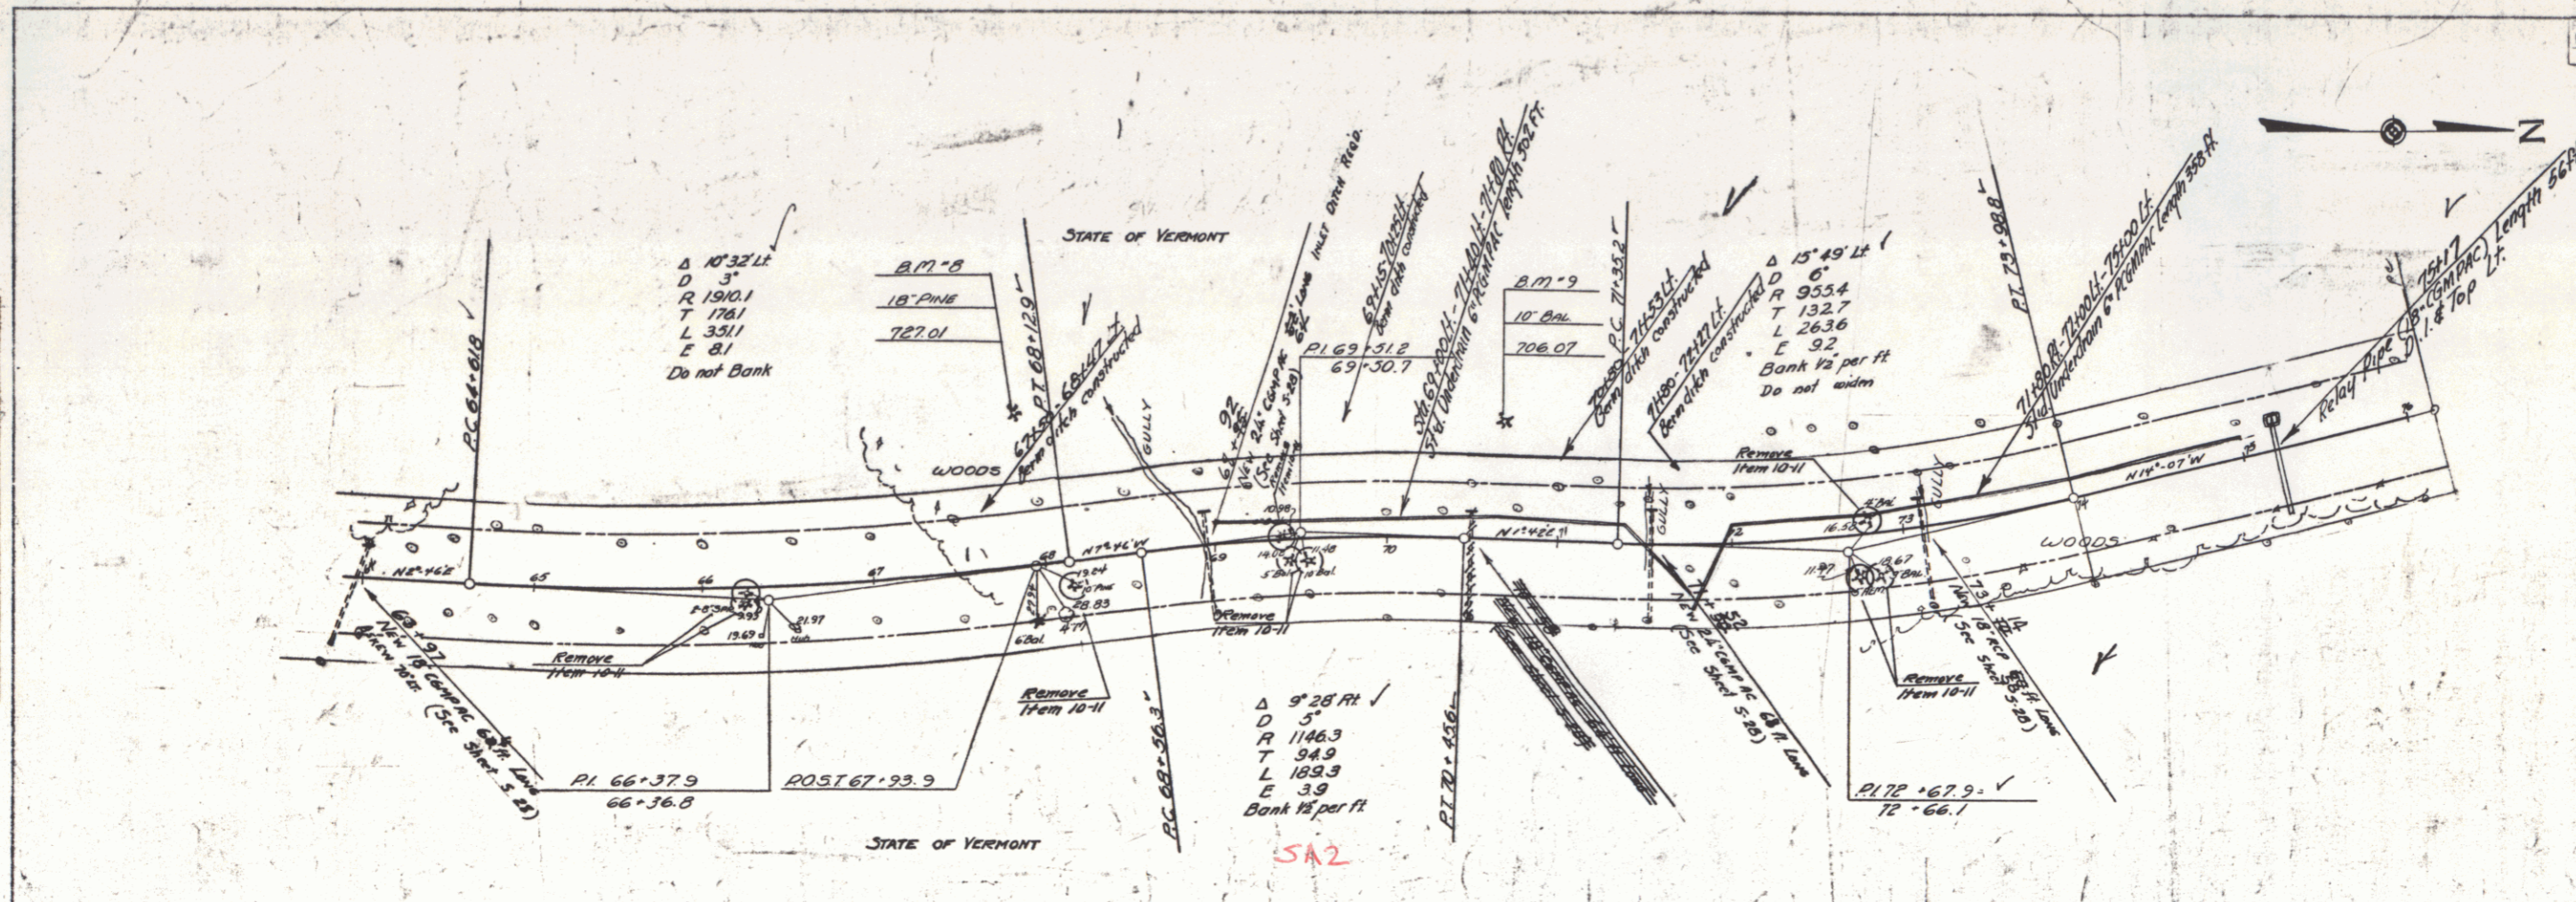

B.M.#8, S.I.R. 18" Pine. 81 Ft. Lt. Sta. 67+91. Elev. 727.01.  
 B.M.#9, S.I.R. 10" Balsam 64 Ft. Lt. Sta. 70+68. Elev. 706.07.

WRIGHTSVILLE (SECTION 2)  
 SHADY HILL ROAD  
 SERIES STATE NO. 212 L  
 SHEET 30 OF 125 SHEETS