


B.M. 11.1
10' E.L. 10
682.13

OUTLET FROM DRAIN SPRING UNDER ROAD ABOVE

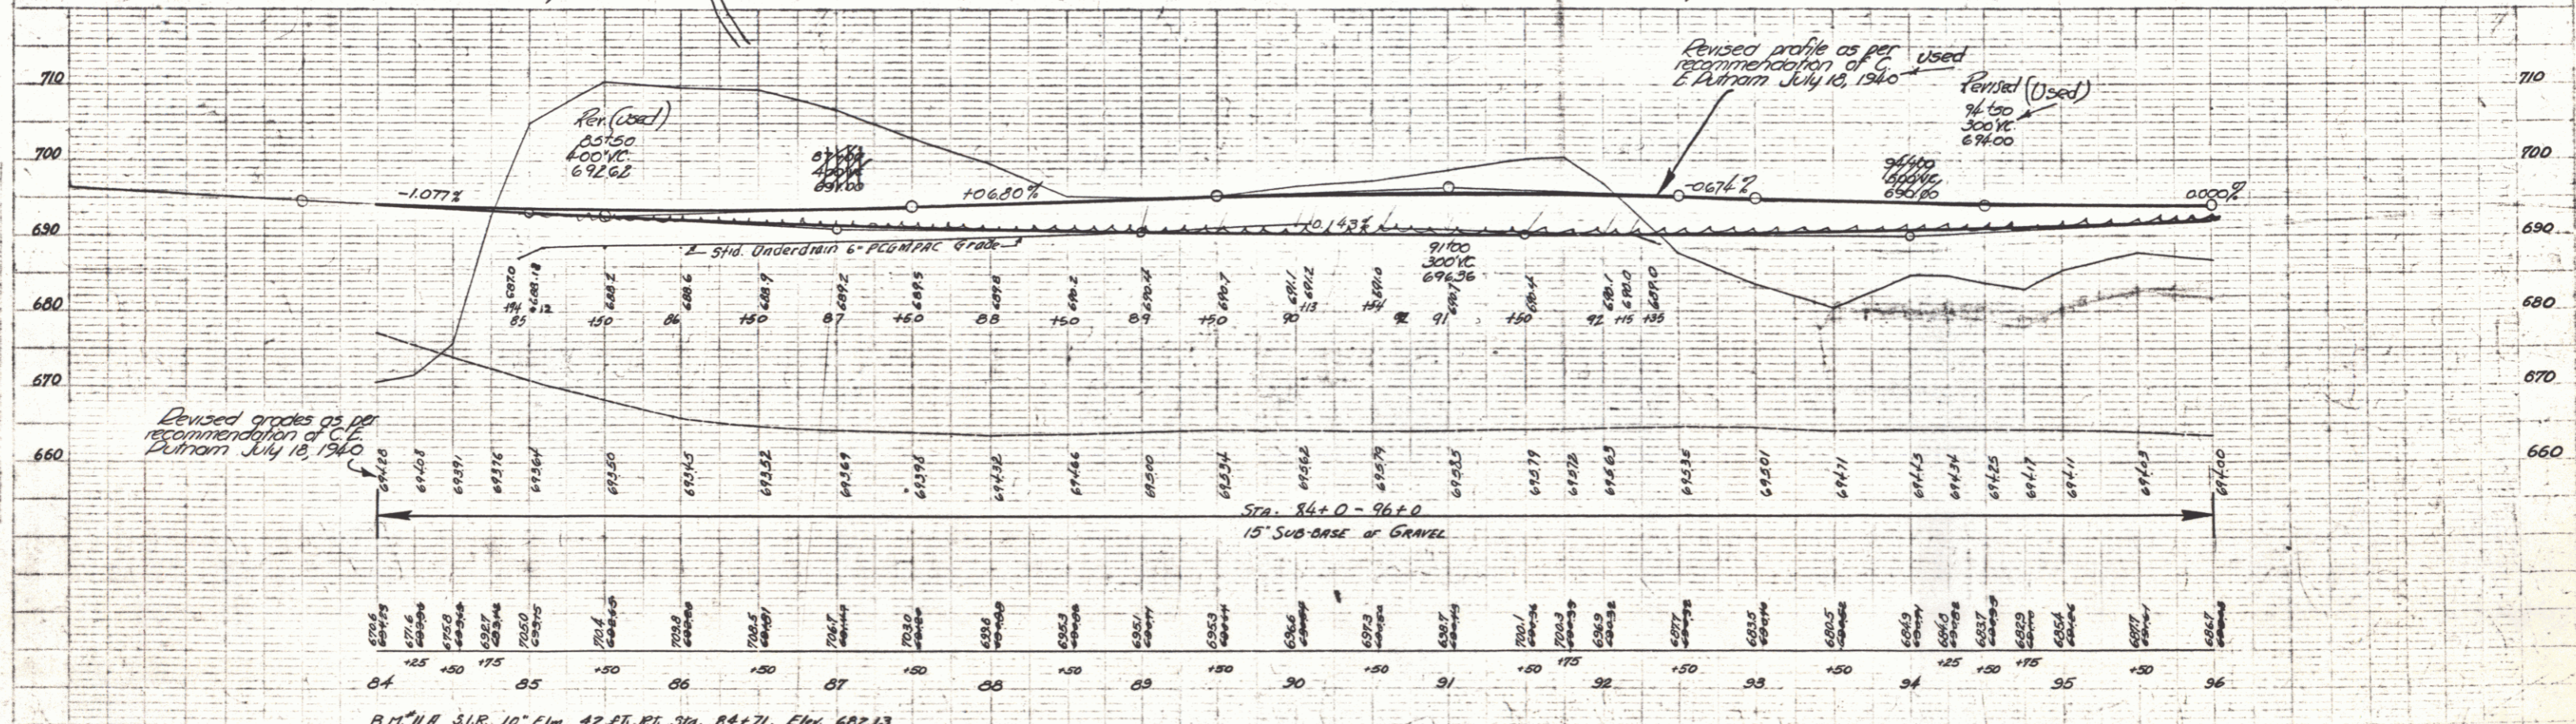

STATE OF VERMONT
HIGHWAY DEPARTMENT
DESIGN DIVISION
DATE: 7/13/40
PROJECT: WRIGHTSVILLE (SECTION 2)
SHEET NO. 56 OF 125 SHEETS

STATE OF VERMONT
HIGHWAY DEPARTMENT
DESIGN DIVISION
DATE: 7/13/40
PROJECT: WRIGHTSVILLE (SECTION 2)
SHEET NO. 56 OF 125 SHEETS

WRIGHTSVILLE (SECTION 2)
SERIES STATE NO. 212 L
SHEET 56 OF 125 SHEETS