


STA. 179+00
END SECTION #3
END OF PROJECT
STATE 212-L

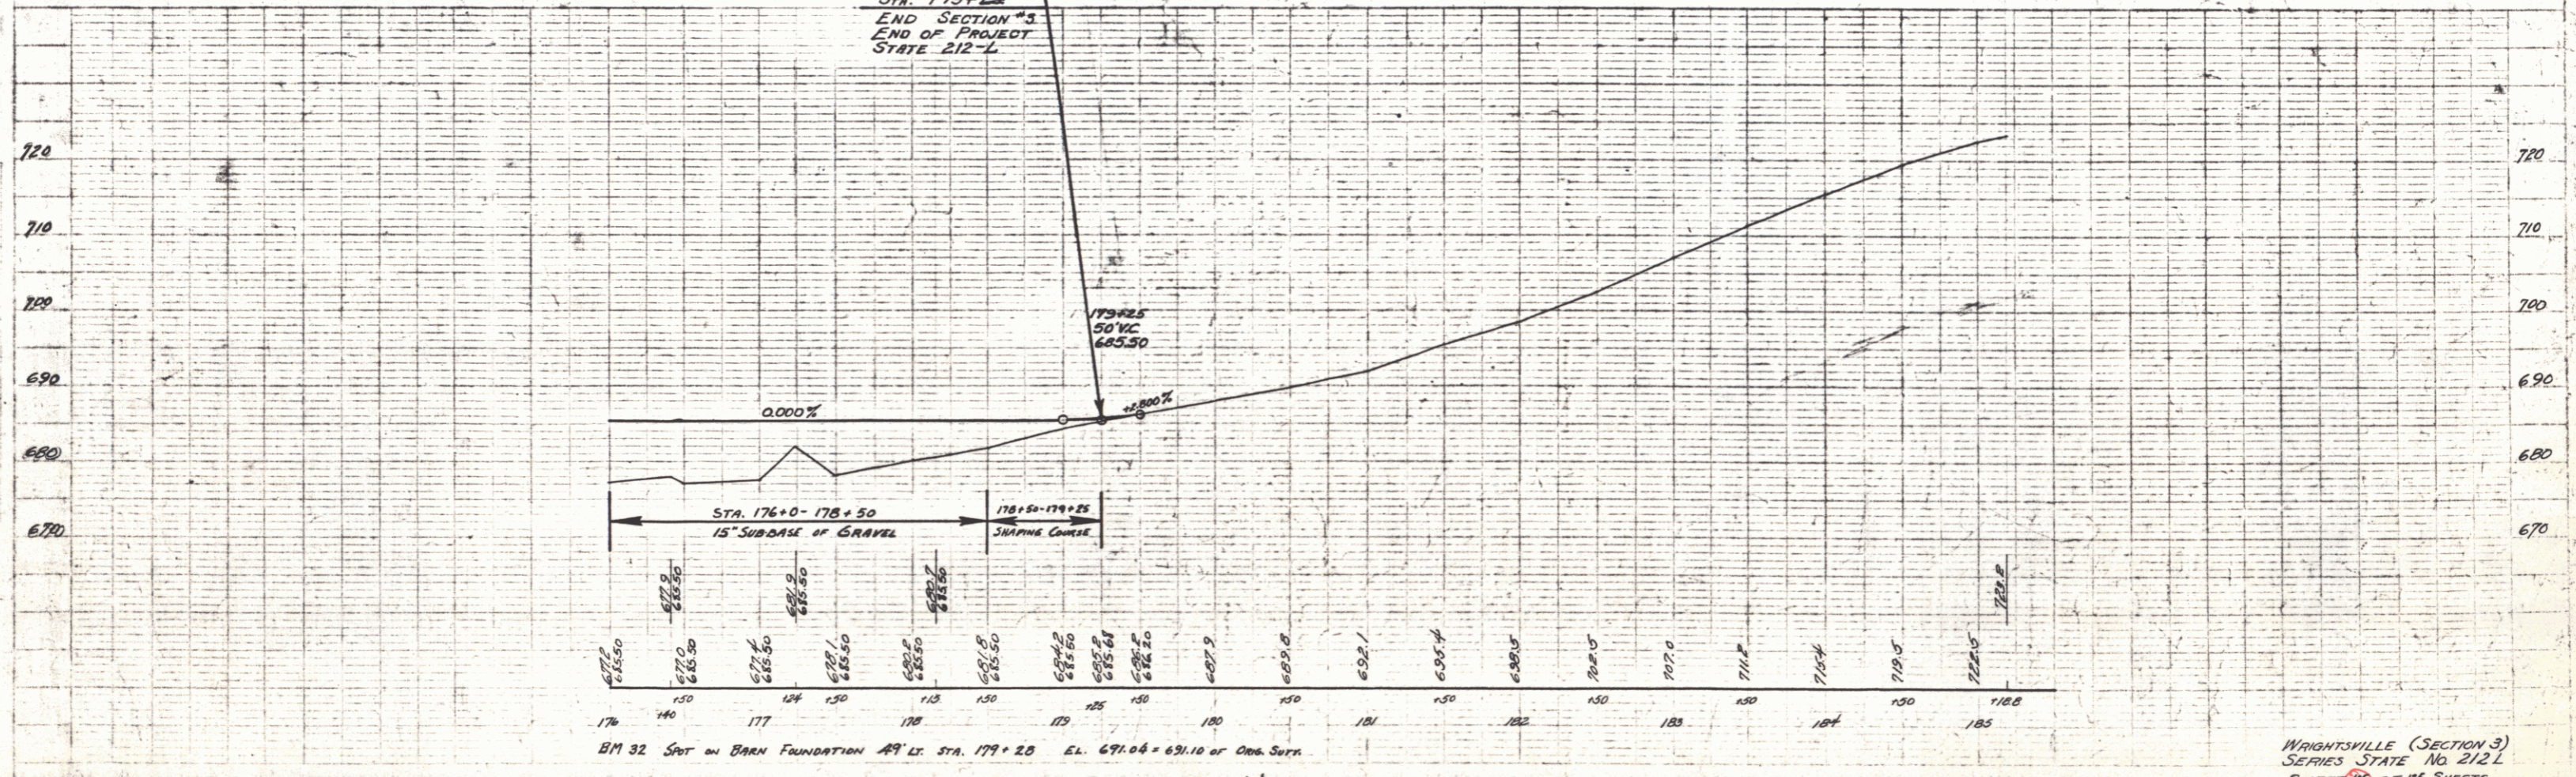

BM 32 Spot on BARN FOUNDATION 49' LT STA. 179+20 EL. 671.08 = 671.10 of Orig. Surv.