
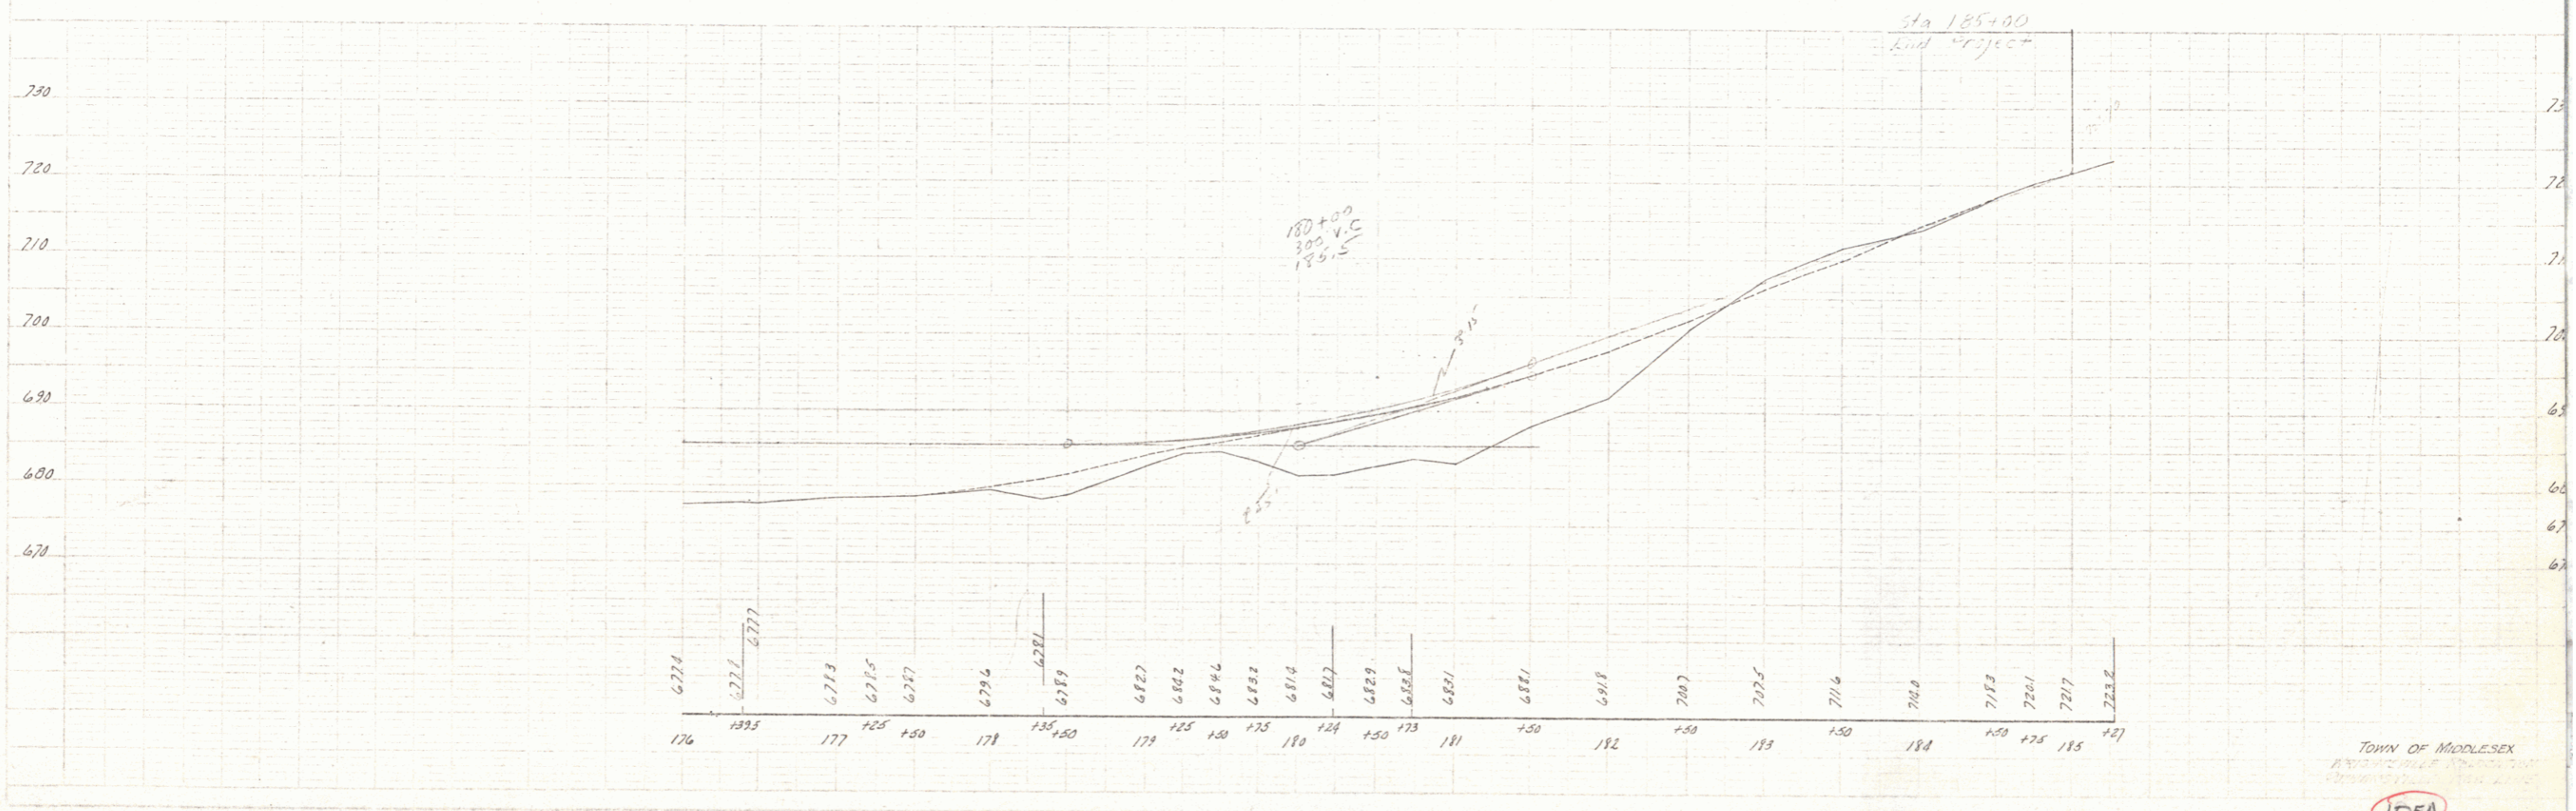


DATE  
 DRAWN  
 CHECKED  
 APPROVED  
 TITLE

DATE  
 DRAWN  
 CHECKED  
 APPROVED  
 TITLE

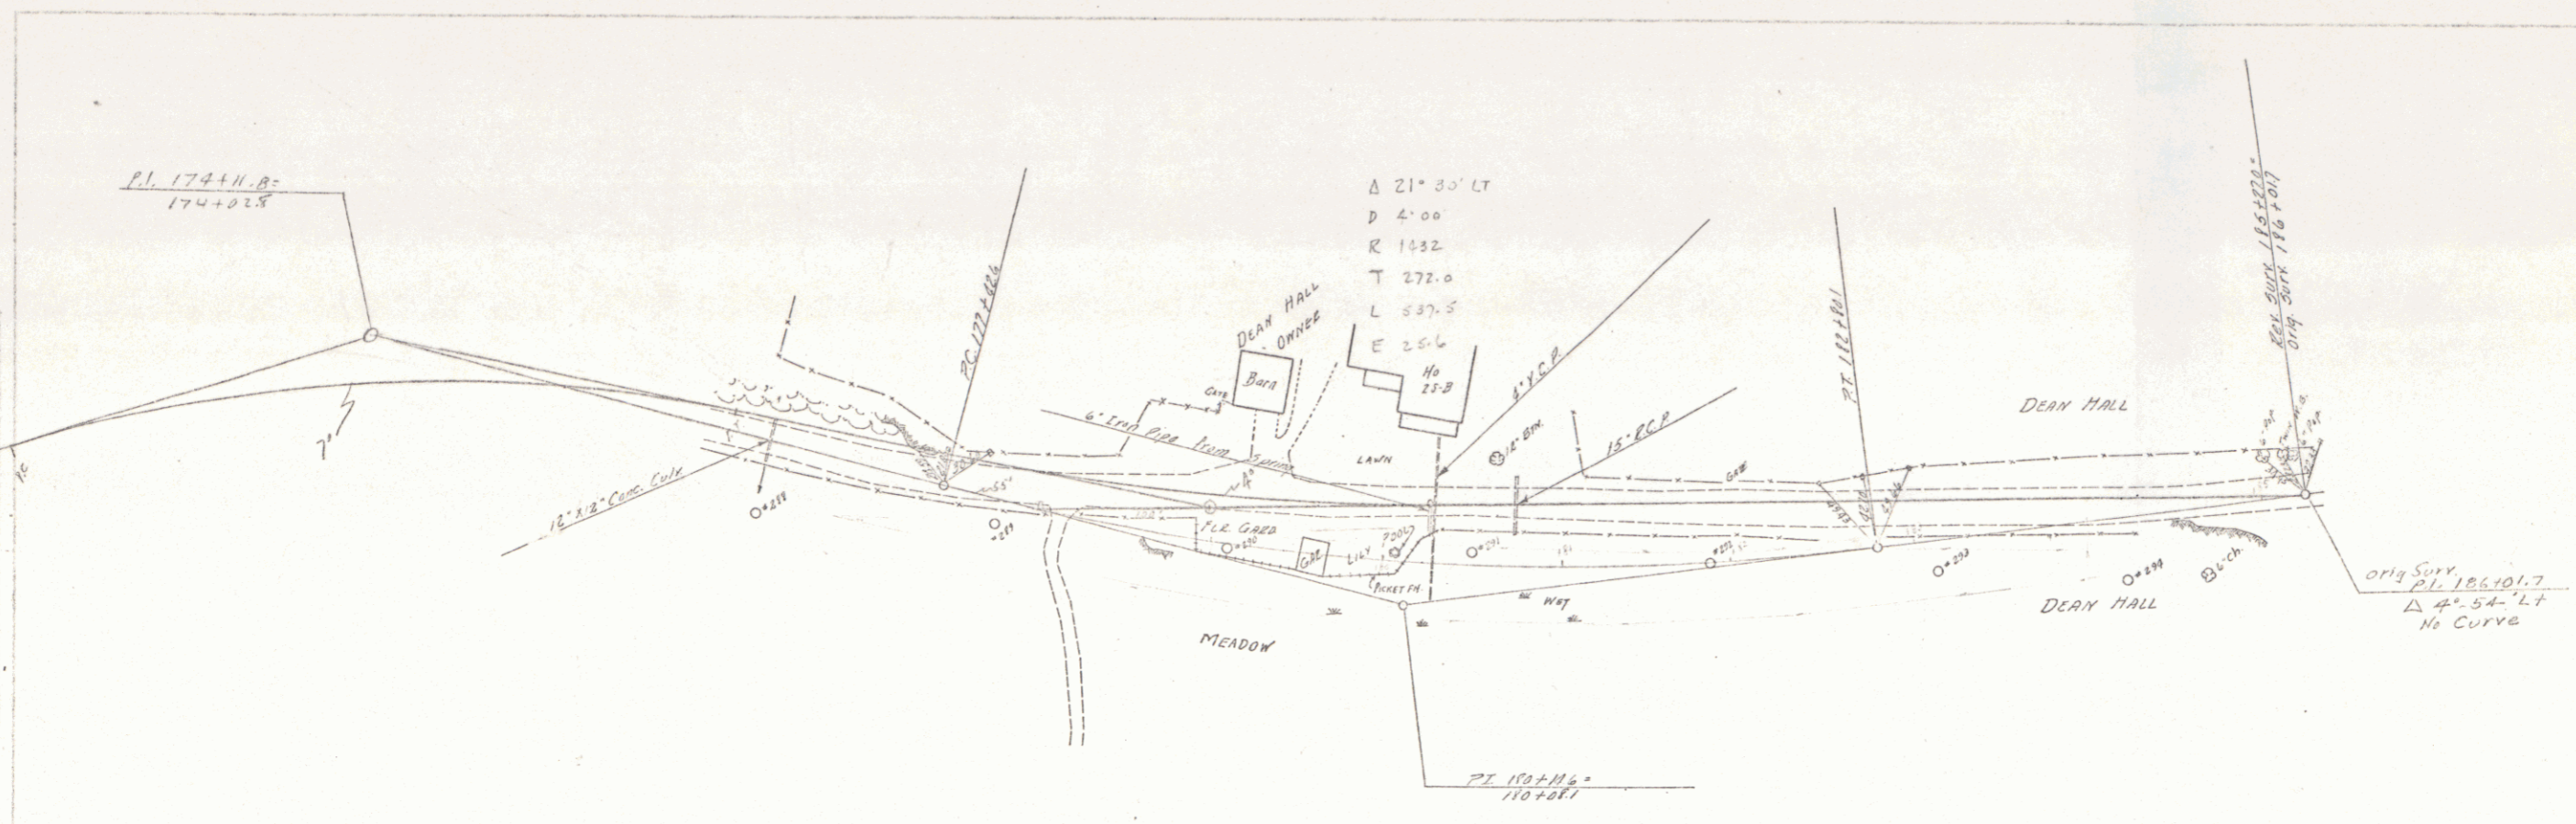

TOWN OF MIDDLESEX  
 105A  
 45