
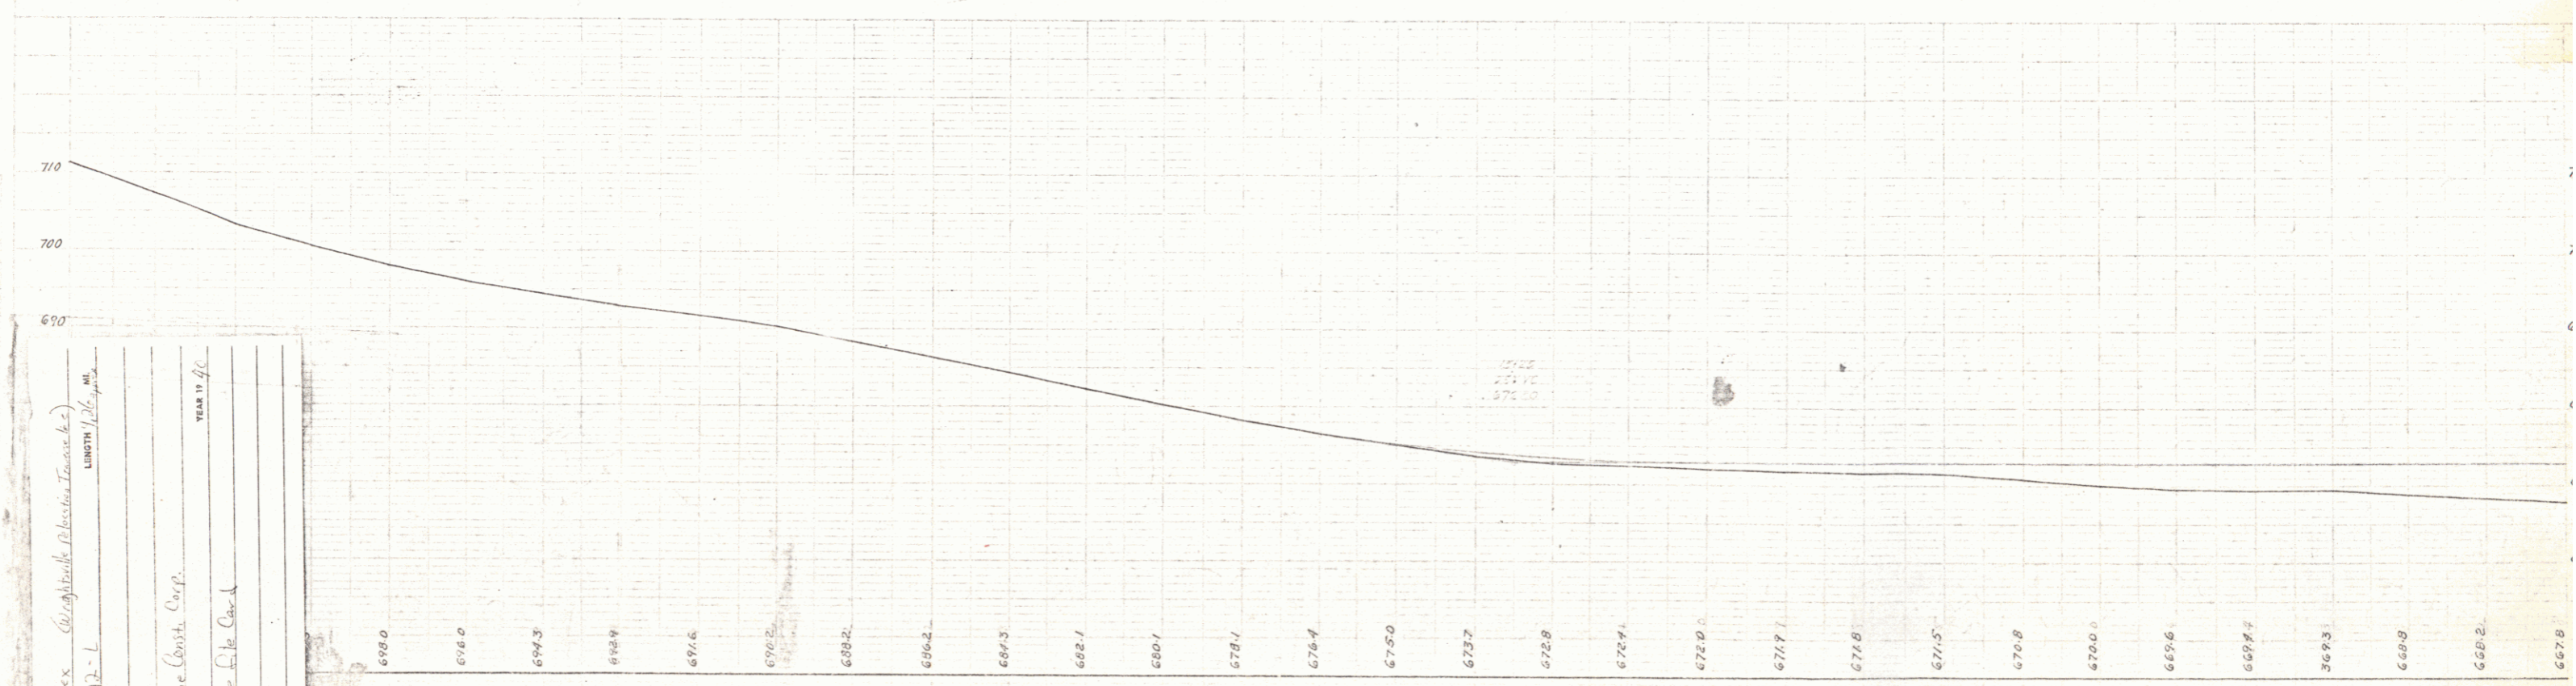


Date 30
 G.M. Lane
 J.L. Hubbard
 June 29

Date 30
 G.M. Lane
 J.L. Hubbard
 June 29

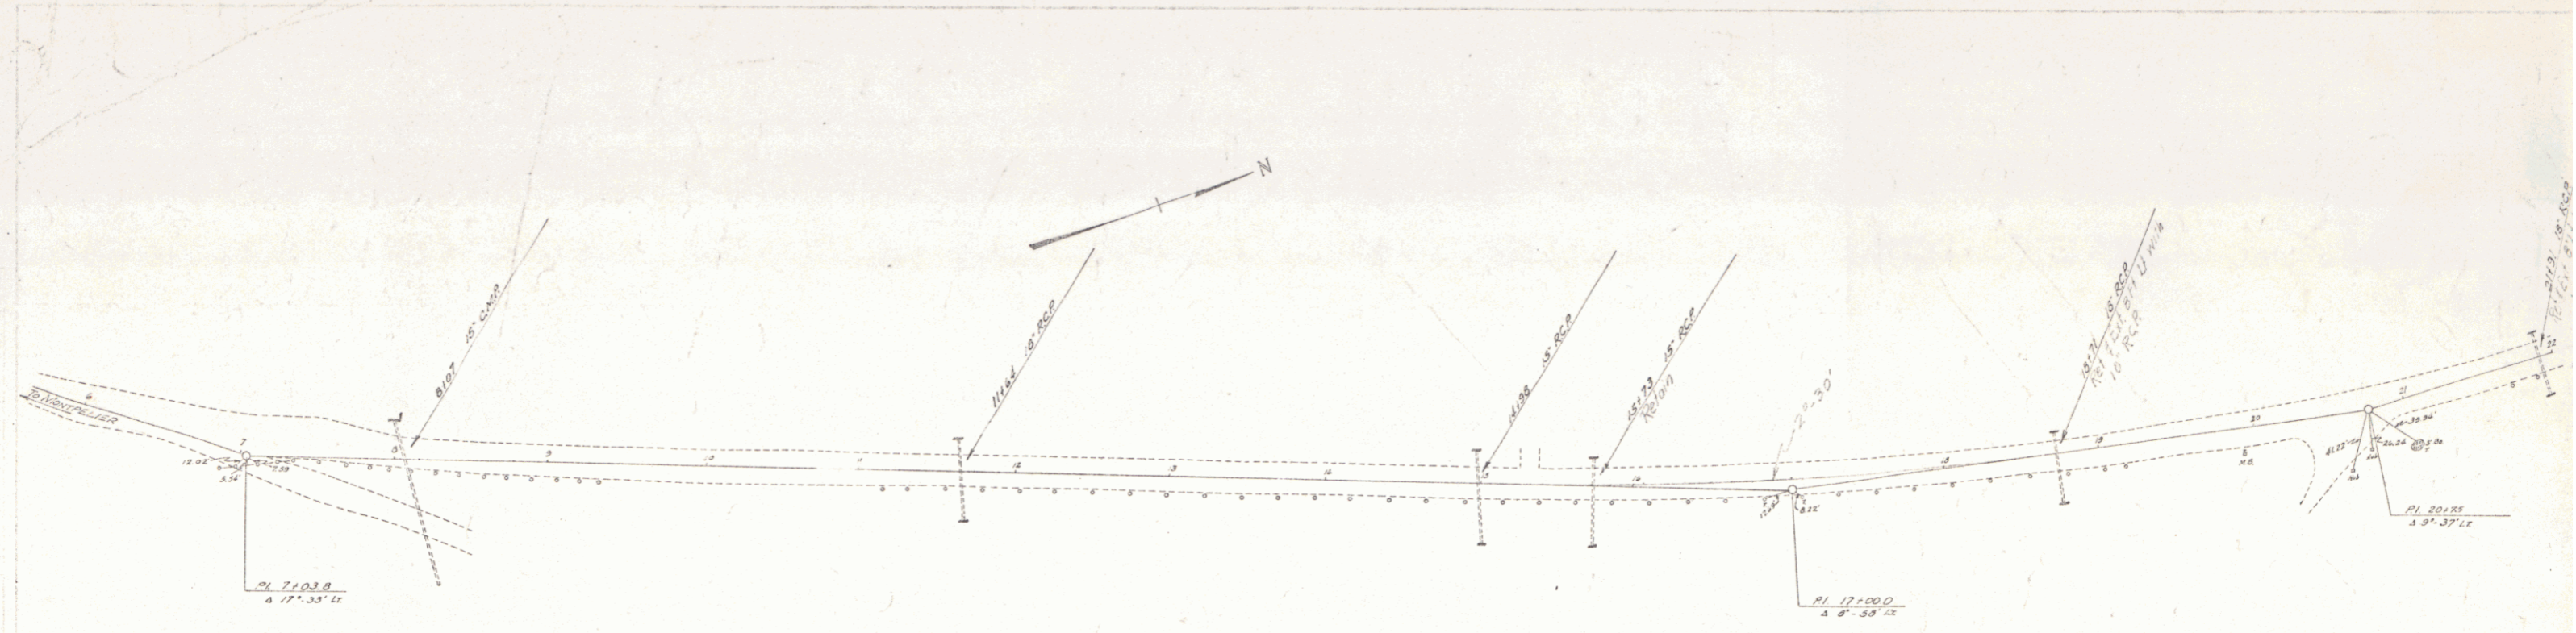

PROJECT	Middlesex (Wrightsville Reclamation)
NUMBER	ST 112-L
DATE	1/16/48
CONTRACTOR	Lane Coash Corp.
LOCATION	State Fair Ground
YEAR	1948

699.0	698.0	697.3	696.4	695.2	693.2	691.2	689.3	687.1	685.1	683.1	681.1	679.4	677.5	675.7	673.8	672.4	670.0	667.7	665.6	663.7	661.3	658.9	656.2	652.8
-------	-------	
TOWN OF MIDDLESEX
WRIGHTSVILLE RECLAMATION

1