



NAME
 DATE
 SCALE
 SHEET NO.

NAME
 DATE
 SCALE
 SHEET NO.

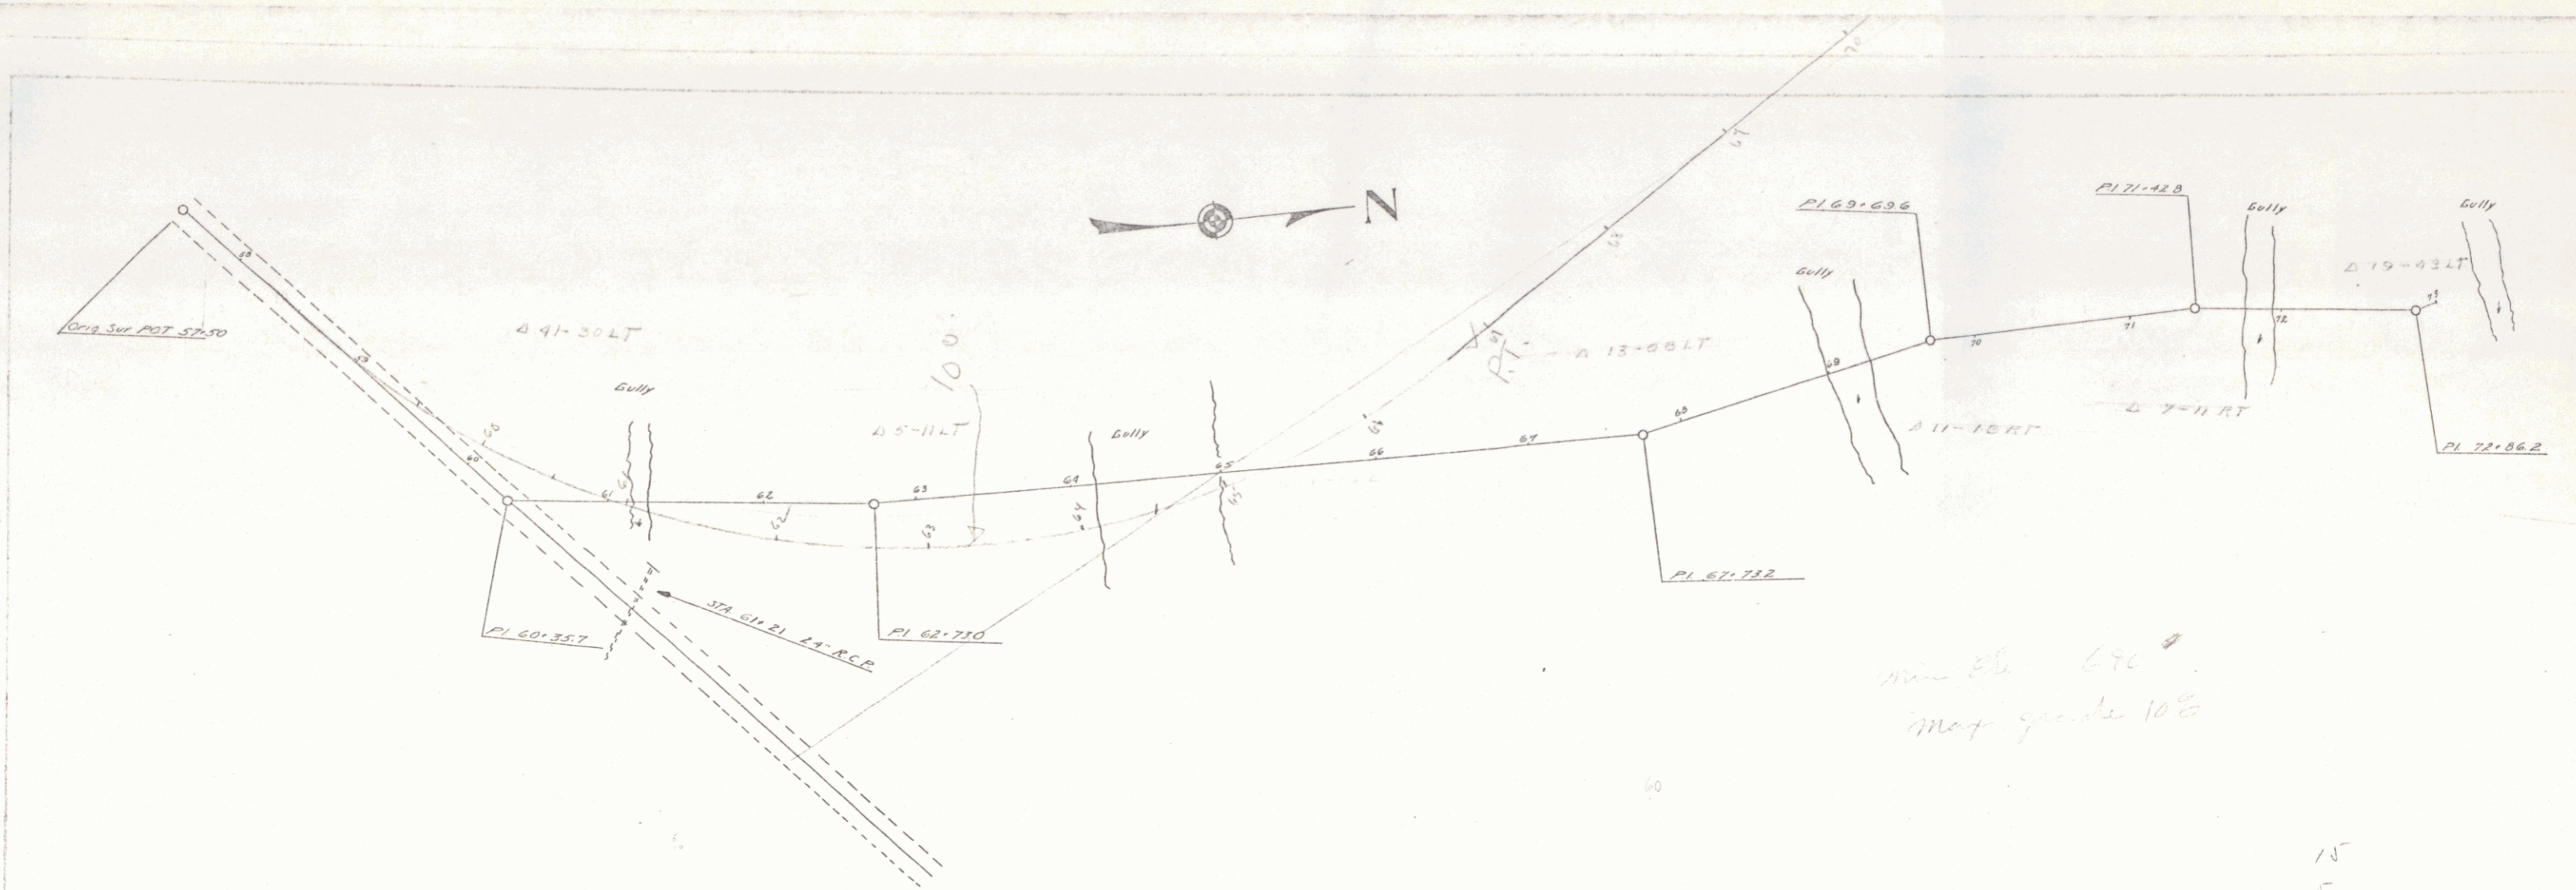

min elev 690
 max grade 10%

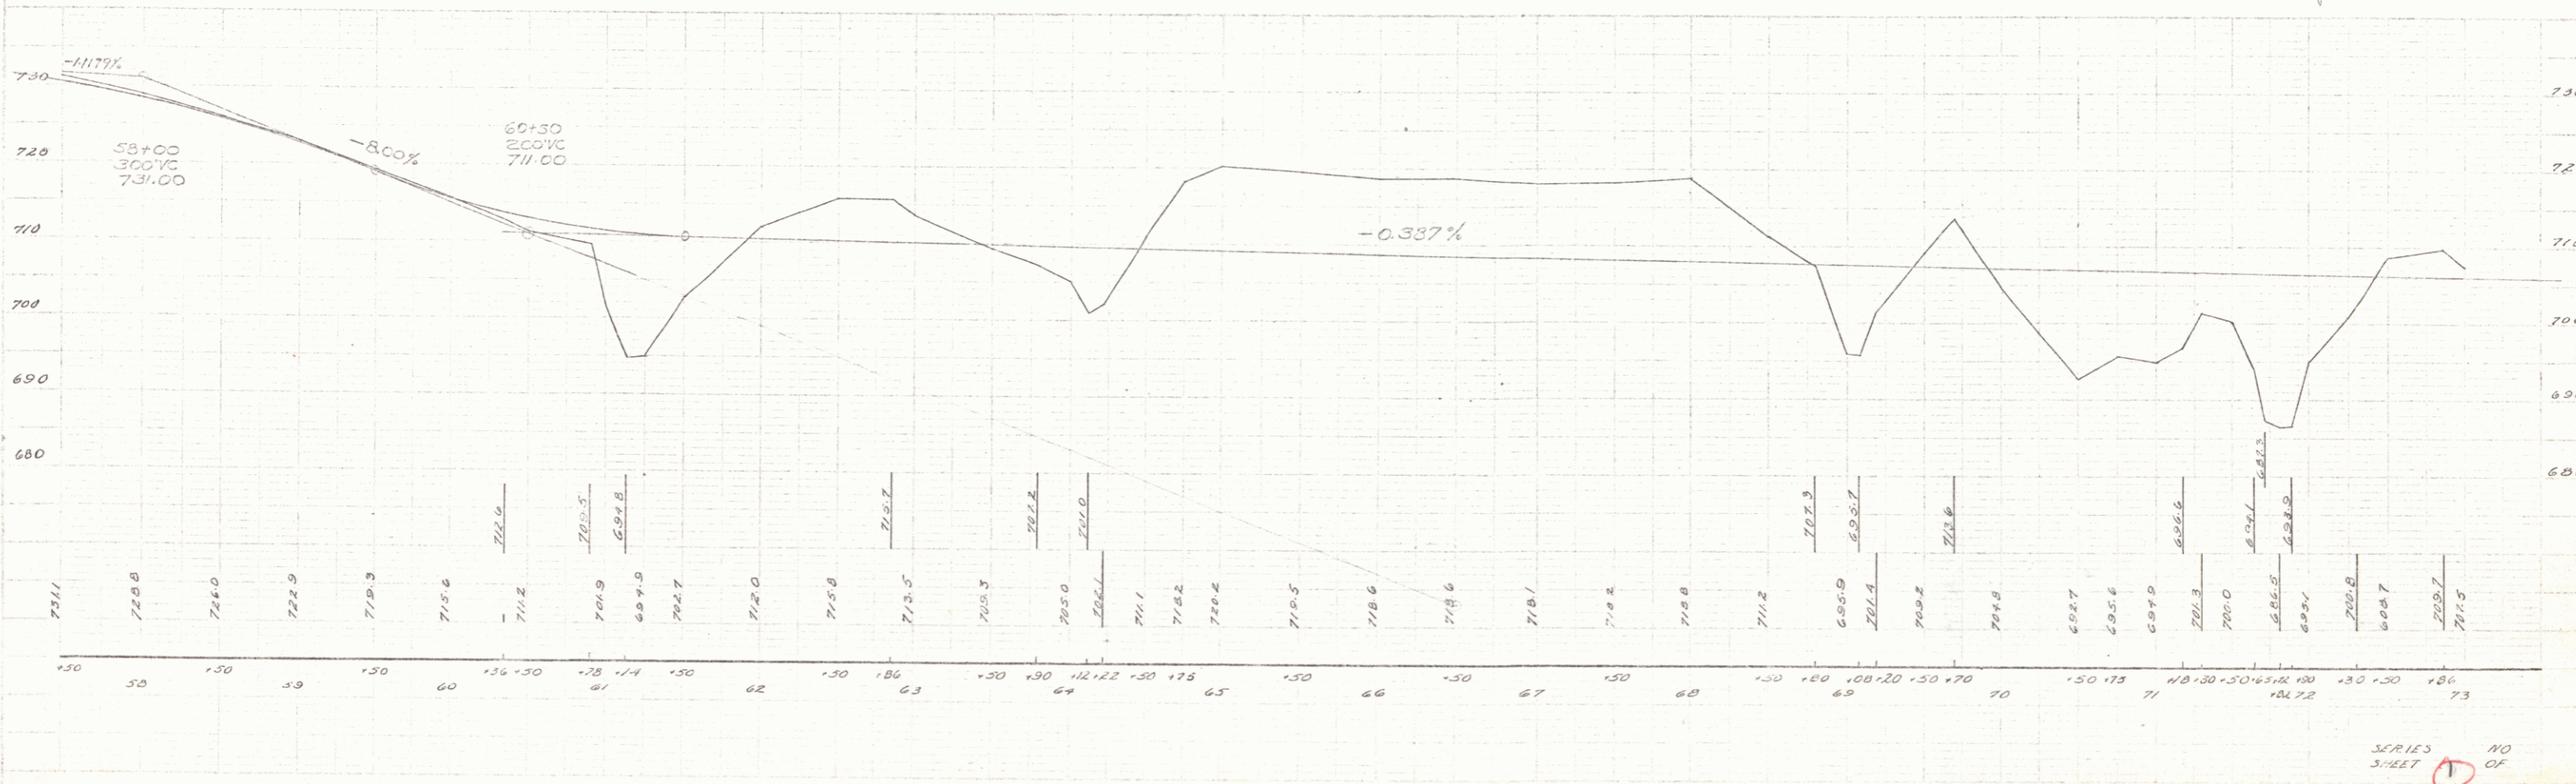

SERIES 1 NO OF