

REINFORCED CONCRETE PIPE



STATION	W.D.	H.D.	C.D.
4+00	18"	48"	1.9 c.f.
6+50	18"	52"	1.5 "
8+00	18"	56"	1.9 "

CORR. GALV. METAL PIPE (250 CTD)

STATION	W.D.	H.D.	C.D.
0+25	18"	76"	1.9

1935 3 13

Map 35  
Leach  
Bjorn  
Bjorn  
Traced

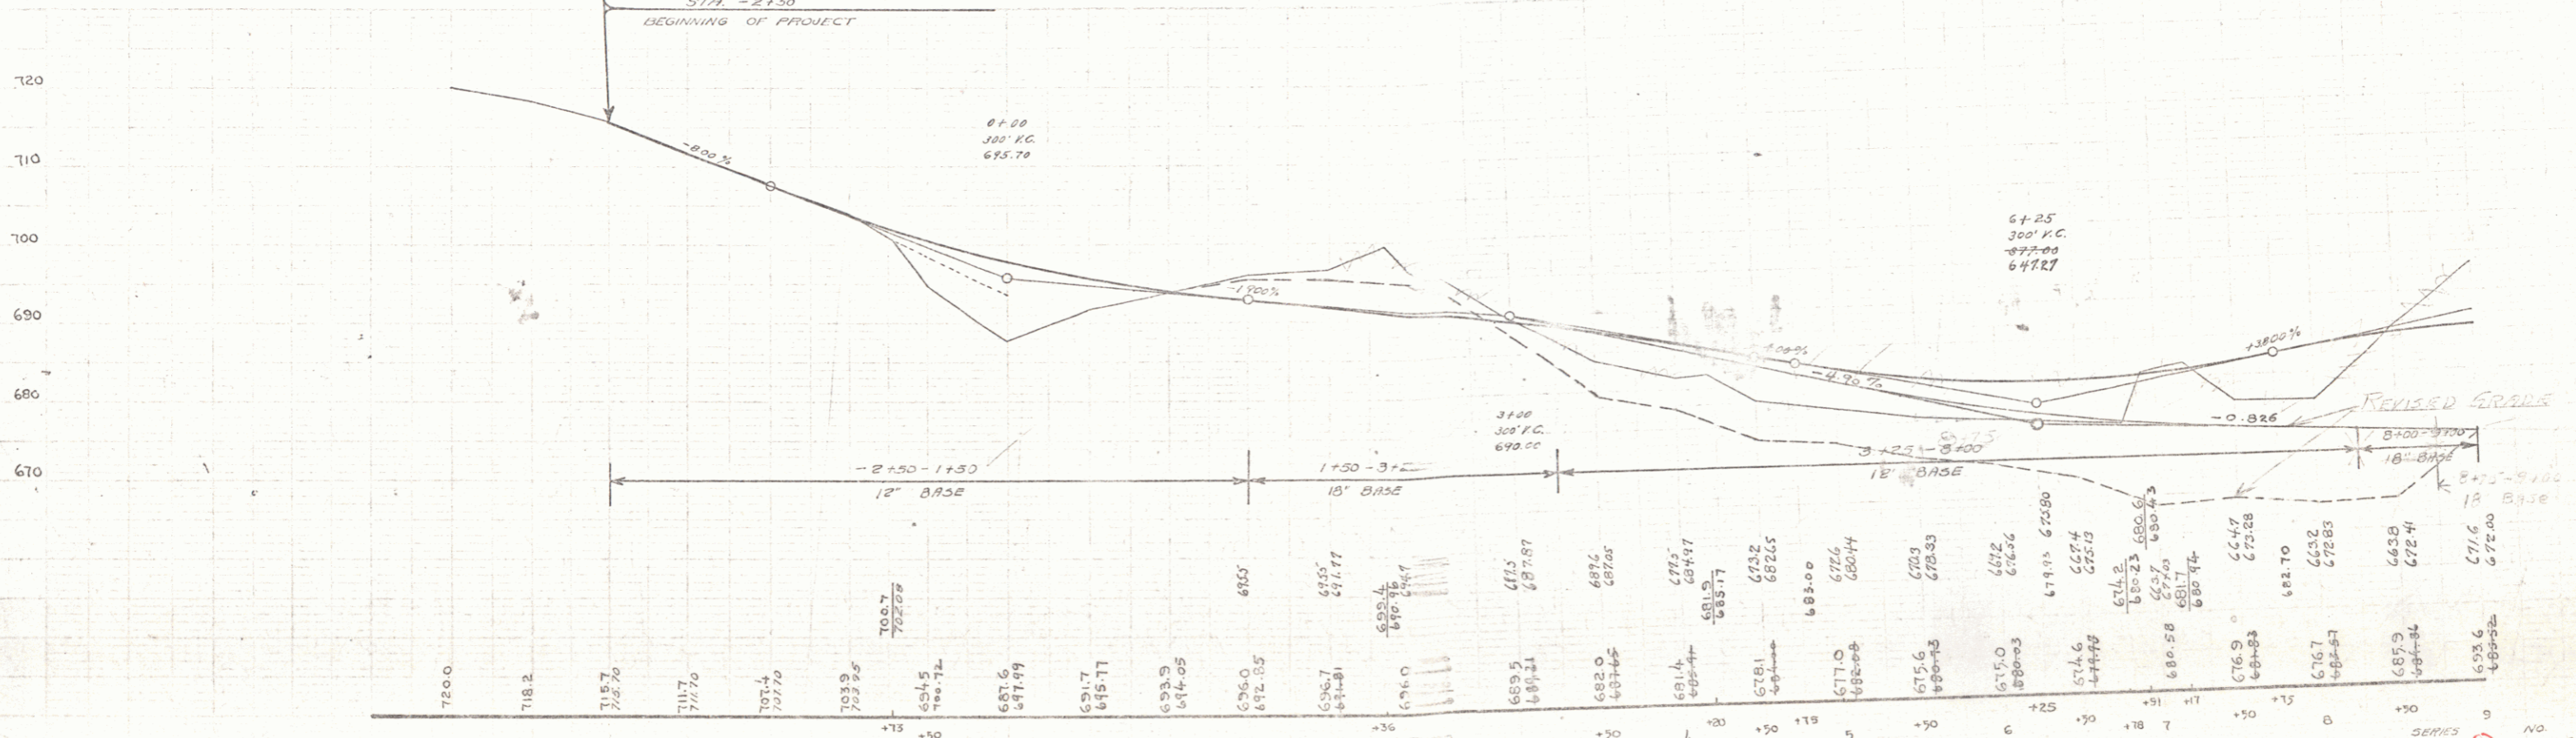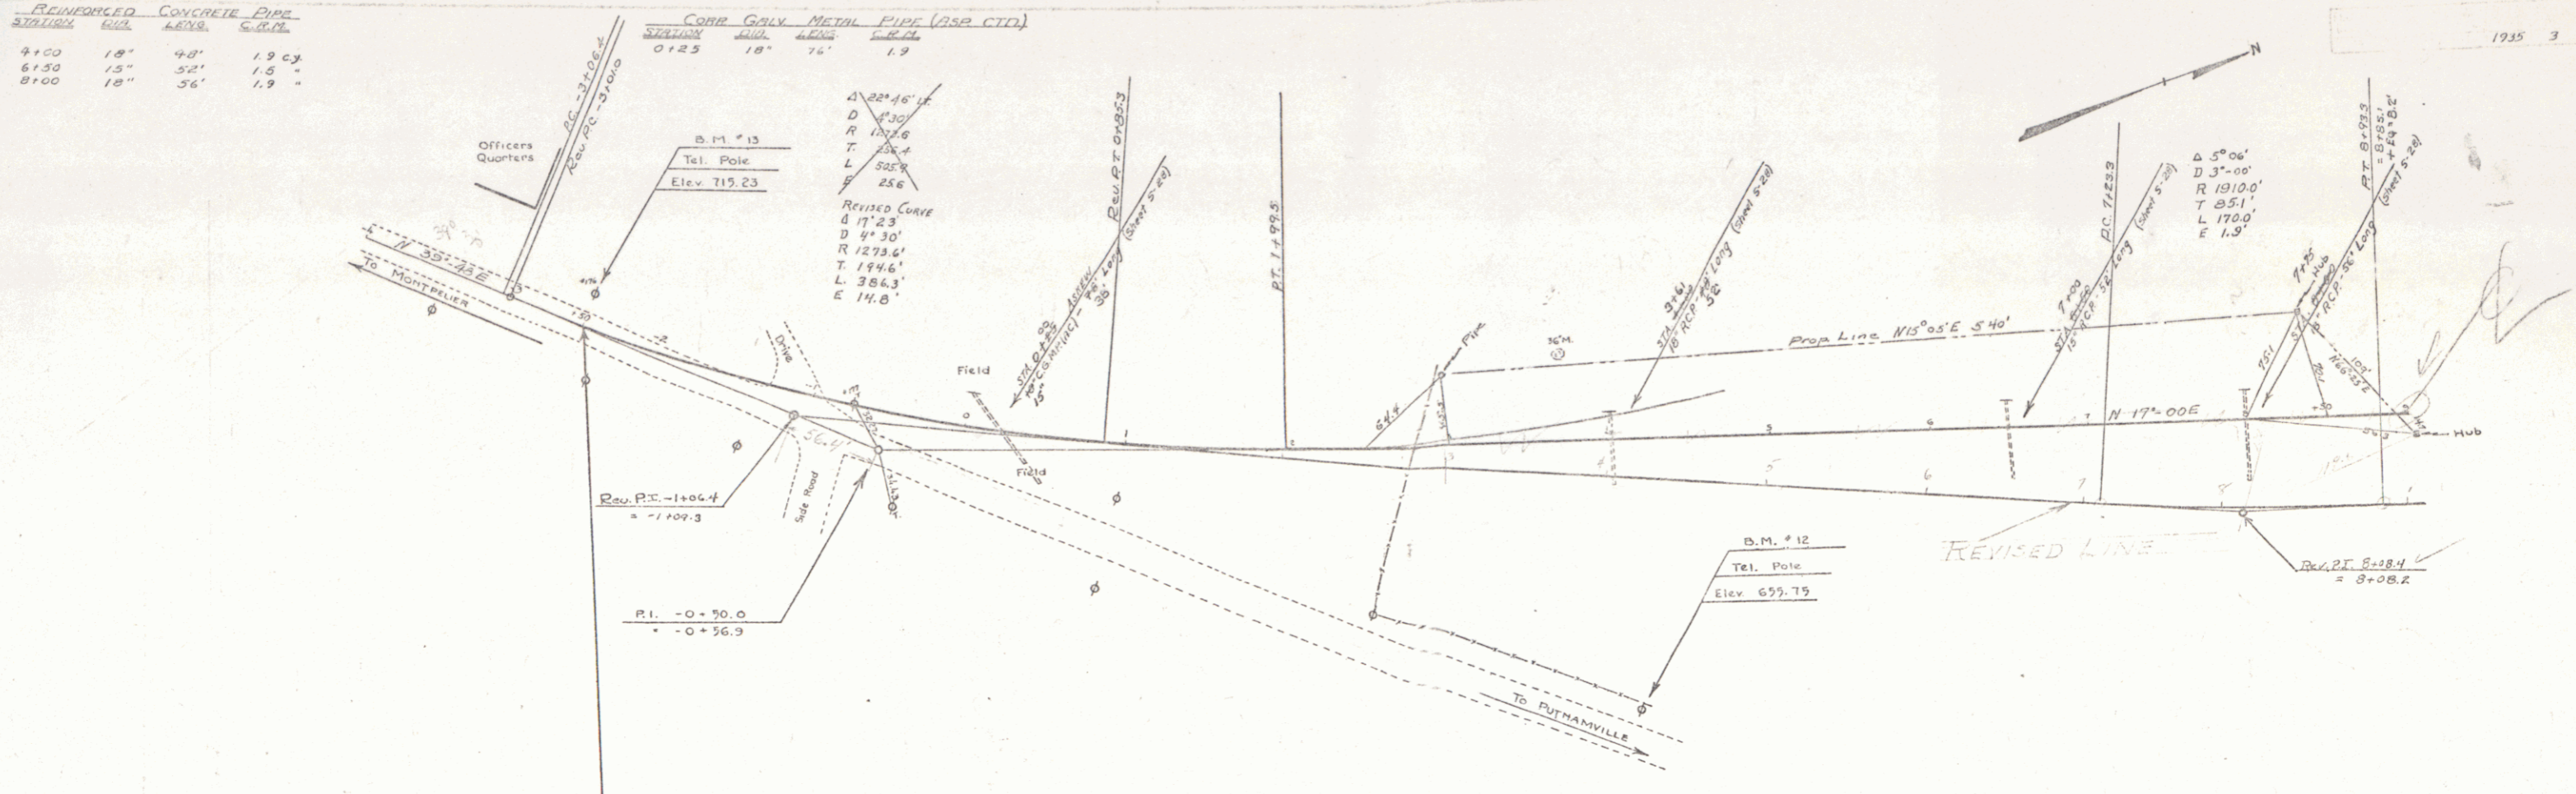

B.M. #12 SPIKE IN TEL. POLE 61' RT. OF STA. 4+25 ELEV. 655.75  
B.M. #13 " " " " 20' RT. OF STA. 2+52 ELEV. 719.23

SERIES SHEET 3 NO. OF 43