
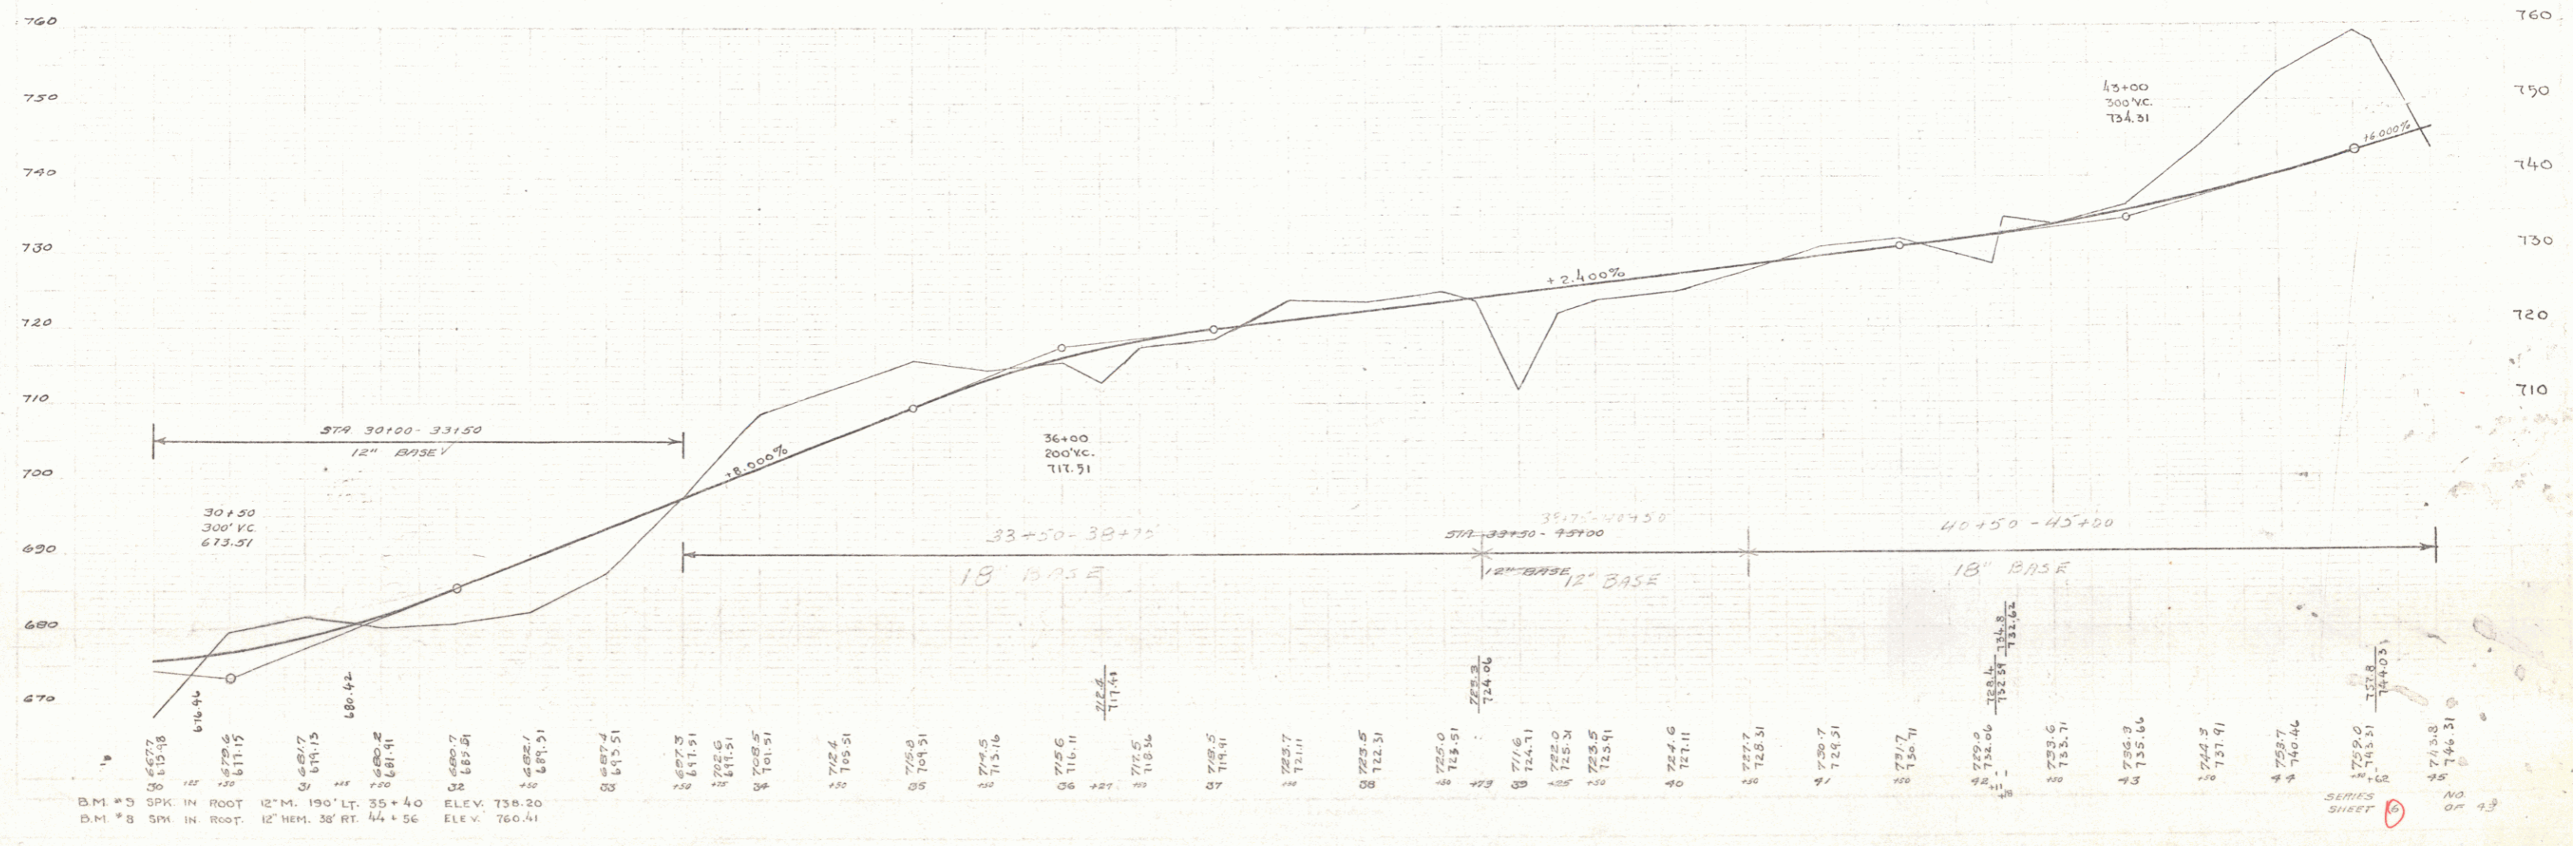


REINFORCED CONCRETE PIPE			
STATION	SIZE	LENGTH	C.M.M.
+2111	24"	40'	2.9 cy

CORR. GALV. METAL PIPE (D.S.P. CTD.)			
STATION	SIZE	LENGTH	C.M.M.
35+50	18"	56'	1.9 c.y.
36+27	24"	35'	2.9 "
37+09	24"	75'	2.9 "

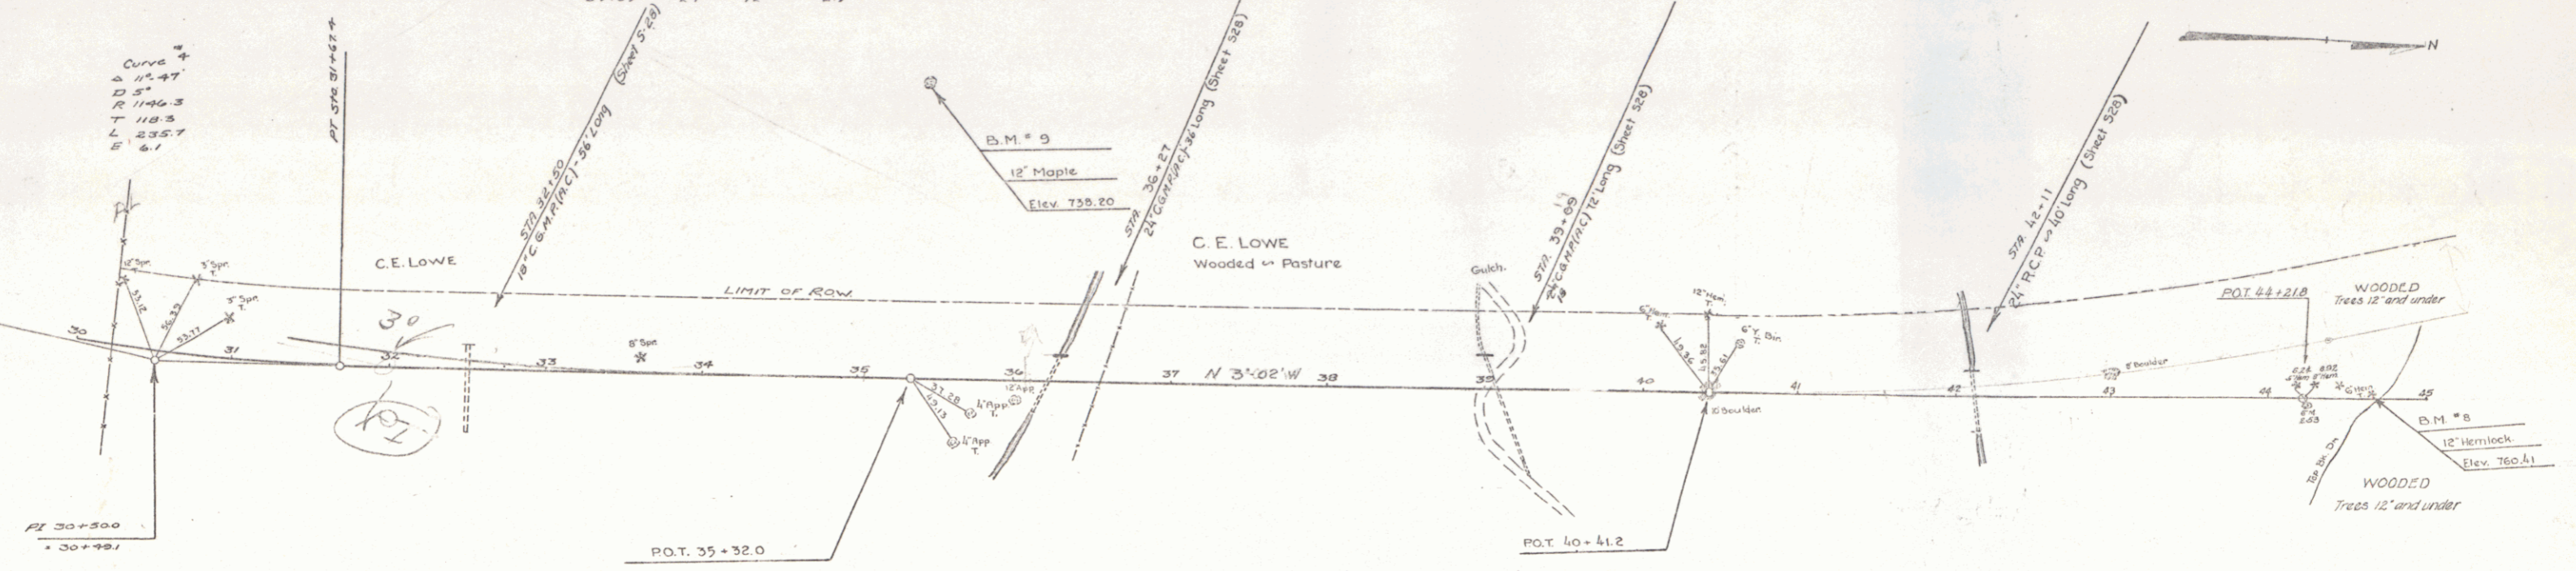

B.M. #3 SPK. IN ROOT 12" M. 190' LT. 35+40 ELEV. 758.20  
 B.M. #8 SPK. IN ROOT 12" HEM. 38' RT. 44+56 ELEV. 760.41

SHEET NO. 13