


REINFORCED CONCRETE PIPE

STATION	DIAMETER	LENGTH	CRM
93+05	24"	56'	2.9
99+22	18"	56'	1.9

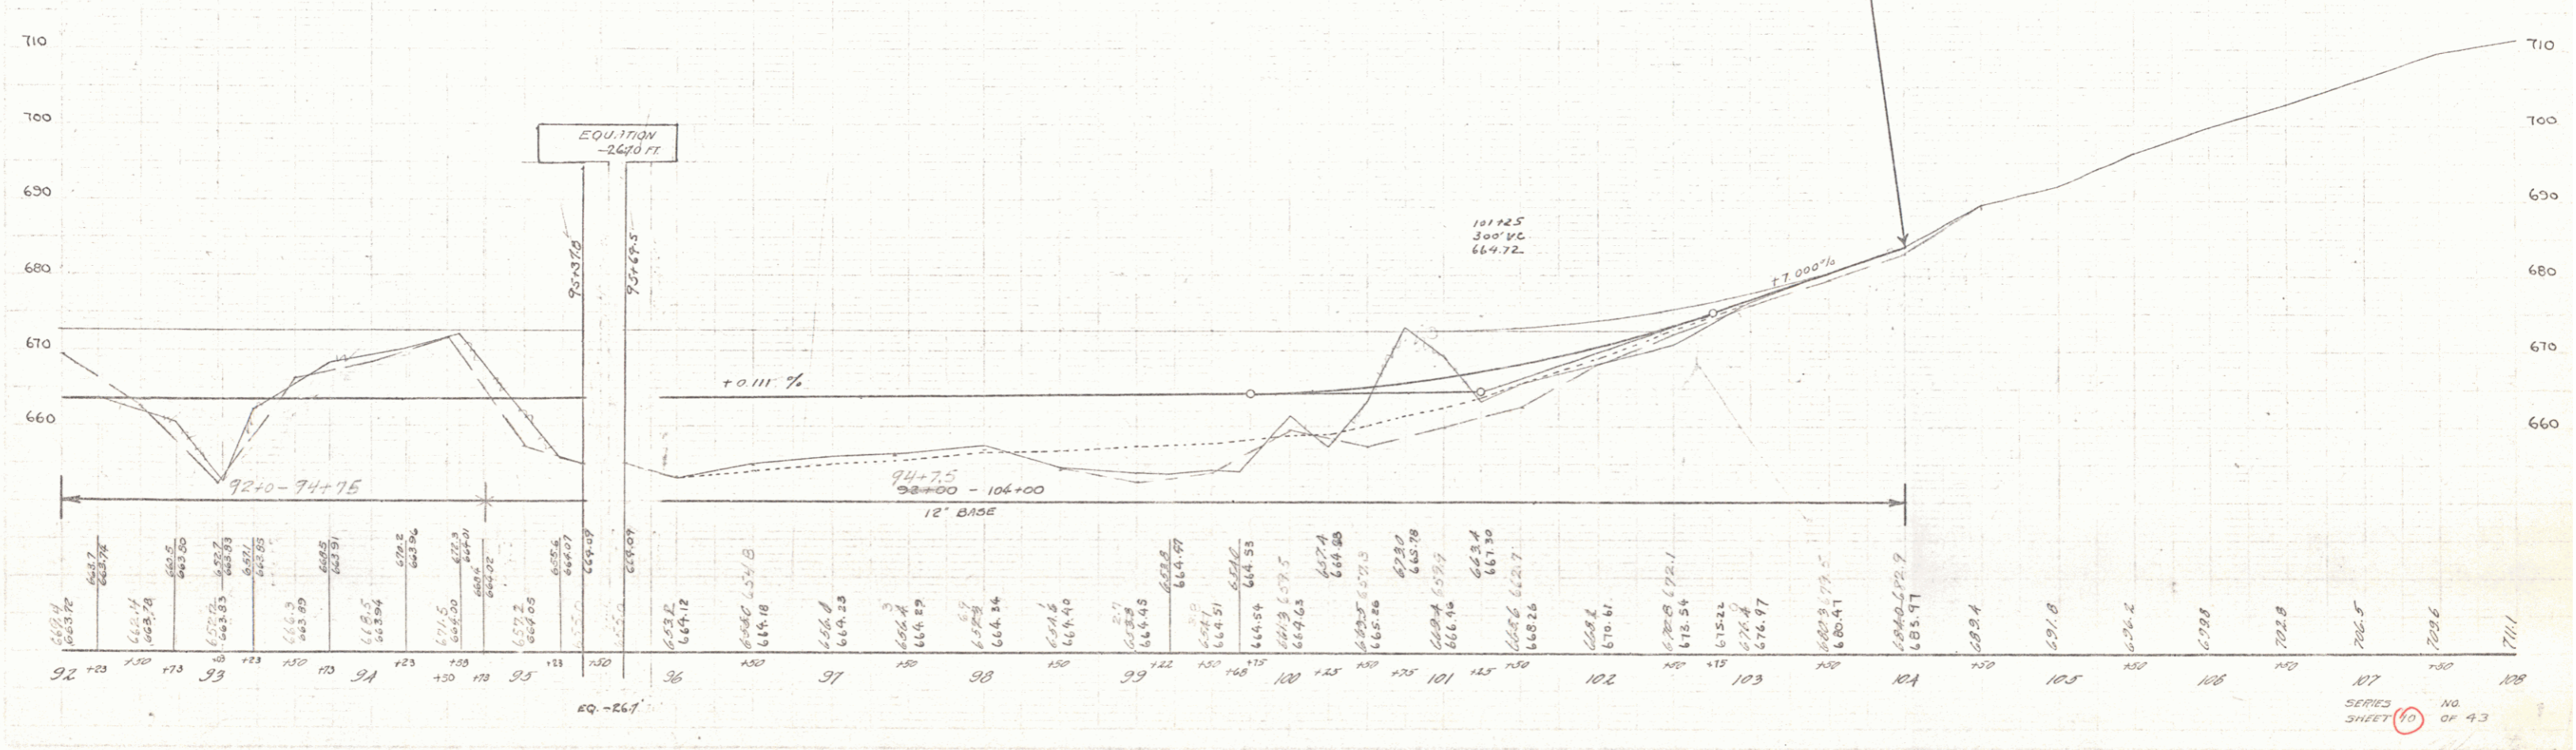

SERIES SHEET 10 OF 43