

INDEX OF SHEETS


1. Title Page
 2. Summary Sheet
- NOTE: For Index Refer to Complete Project

STATE OF VERMONT
DEPARTMENT OF HIGHWAYS



PROPOSED IMPROVEMENT
TOWN OF WORCESTER
COUNTY OF WASHINGTON
VERMONT ROUTE 12

BEGINNING AT A POINT APPROXIMATELY 0.291 MILES
NORTHERLY OF THE MIDDLESEX - WORCESTER TOWN
LINE AND EXTENDING NORTHEASTERLY 0.004 MILES

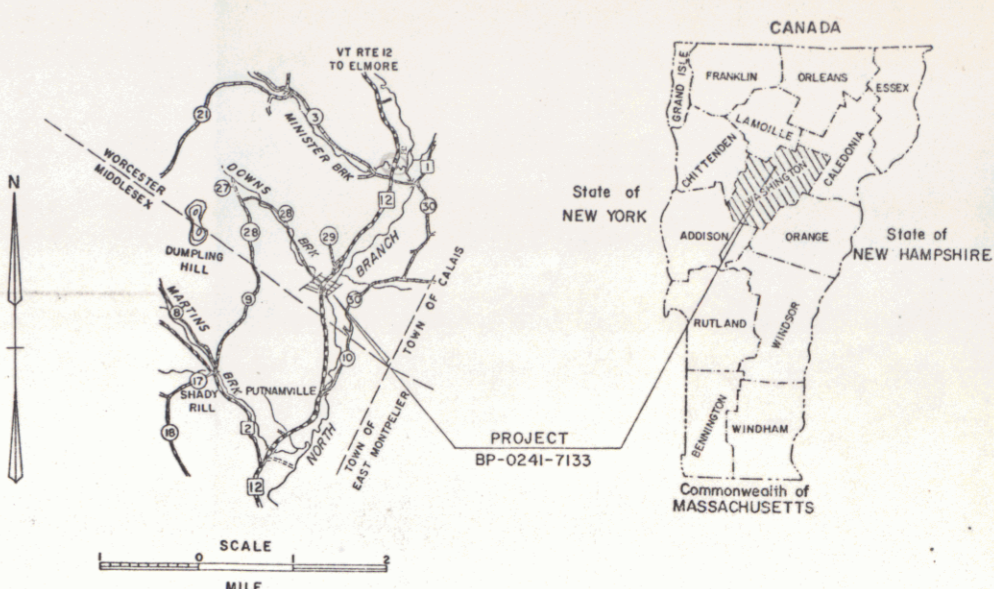

WORCESTER BP 0241-7133
RECORD PLANS
MATERIALS


CONCRETE CLASS B - A.G. ANDERSON CO., INC. - BERLIN, VT.
REINFORCING STEEL - PIONEER VALLEY STEEL CO., INC. - GREENFIELD, MA

CONTRACTOR
BRIDGES, INC. - MONTPELIER, VT.
RES. ENG. - FREDERICK G. GILMAN.
RECORD PLANS - A.G. SFIDLE.

CONTRACT
DATED - SEPTEMBER 21, 1973.
STARTED - JANUARY 31, 1974.
COMPLETED - MAY 24, 1974.
ACCEPTED - MAY 24, 1974.

LENGTH OF BRIDGE 23.06 FEET = 0.004 MILES
LENGTH OF PROJECT 23.06 FEET = 0.004 MILES

1973 ADT = 1130
1973 DHV = 180
1993 ADT = 1795
1993 DHV = 250
V = 40

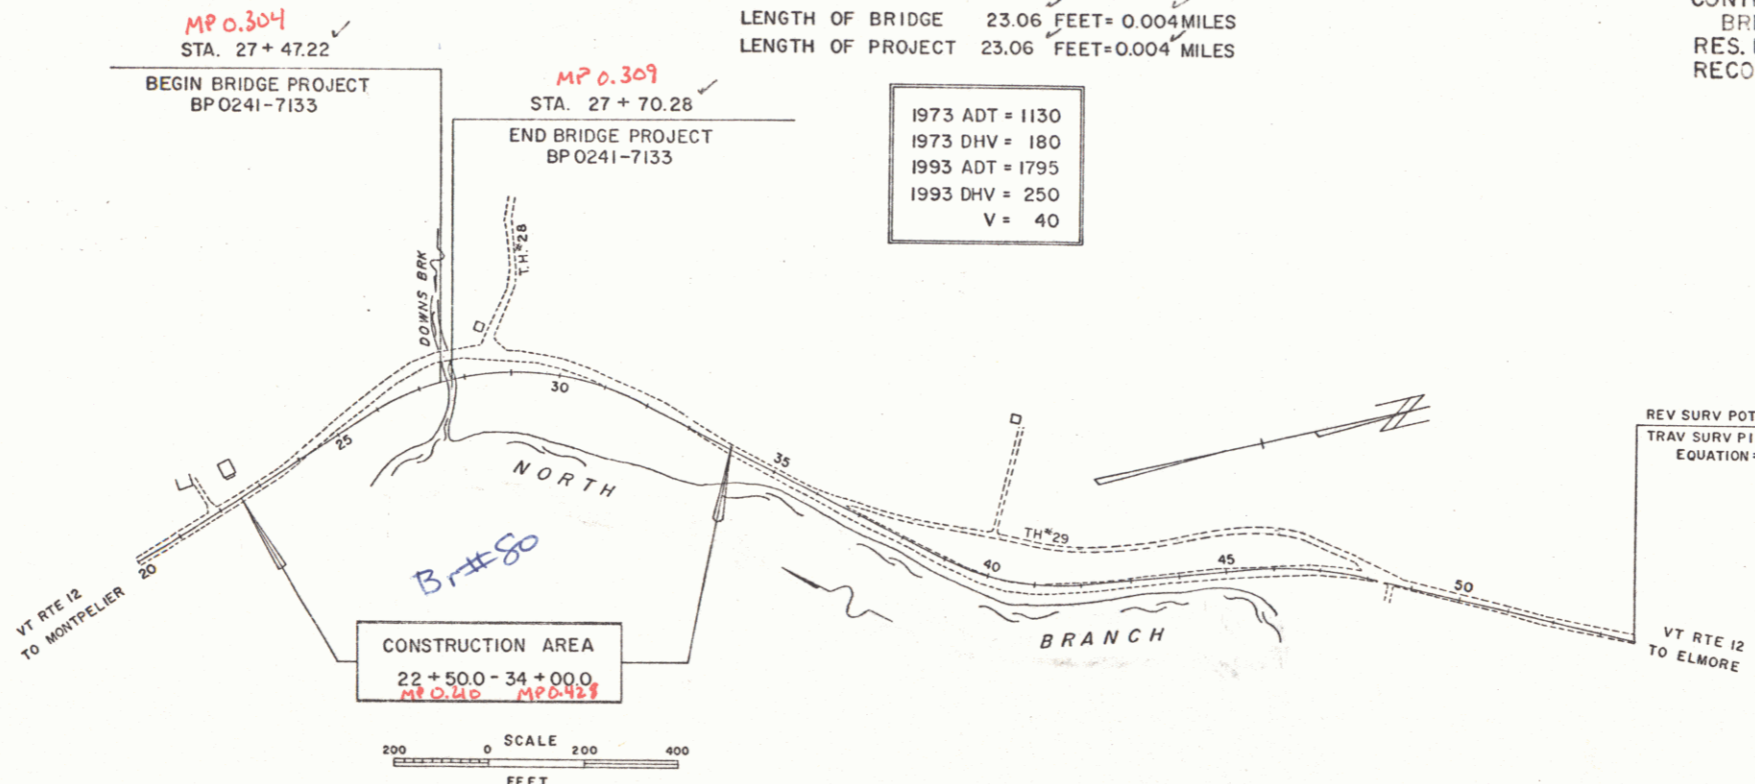

NOTE: ANY FURTHER INFORMATION CONCERNING
FINAL QUANTITIES, AMOUNTS OR OTHER DETAILS
RELATIVE TO THIS PROJECT MAY BE FOUND IN
EITHER THE FIELD BOOKS OR THE ESTIMATE
FILE.

RIGHT-OF-WAY DIVISION
TOWN FILE
PERPETUAL
Town of Worcester
(To Be Returned To R.O.W. Division)
BENCH MARKS BASED ON USGS ELEVATIONS

- CONVENTIONAL SIGNS
- COUNTY LINE
 - TOWN LINE
 - LIMITS OF ACCESS
 - POINT OF ACCESS
 - FENCE LINE
 - STONE WALL
 - TRAVELED WAY
 - GUARD RAIL
 - RAILROAD
 - SURVEY LINE
 - CULVERT
 - POWER POLE
 - TELEPHONE POLE
 - TREES
 - F.A. CONST. IDENTIFICATION SIGNS
 - PROPERTY LINE
 - R.O.W. TAKING LINE
 - SLOPE RIGHTS
 - TOP OF CUT
 - TOE OF SLOPE

WORCESTER BP 0241-7133
CONTRACTOR - BRIDGES, INC.
MONTPELIER, VT.
RES. ENG. - FREDERICK G. GILMAN.
RECORD PLANS - A.G. SFIDLE.
CONSTR. COMPLETED - MAY 24, 1974.

These plans are subject to such engineering
changes as may be required by the Federal Highway
Administration or the Chief Engineer.
Construction is to be carried on in accordance
with these plans and the Standard Specifications
for Highway and Bridge Construction dated
January 3, 1972 as approved by the Federal Highway
Administration on December 28, 1971 for use on
this project, including all subsequent revisions and
such revised specification and special provisions as
are incorporated in these plans.

Pin# 99R977

SUBMITTED BY ORDER OF THE STATE HIGHWAY BOARD

APPROVED: *E.H. O'Leary* DATE: 9/6/73
CHIEF ENGINEER

DEPARTMENT OF TRANSPORTATION
FEDERAL HIGHWAY ADMINISTRATION

APPROVED: _____ DATE: _____
DIVISION ENGINEER

PROJECT BP NR 0241-7133

SHEET 1 OF 2 SHEETS