


PAVED CUTTER
LT
23+03 ~ 25+00 RT

GUARD RAIL, STD. STEEL BEAM
*/ STEEL POSTS TYPE II
LT
26+50 ~ 28+50 RT
25+00 ~ 29+00

EXCAVATION & REMOVAL of
ROAD SURFACES and PAVEMENTS
LT
26+75 ~ 27+50 RT
27+50 ~ 28+35
28+30 ~ 30+00

REMOVAL & DISPOSAL OF
EXISTING GUARD RAIL
LT
26+65 ~ 28+30 RT
26+65 ~ 28+40

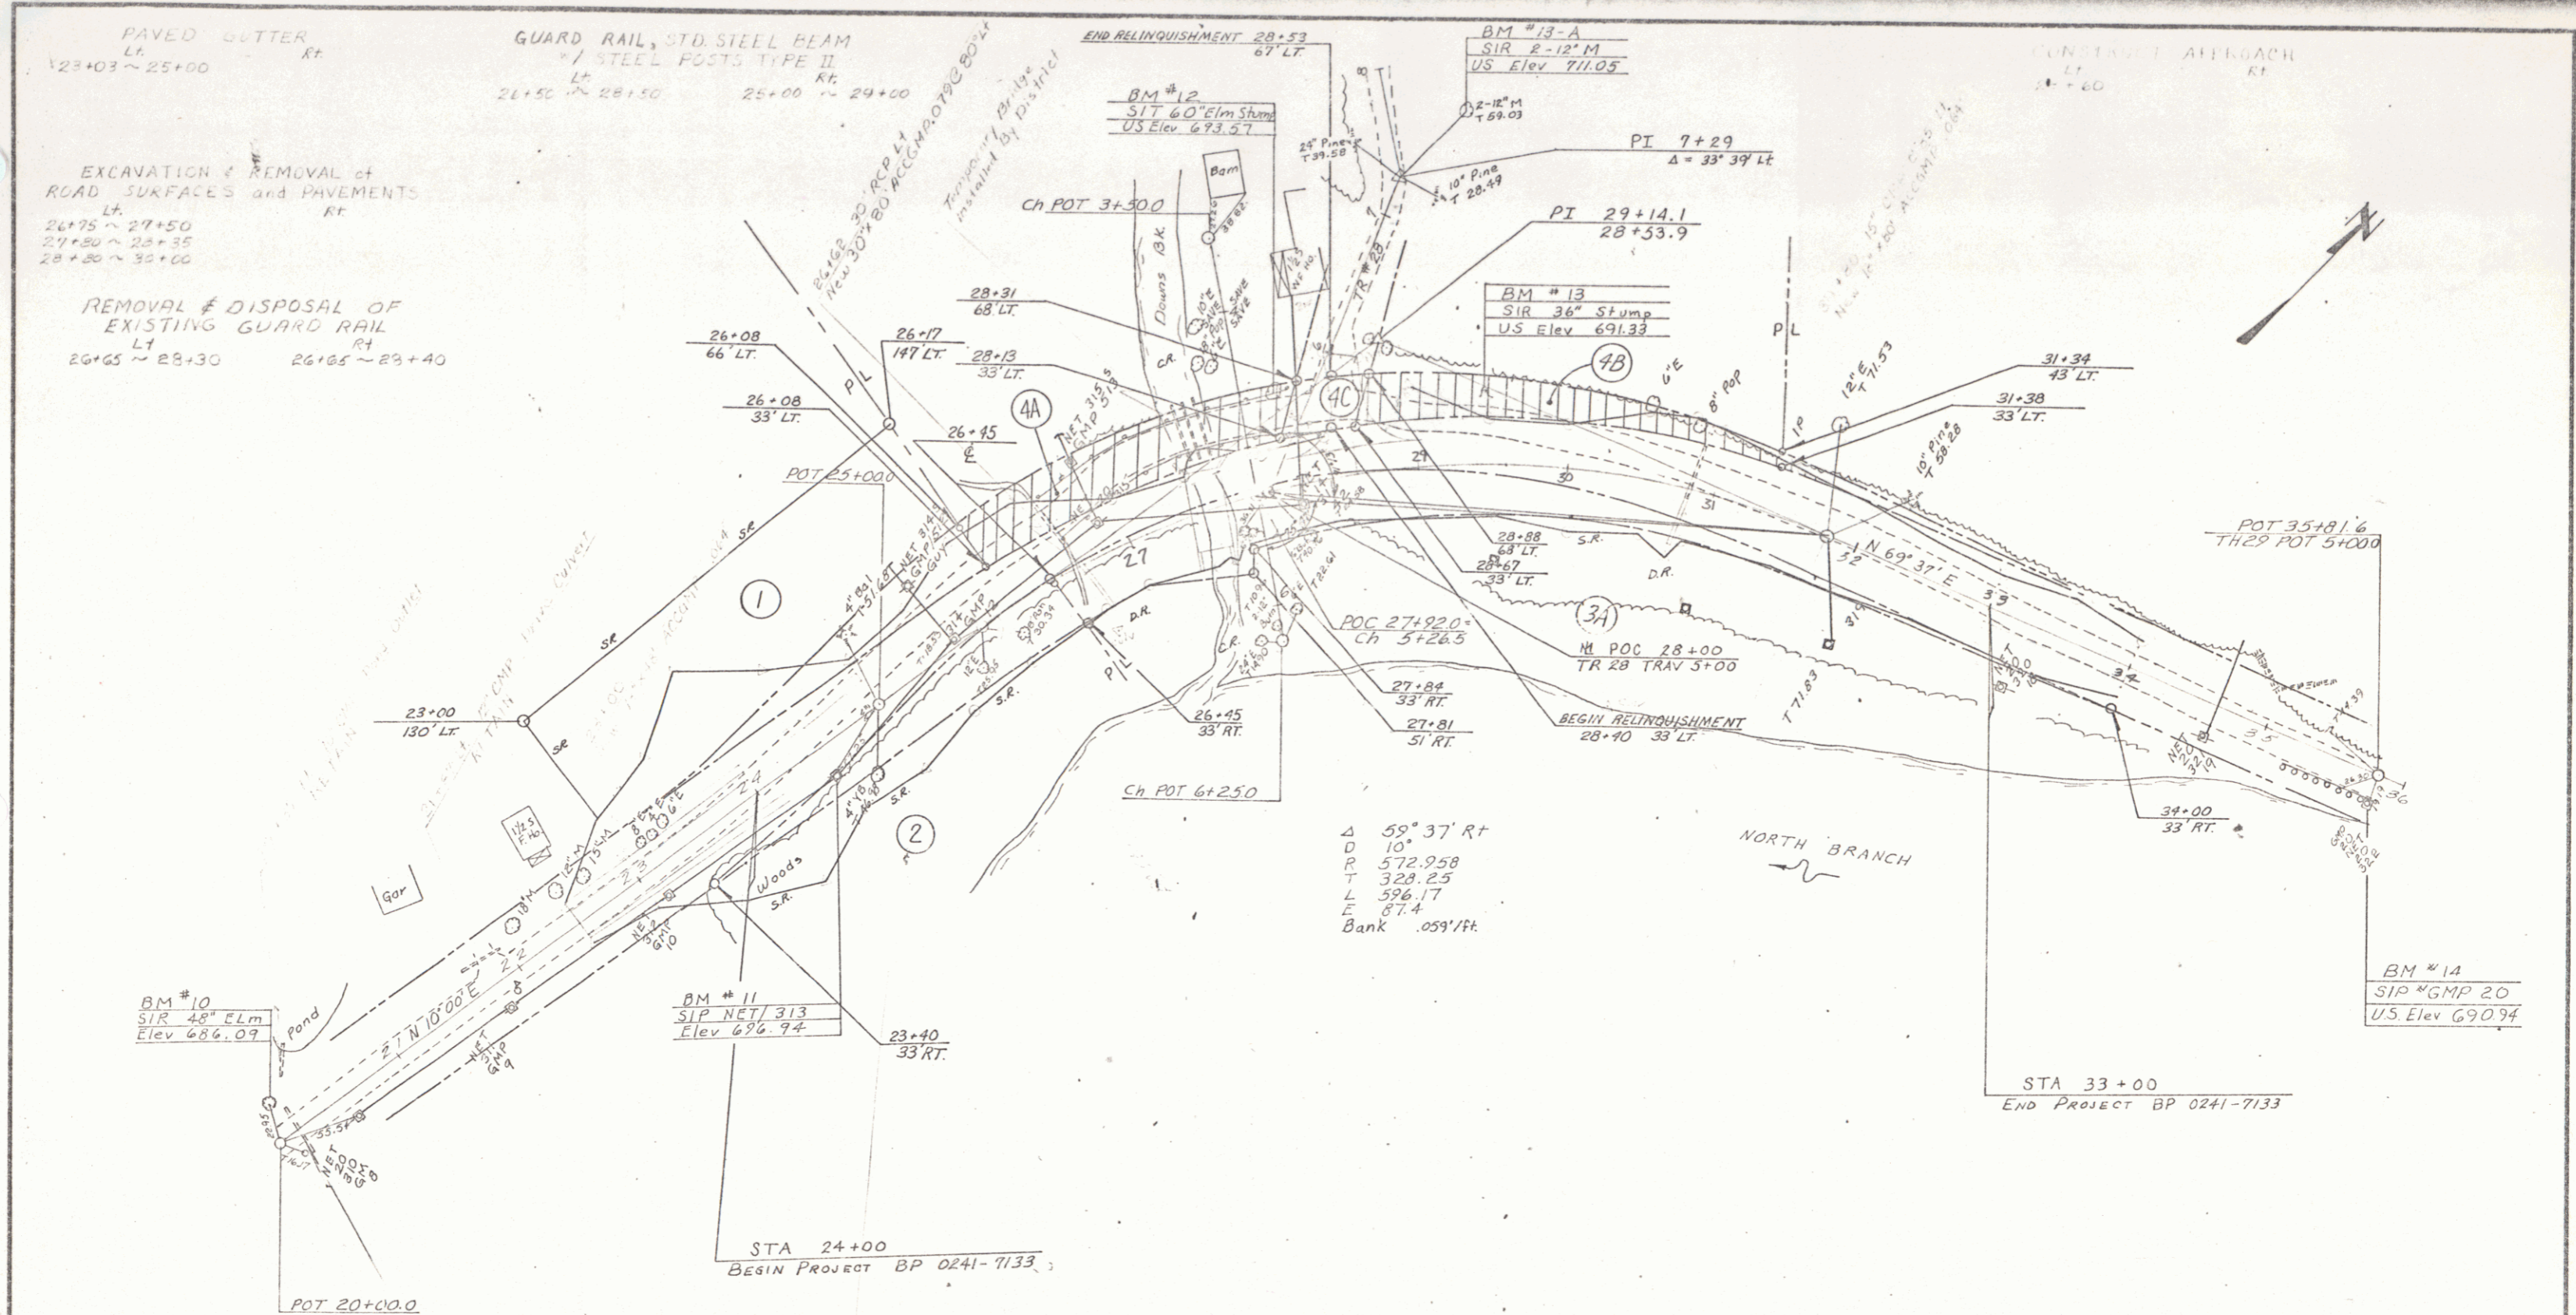

Δ 59° 37' Rt
D 10'
P 572.958
T 328.25
L 596.17
E 87.4
Bank .059'/ft.

SCALE
0 50 100
FEET

SURVEYED BY Stevens DATE June 1973
DRAWN BY Smith DATE June 1973
TRACED BY Hay DATE July 1973
WORCESTER
PROJ. NO. 0241-7133
SHEET 7 OF 46